


PLAN SURVEYED Surveying  
 FILED 2/6/53  
 COUNTY Franklin  
 DRAWN CHAS. D. ENNET  
 NO. 463

DIPRAP FOR BANK PROTECTION  
 MOD FOR CULVERT ENDS, ITEM 526  
 S.B. 3329+51-3329+59 Rt.  
 THREE CABLE GUARD RAIL  
 W/ STEEL POSTS, ITEM 543  
 N.B. 3321+50-3332+00 Lt.  
 S.B. 3325+47-3332+00 Lt.

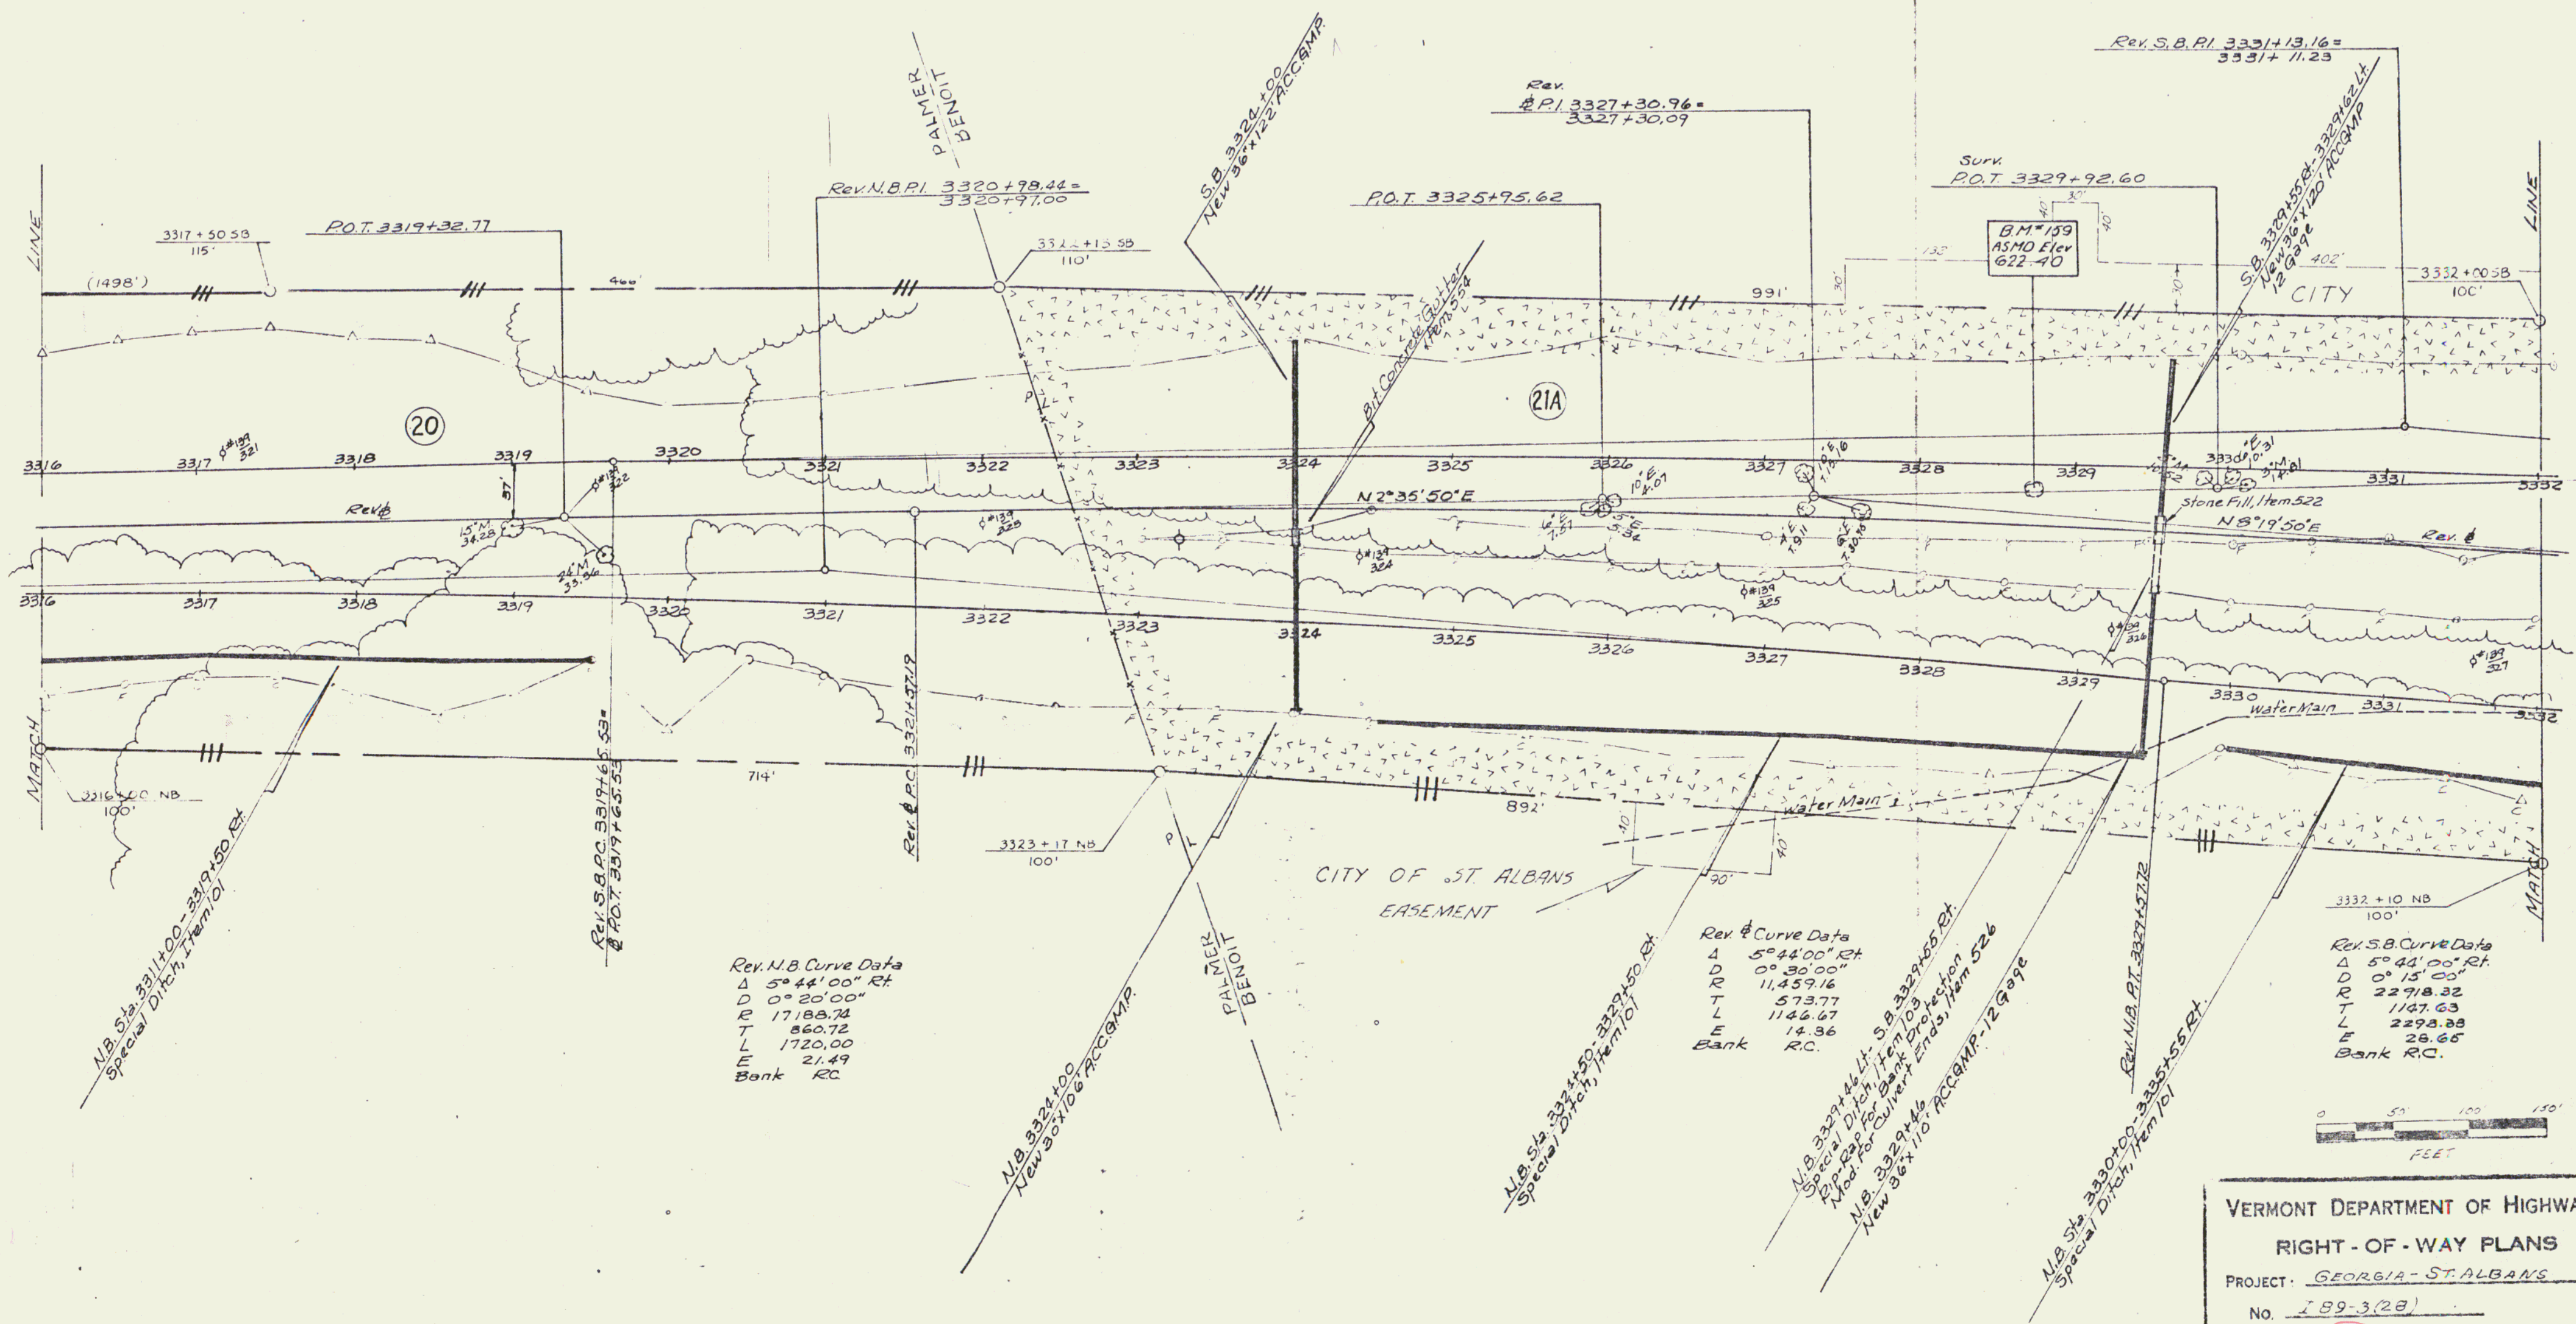

VERMONT DEPARTMENT OF HIGHWAYS  
 RIGHT - OF - WAY PLANS  
 PROJECT: GEORGIA - ST. ALBANS  
 NO. I 89-3(2B)  
 SHEET 34 OF 76