


1. DATE: 11/15/62
 2. COUNTY: FRANKLIN
 3. PROJECT: ST. ALBANS
 4. SHEET: 37
 5. DRAWN BY: J. H. HARRIS
 6. CHECKED BY: J. H. HARRIS
 7. APPROVED BY: J. H. HARRIS

THREE CABLE GUARD RAIL w/
 STEEL POSTS ITEM
 NB 3355+00 LF - 3357+40 LF
 SB 3363+05 LF - 3364+00 LF
 BITUMINOUS CONCRETE CURB
 ITEM

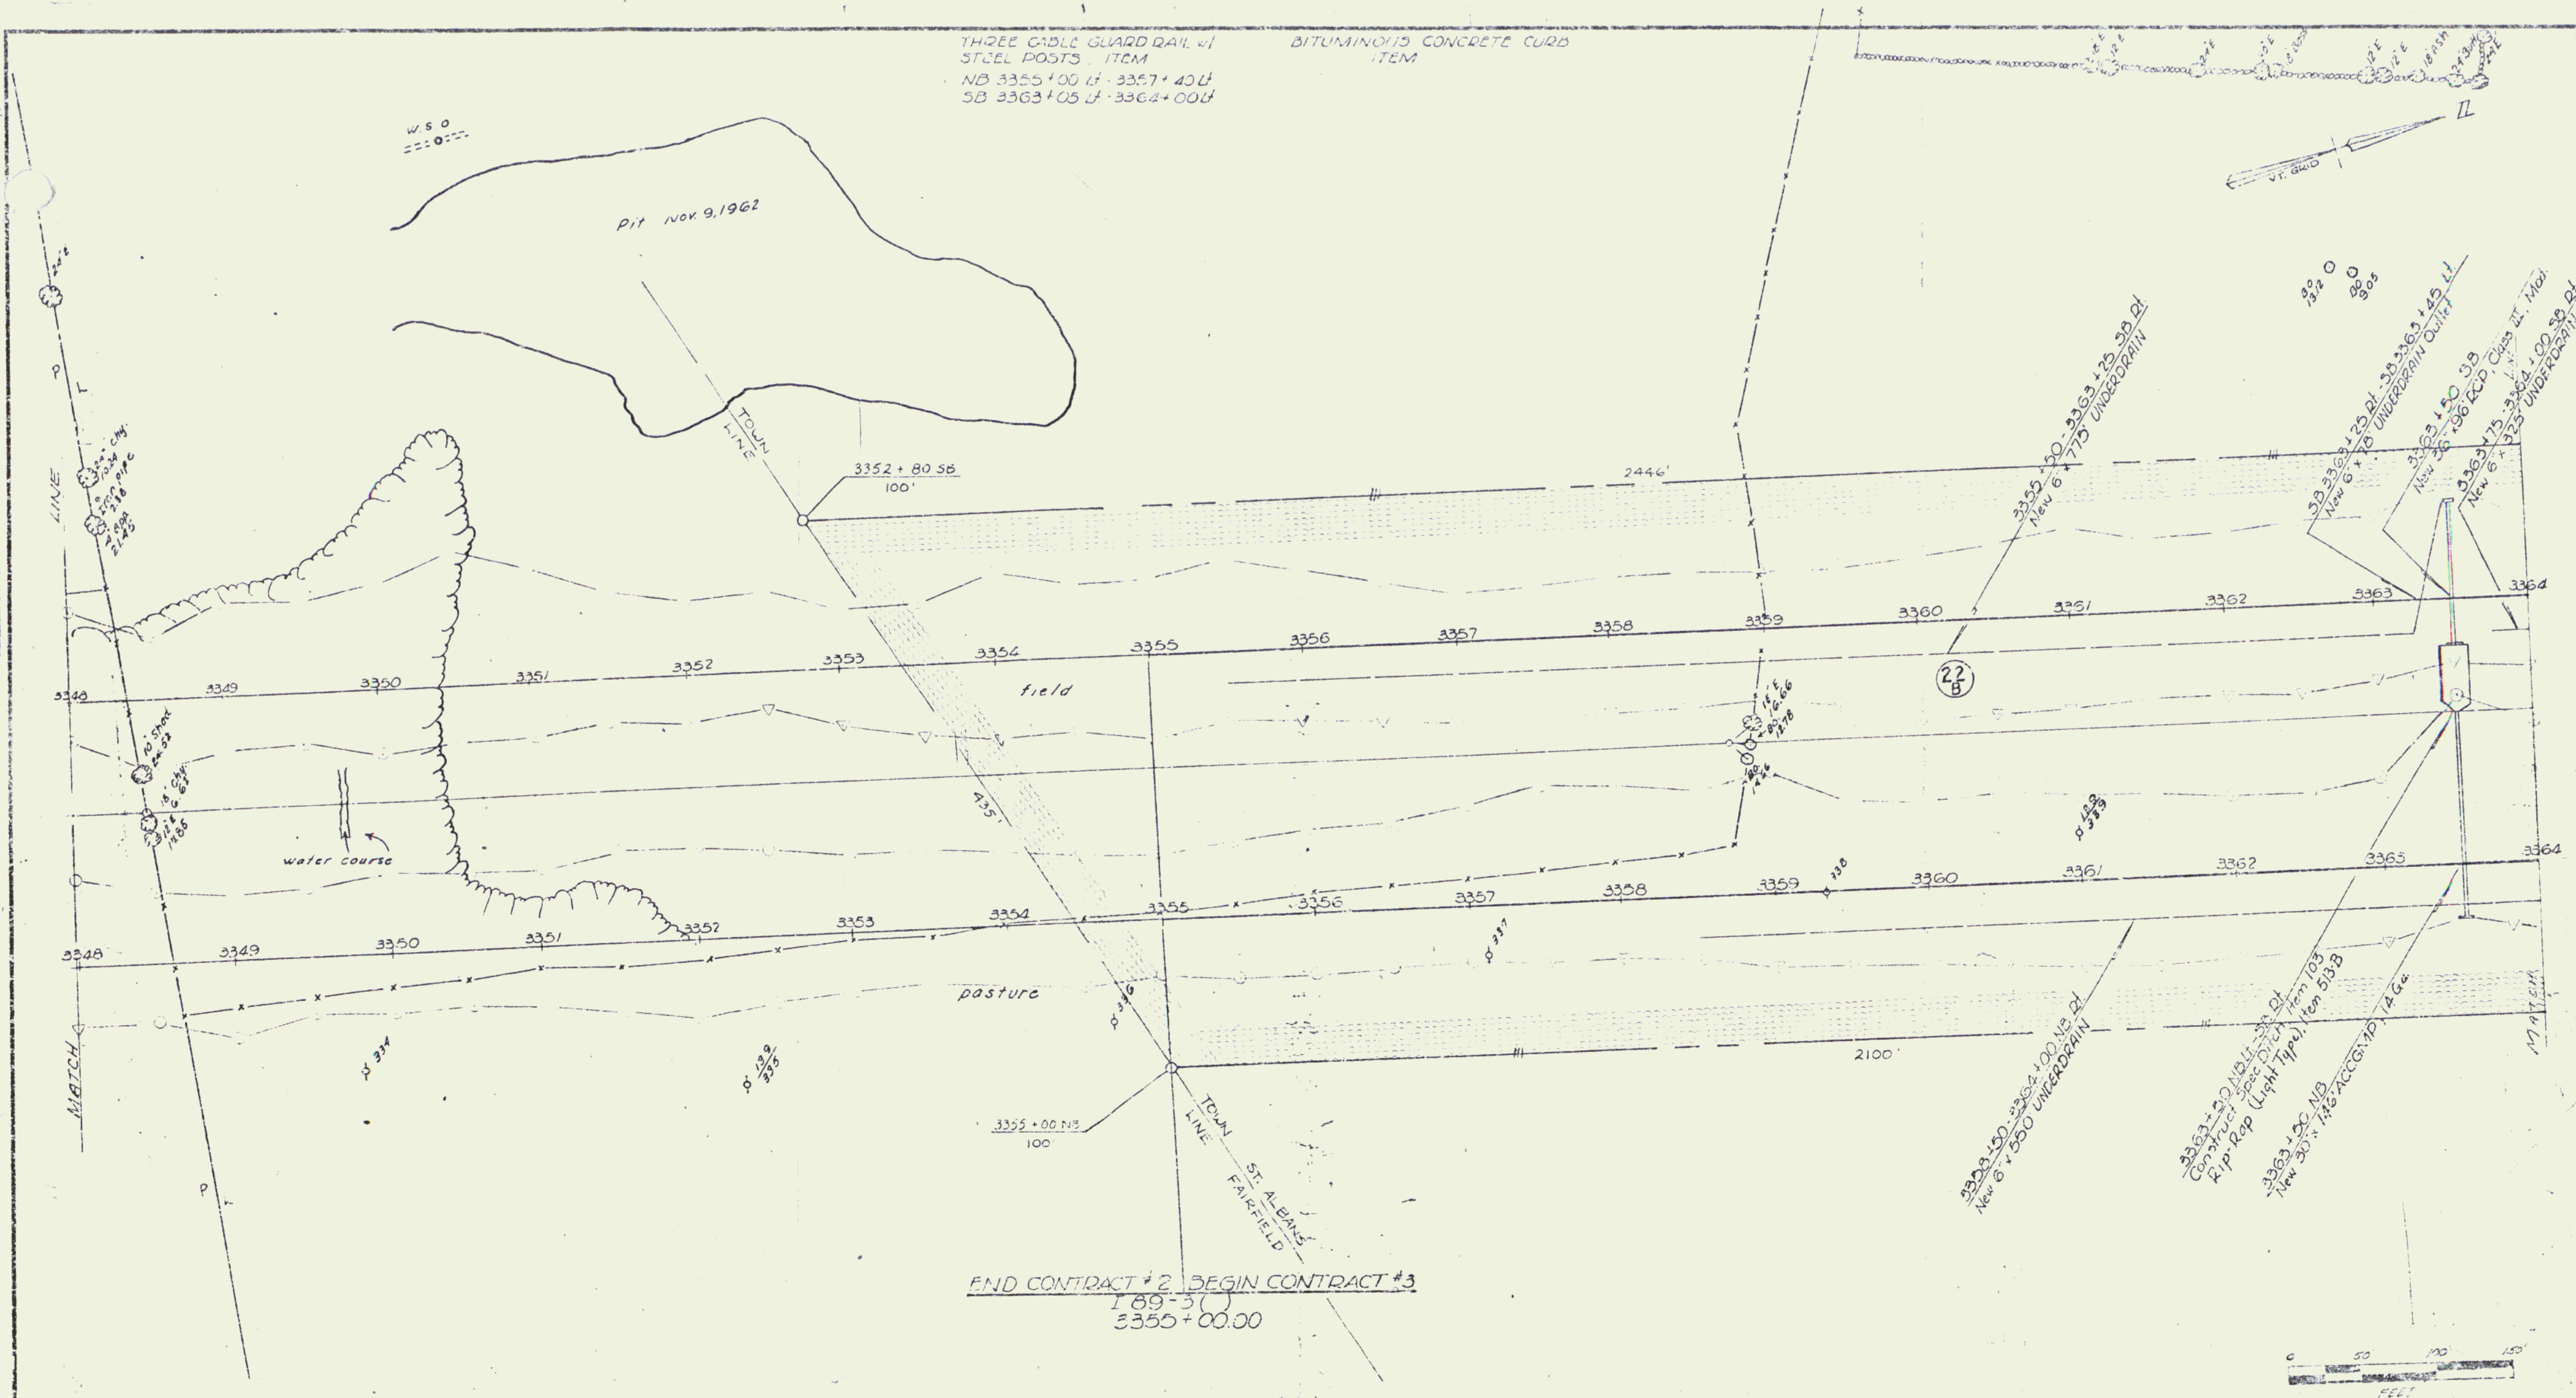

END CONTRACT #2 BEGIN CONTRACT #3
 189-5(1)
 3355+00.00

VERMONT DEPARTMENT OF HIGHWAYS
 RIGHT-OF-WAY PLANS
 PROJECT: ST. ALBANS
 NO. 189-5(1)
 SHEET: 37 OF 76