


Approx. River Channel Line

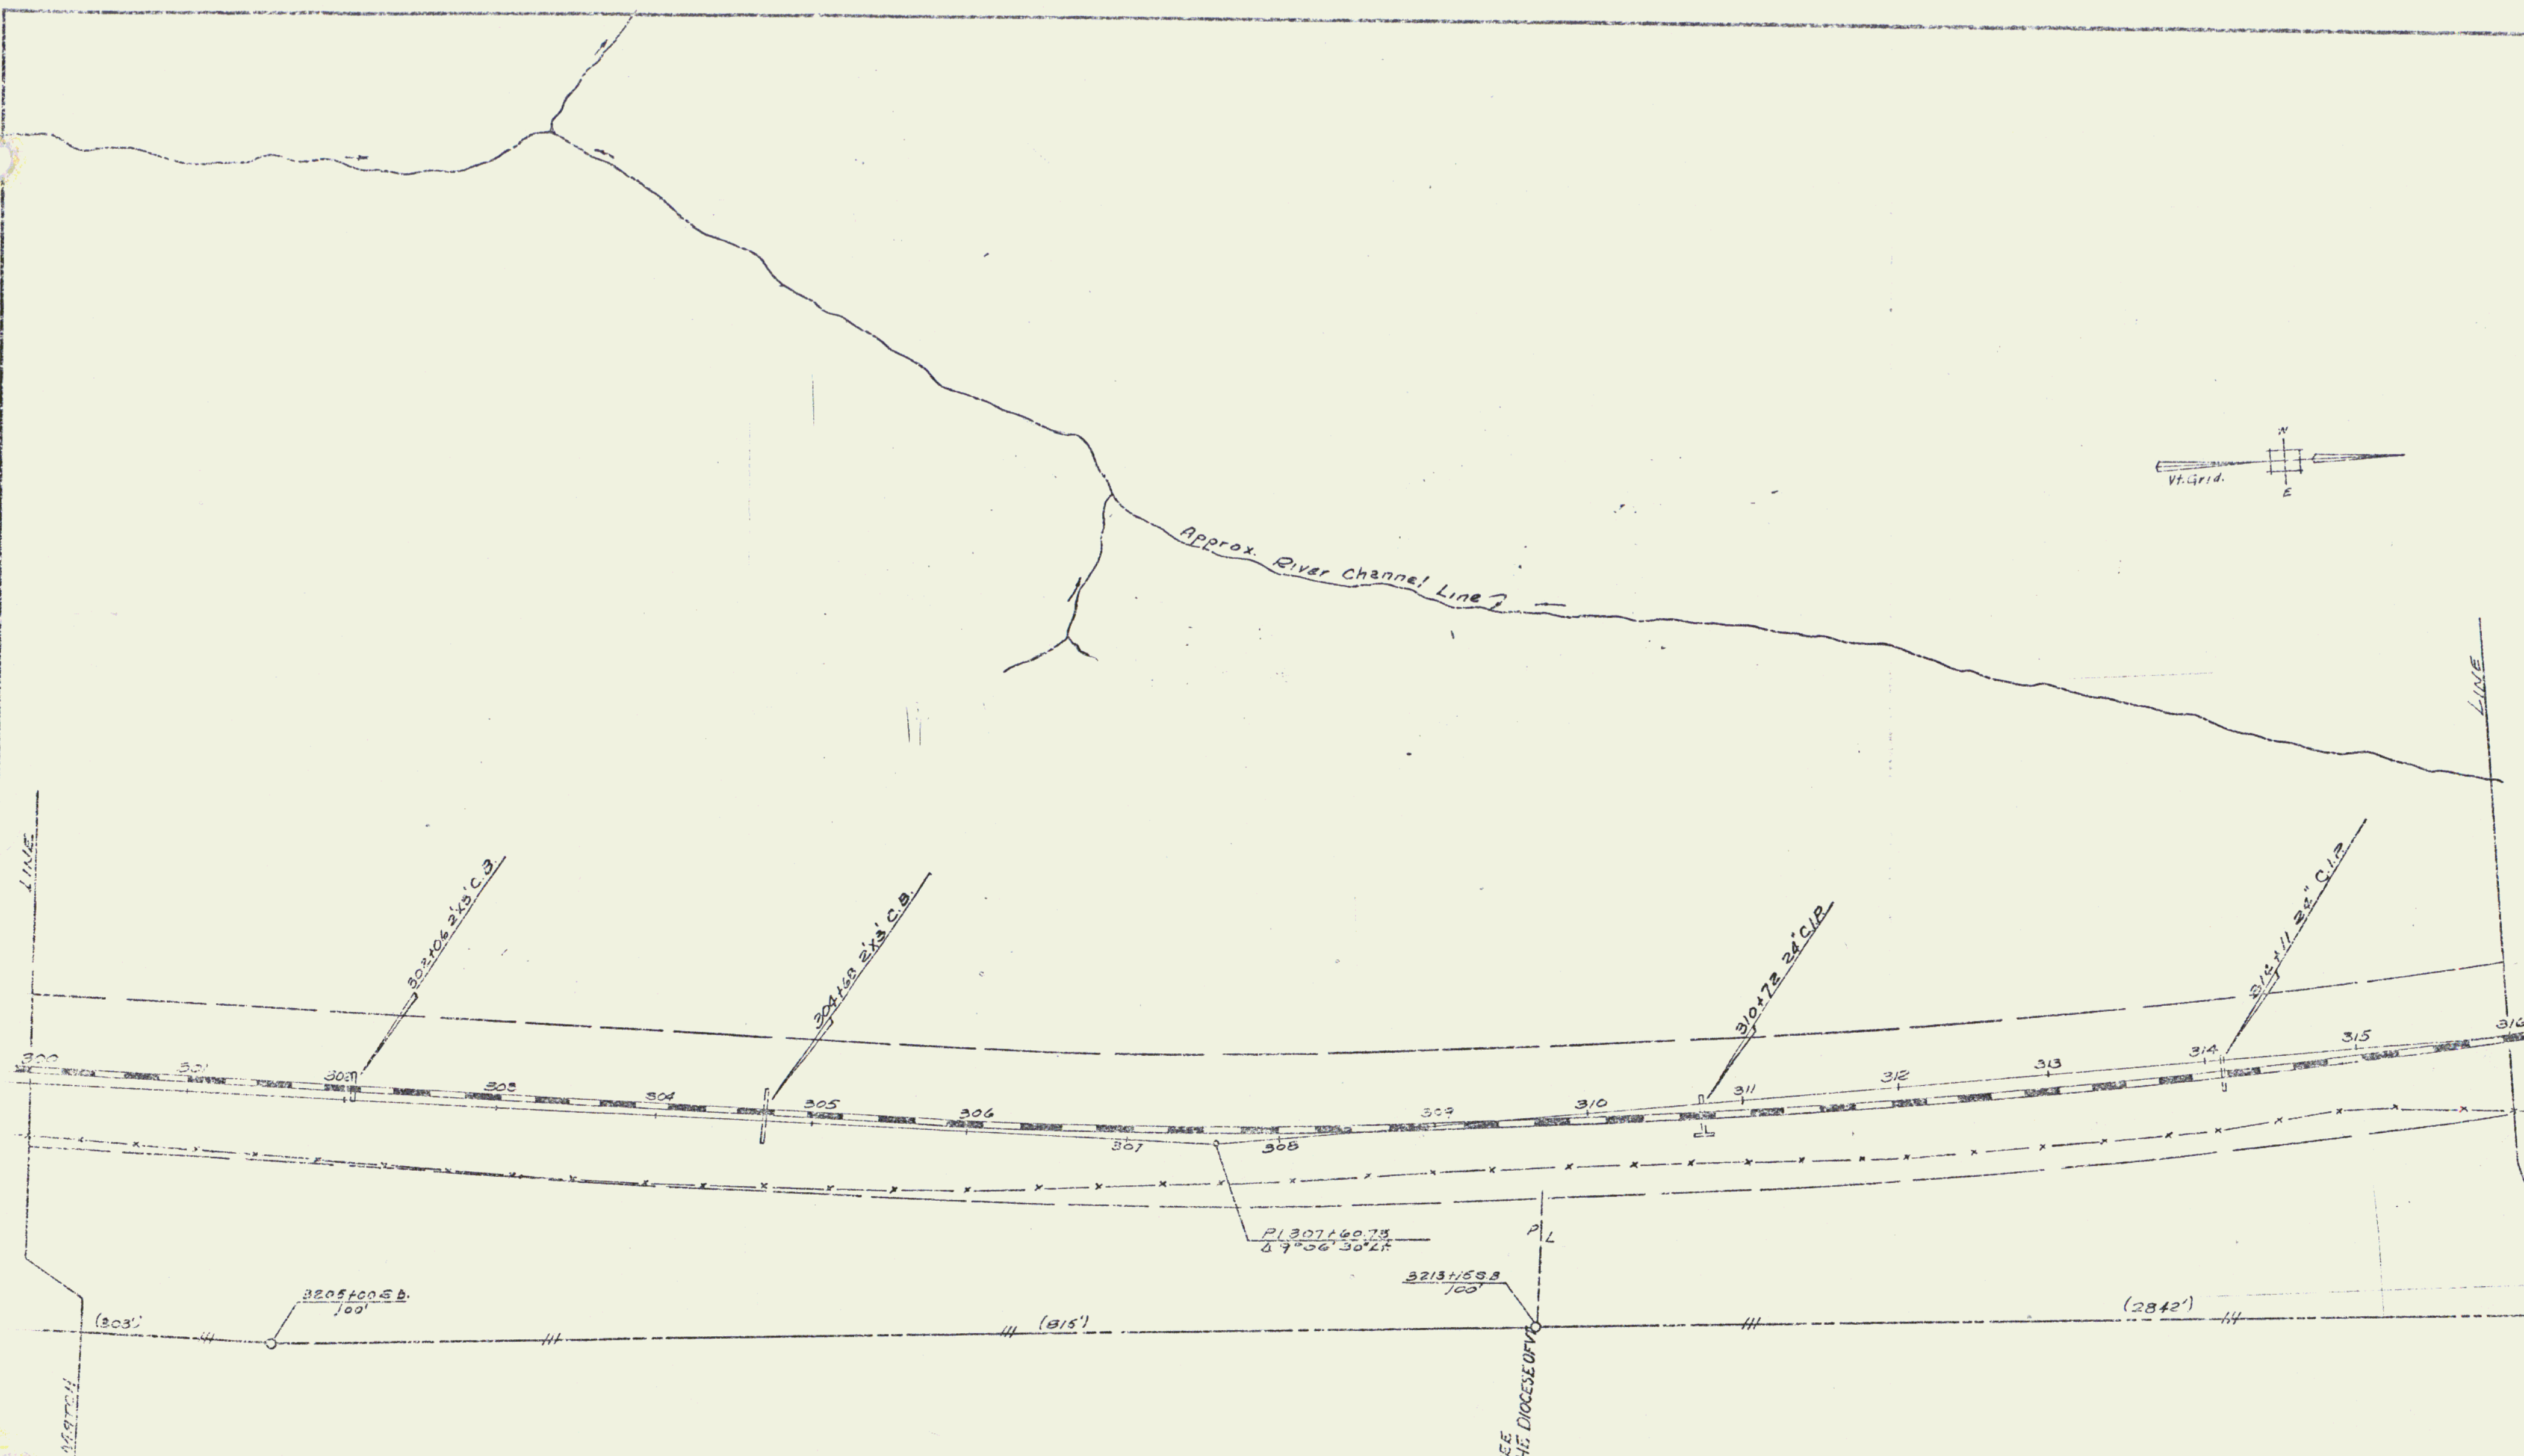

RIGHT-OF-WAY PLANS
DRAWN BY: RLE DATE 12/64
TRACED BY: RLE DATE 02/62
GEORGIA-STALBANS
SHEET 37A OF 76