

BITUMINOUS CONCRETE CURB, ITEM

THREE CABLE GUARD RAIL w/ STEEL POSTS, ITEM

BIT CONG. GUTTER- USING ITEM 554
3411+86 NB-Lt - 3412+15 SB-Rt

NB 3396+00 Lt - NB 3413+00 Lt
SB 3396+00 Lt - Ramp C 15+50 Rt.

PASTURE


To house

to barn

Pipe from Spring to farm house

B.M. 169
ASMD Elev
549.33

DATE: 11/11/13
SCALE: 1" = 40'
DRAWN: J. B. [unclear]

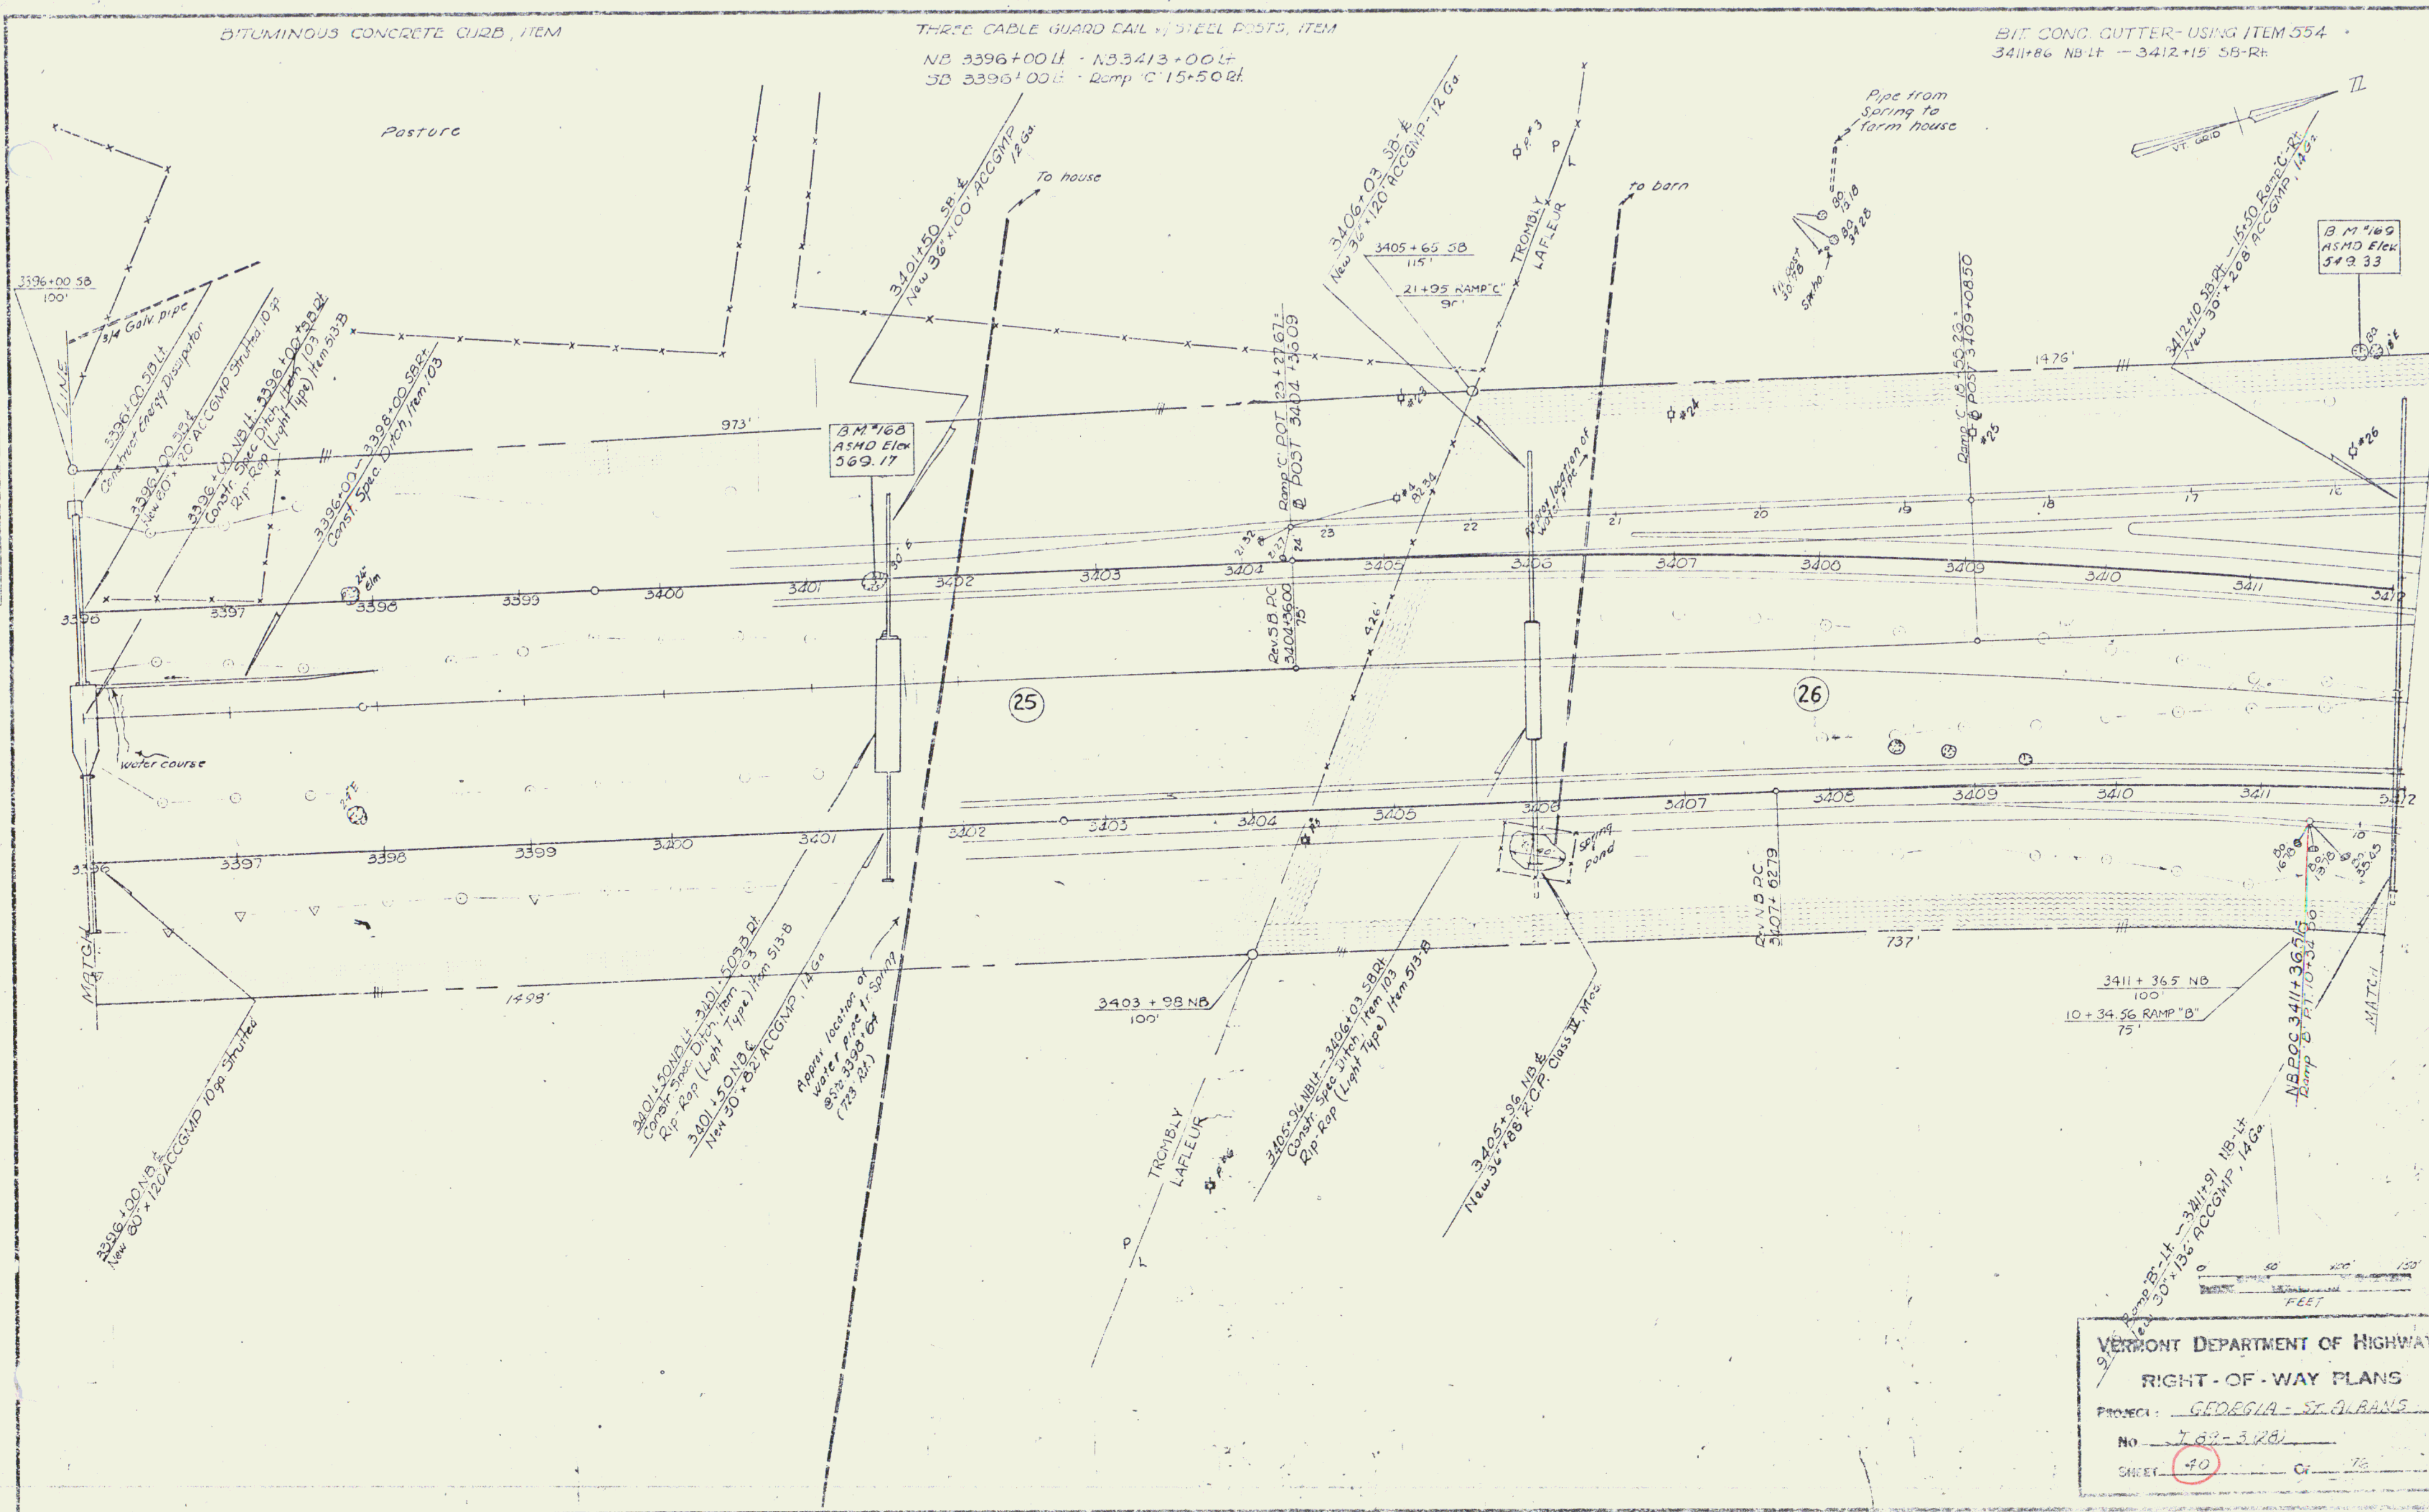

VERMONT DEPARTMENT OF HIGHWAYS
 RIGHT-OF-WAY PLANS
 PROJECT: GEORGIA - ST. ALBANS
 No. 7.62-3.28
 SHEET 40 of 72