

INDIVIDUAL WATER SOURCES
 NAT. SPRING BL 3103+70 - 20' ± LT

* THREE CABLE GUARD RAIL w/
 STEEL POSTS ITEM 542
 SB 3095+89 - 3098+89 Rt
 SB 3095+89 - 3104+65 Lt

DRILLING & BLASTING OF SOLID
 ROCK SUB GRADE ITEM 115
 NB 3100+00 - 3109+00
 SB 3104+50 - 3109+00

* JUTE MATTING ITEM 023
 NB 3098+25 - 3102+75 Lt

TREATED TIMBER CURB, ITEM 550, Mod.
 SB 3097+00 - 3097+21 Lt

DRILLING & BLASTING OF
 SOLID ROCK ITEM 114
 SB 3100+60 - 3105+60 Rt
 NB 3100+50 - 3103+00
 SB 3103+52 - 3103+99

DRILLING & PRESPLITTING OF
 SOLID ROCK - ITEM 125
 NB 3104+25 - 3104+70
 NB 3105+25 - 3109+00
 SB 3105+25 - 3109+00

PROPERTY LINE FENCE w/
 STEEL POSTS MOD. ITEM 503-II
 SB 3100+00 - 3105+50 Lt


BRIDGE RAILING, ITEM 572
 NB 3092+00 - 3097+12 Lt & Rt
 SB 3096+92 - 3099+19 Lt & Rt

STANDARD STEEL BEAM GUARD
 RAIL, ITEM 545-A
 SBB-NBLT. 3095+95 - 3096+89

NOTE: * DENOTES ITEMS TO BE INCLUDED IN
 STAGE II CONSTRUCTION.

CONTROL OF ACCESS IS COMPLETE ON THIS SHEET.

| | | |
|-----------|-----------|----------|
| DATE | BY | SCALE |
| 11/17/77 | W. J. ... | AS SHOWN |
| APPROVED | CHECKED | DATE |
| W. J. ... | ... | ... |
| NO. ... | ... | ... |

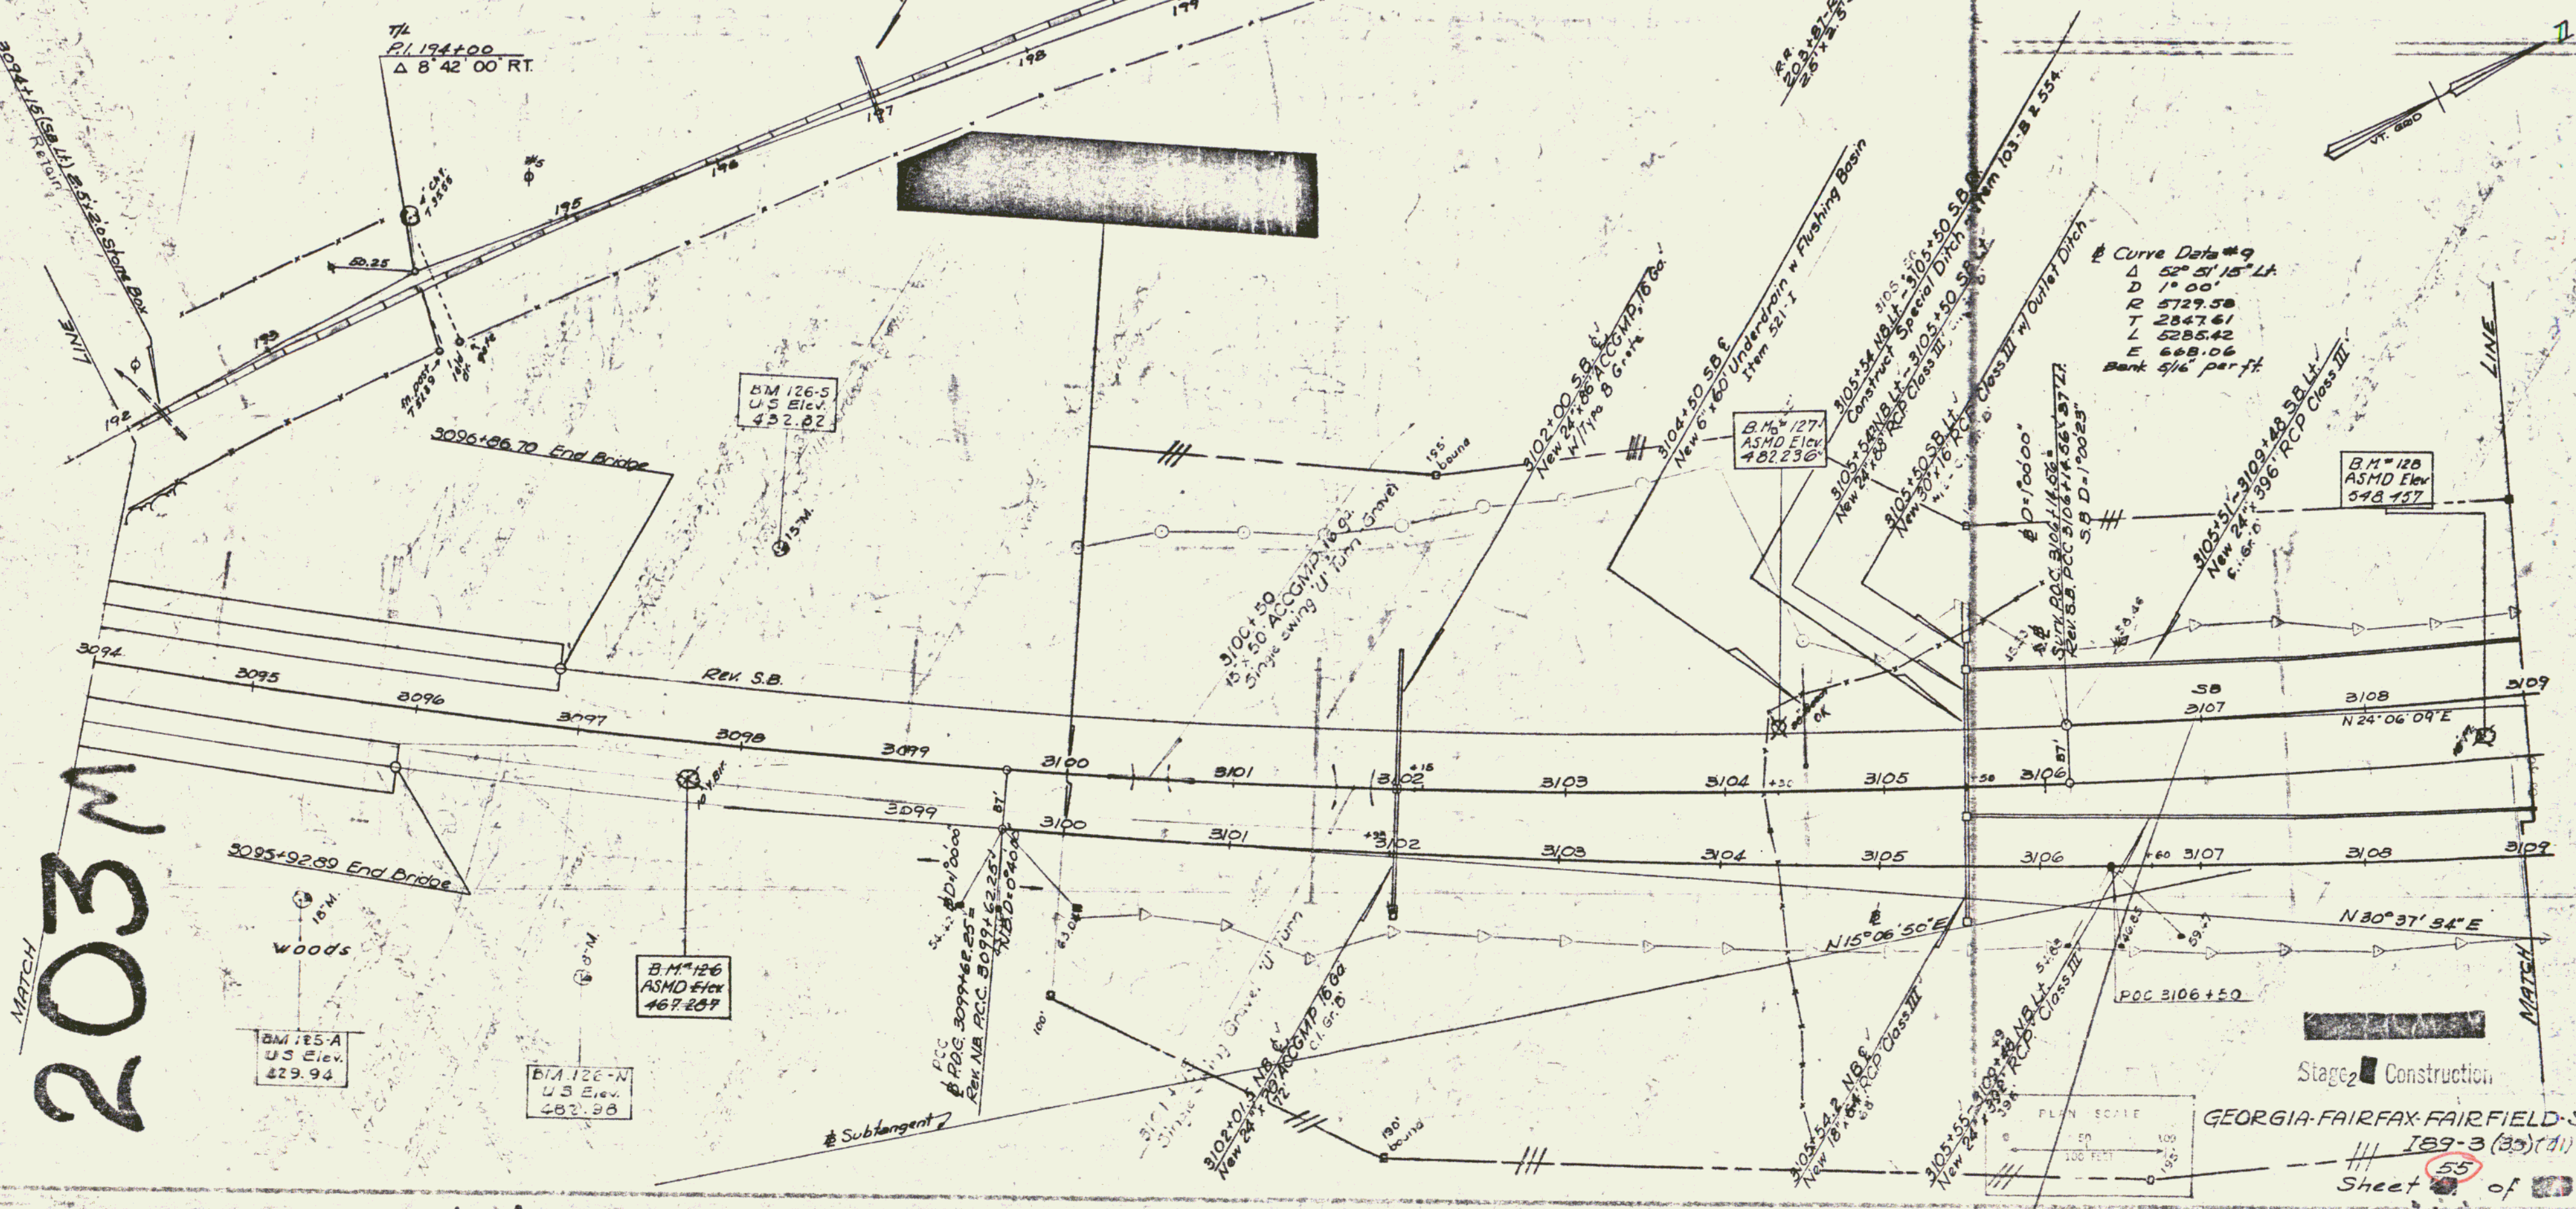

Curve Data #9
 Δ 52° 51' 15" Lt
 D 1" 00'
 R 5727.58
 T 2847.61
 L 5285.42
 E 648.06
 Bank 3/4" per ft.

MATCH
 203M

Stage 2 Construction
 GEORGIA FAIRFAX FAIRFIELD ST. ALBANS
 189-3 (30) (11)
 Sheet 55 of 113