

INDIVIDUAL WATER SOURCES
 NAT. SPRING S.B.L. 3118+10 - 555' LT
 DUG SPRING N.B.L. 3122+85 - 300' RT

DRILLING AND PRESPLITTING
 OF SOLID ROCK, ITEM 125
 NB 3109+00 - 3112+00
 SB 3109+00 - 3112+00


*THREE-CABLE GUARD RAIL w/
 LIGHT STEEL POSTS, ITEM 538
 NB 3118+20 - 3125+00 RT

DRILLING & DIASTING OF SOLID
 ROCK SUBGRADE, ITEM 115
 NB 3109+00 - 3120+50
 SB 3109+00 - 3116+50
 SB 3124+50 - 3125+00
 SB 3118+50 - 3119+25
 SB 3124+84 - 3125+00



PROPERTY LINE FENCE w/
 STEEL POSTS, MOD. ITEM 503-II
 NB: S.B. 3117+00 - 3125+00 LT.

NOTE: * DENOTES ITEMS TO BE INCLUDED
 IN STAGE II CONSTRUCTION.

DATE	2/85
BY	SP/CL
PLANNED	SP/CL
DESIGNED	SP/CL
CHECKED	SP/CL
NOTED	SP/CL
TRACED	SP/CL

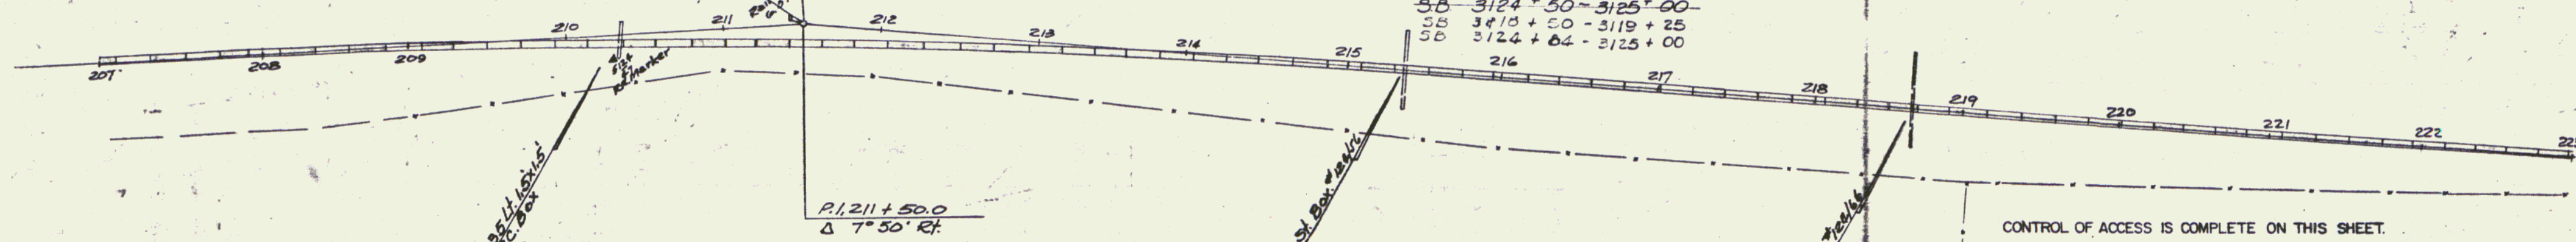

CONTROL OF ACCESS IS COMPLETE ON THIS SHEET.

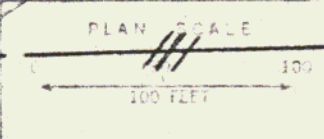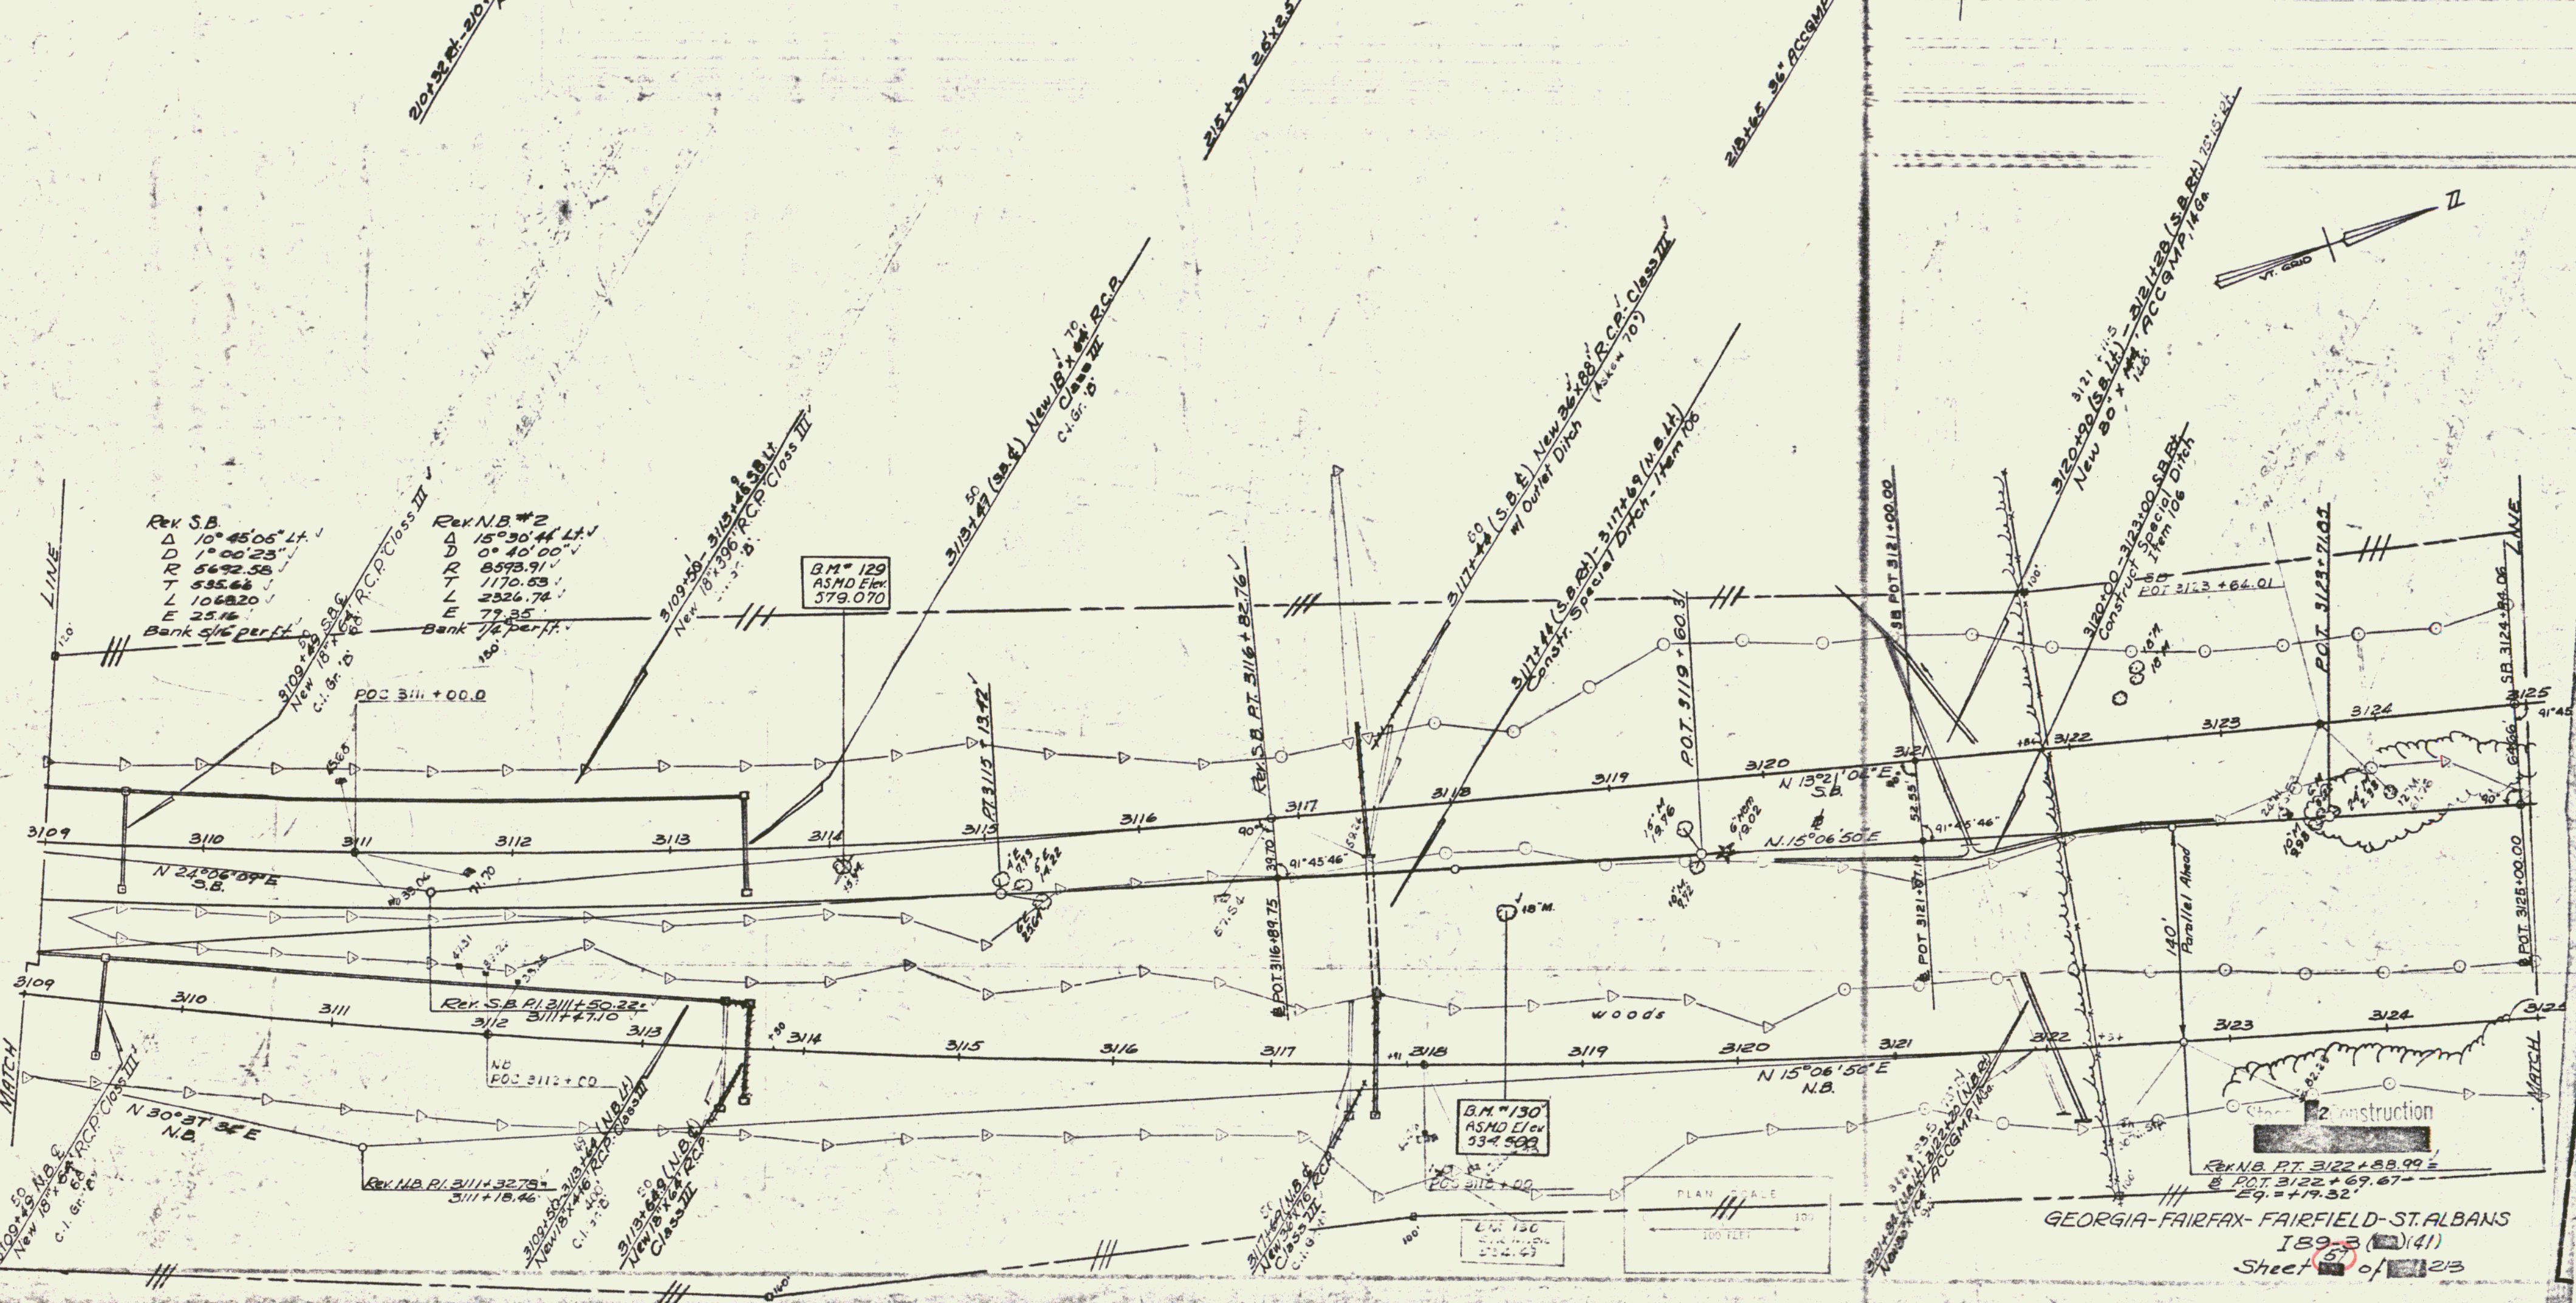

GEORGIA-FAIRFAX-FAIRFIELD-ST. ALBANS
 189-3 (141)
 Sheet 57 of 23