


CONTROL OF ACCESS IS COMPLETE ON THIS SHEET.

*CEDAR LOG GUARD RAIL ITEM 546
 4+88-9+90 Lt. (Rest Area).
 4+80-9+30 Rt. ()

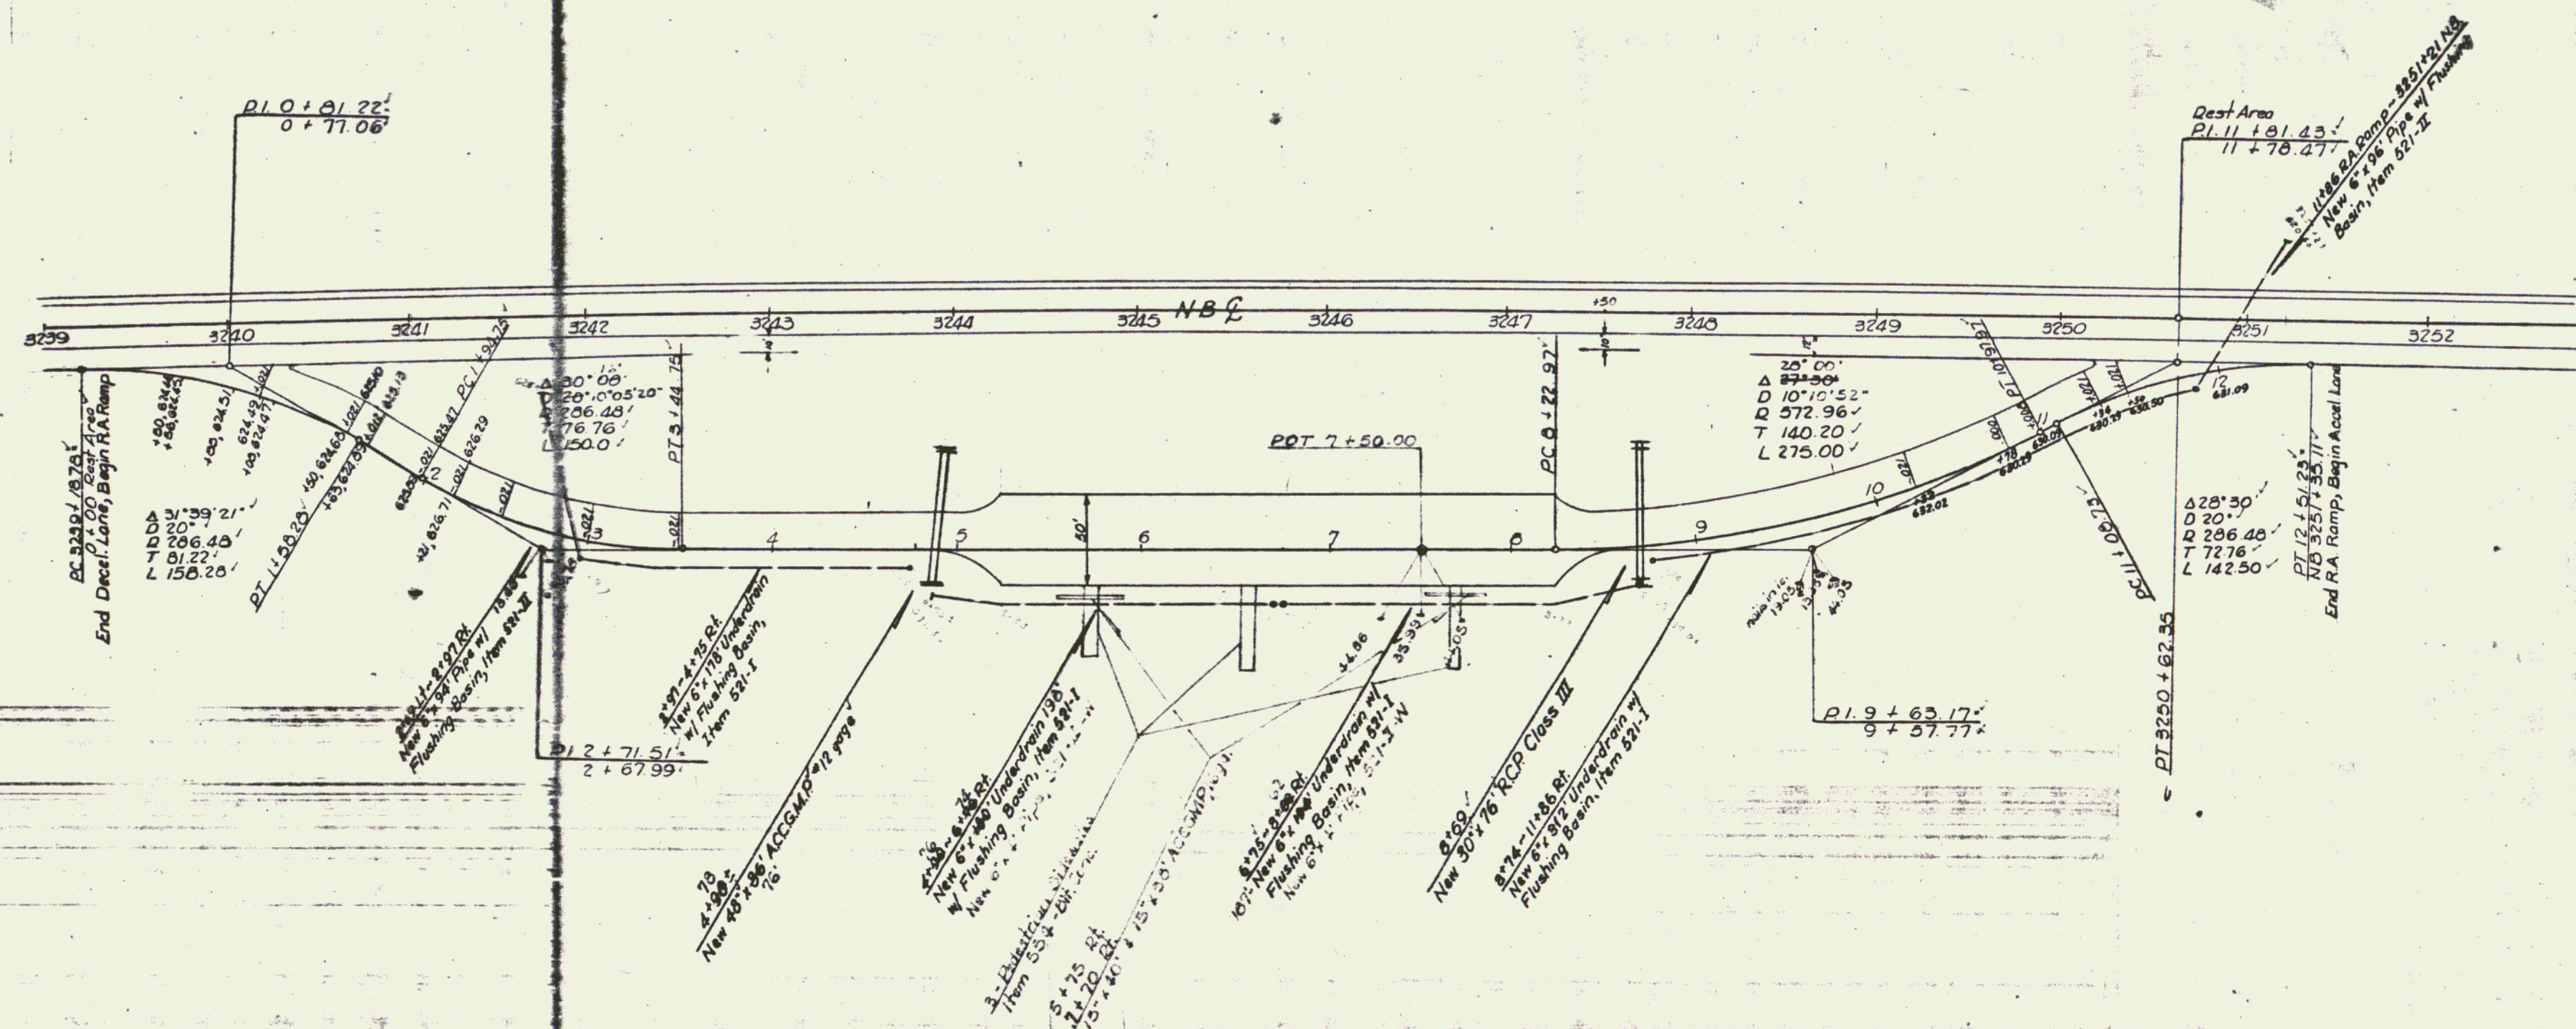

NORTH BOUND
 REST AREA

GEORGIA - FAIRFAX -
 FAIRFIELD - ST ALBANS

NOTE: * Indicates items to be included
 in Stage II construction.

SURVEYED BY	A	DATE	
DRAWN BY	Miller	DATE	1/62
TRACED BY	W	DATE	1/62
PROJ. NO.	72	NO.	89-1 (41)
SHEET	213	OF	213