

\* Three Cable Guard Rail w/ Light Steel Posts, Item 538

5+52 - 7+00 (Ramp "C"-Rt)  
10+00 - 11+00 (Ramp "D"-Rt)

\* Bituminous Concrete Curb - Item 555, TYPE II - TREATED TIMBER CURB, ITEM 520  
10+00 - 11+00 (Ramp "D"-Rt)

\* Slope Edging

16+00 - 23+00 (Approach E - Lt & Rt)

\* Asph. Ctd. Corr. Gal. Metal Retainer

11+00 Ramp "D"  
7+00 Ramp "C"

\* Standard Steel Beam Guard Rail w/ Steel Posts, Item 543-A (6'3" c/c)

Ramp C  
0+58 - 2+10 Rt  
Island  
13+50 - 20+04 Rt  
13+96 - 20+50 Lt

\* Bituminous Concrete Surface for Gutters and Traffic Islands, Item 534 Mod  
21+50 - 23+00 Island



\* Seeding, 611 Island  
Fertilizer, 615  
Topsoil, 621  
16+00 - 21+50

\* Install Overhead Traffic Sign Support  
ITEM 703  
Sta 19+50 Appr.


INDIVIDUAL WATER SOURCES  
DUG WELL APPROX 21+10 - 270' LT

NOTE: \* DENOTES ITEMS TO BE INCLUDED IN STAGE II CONSTRUCTION.

CONTROL OF ACCESS IS COMPLETE ON THIS SHEET, EXCEPT AT STA. 23+00.

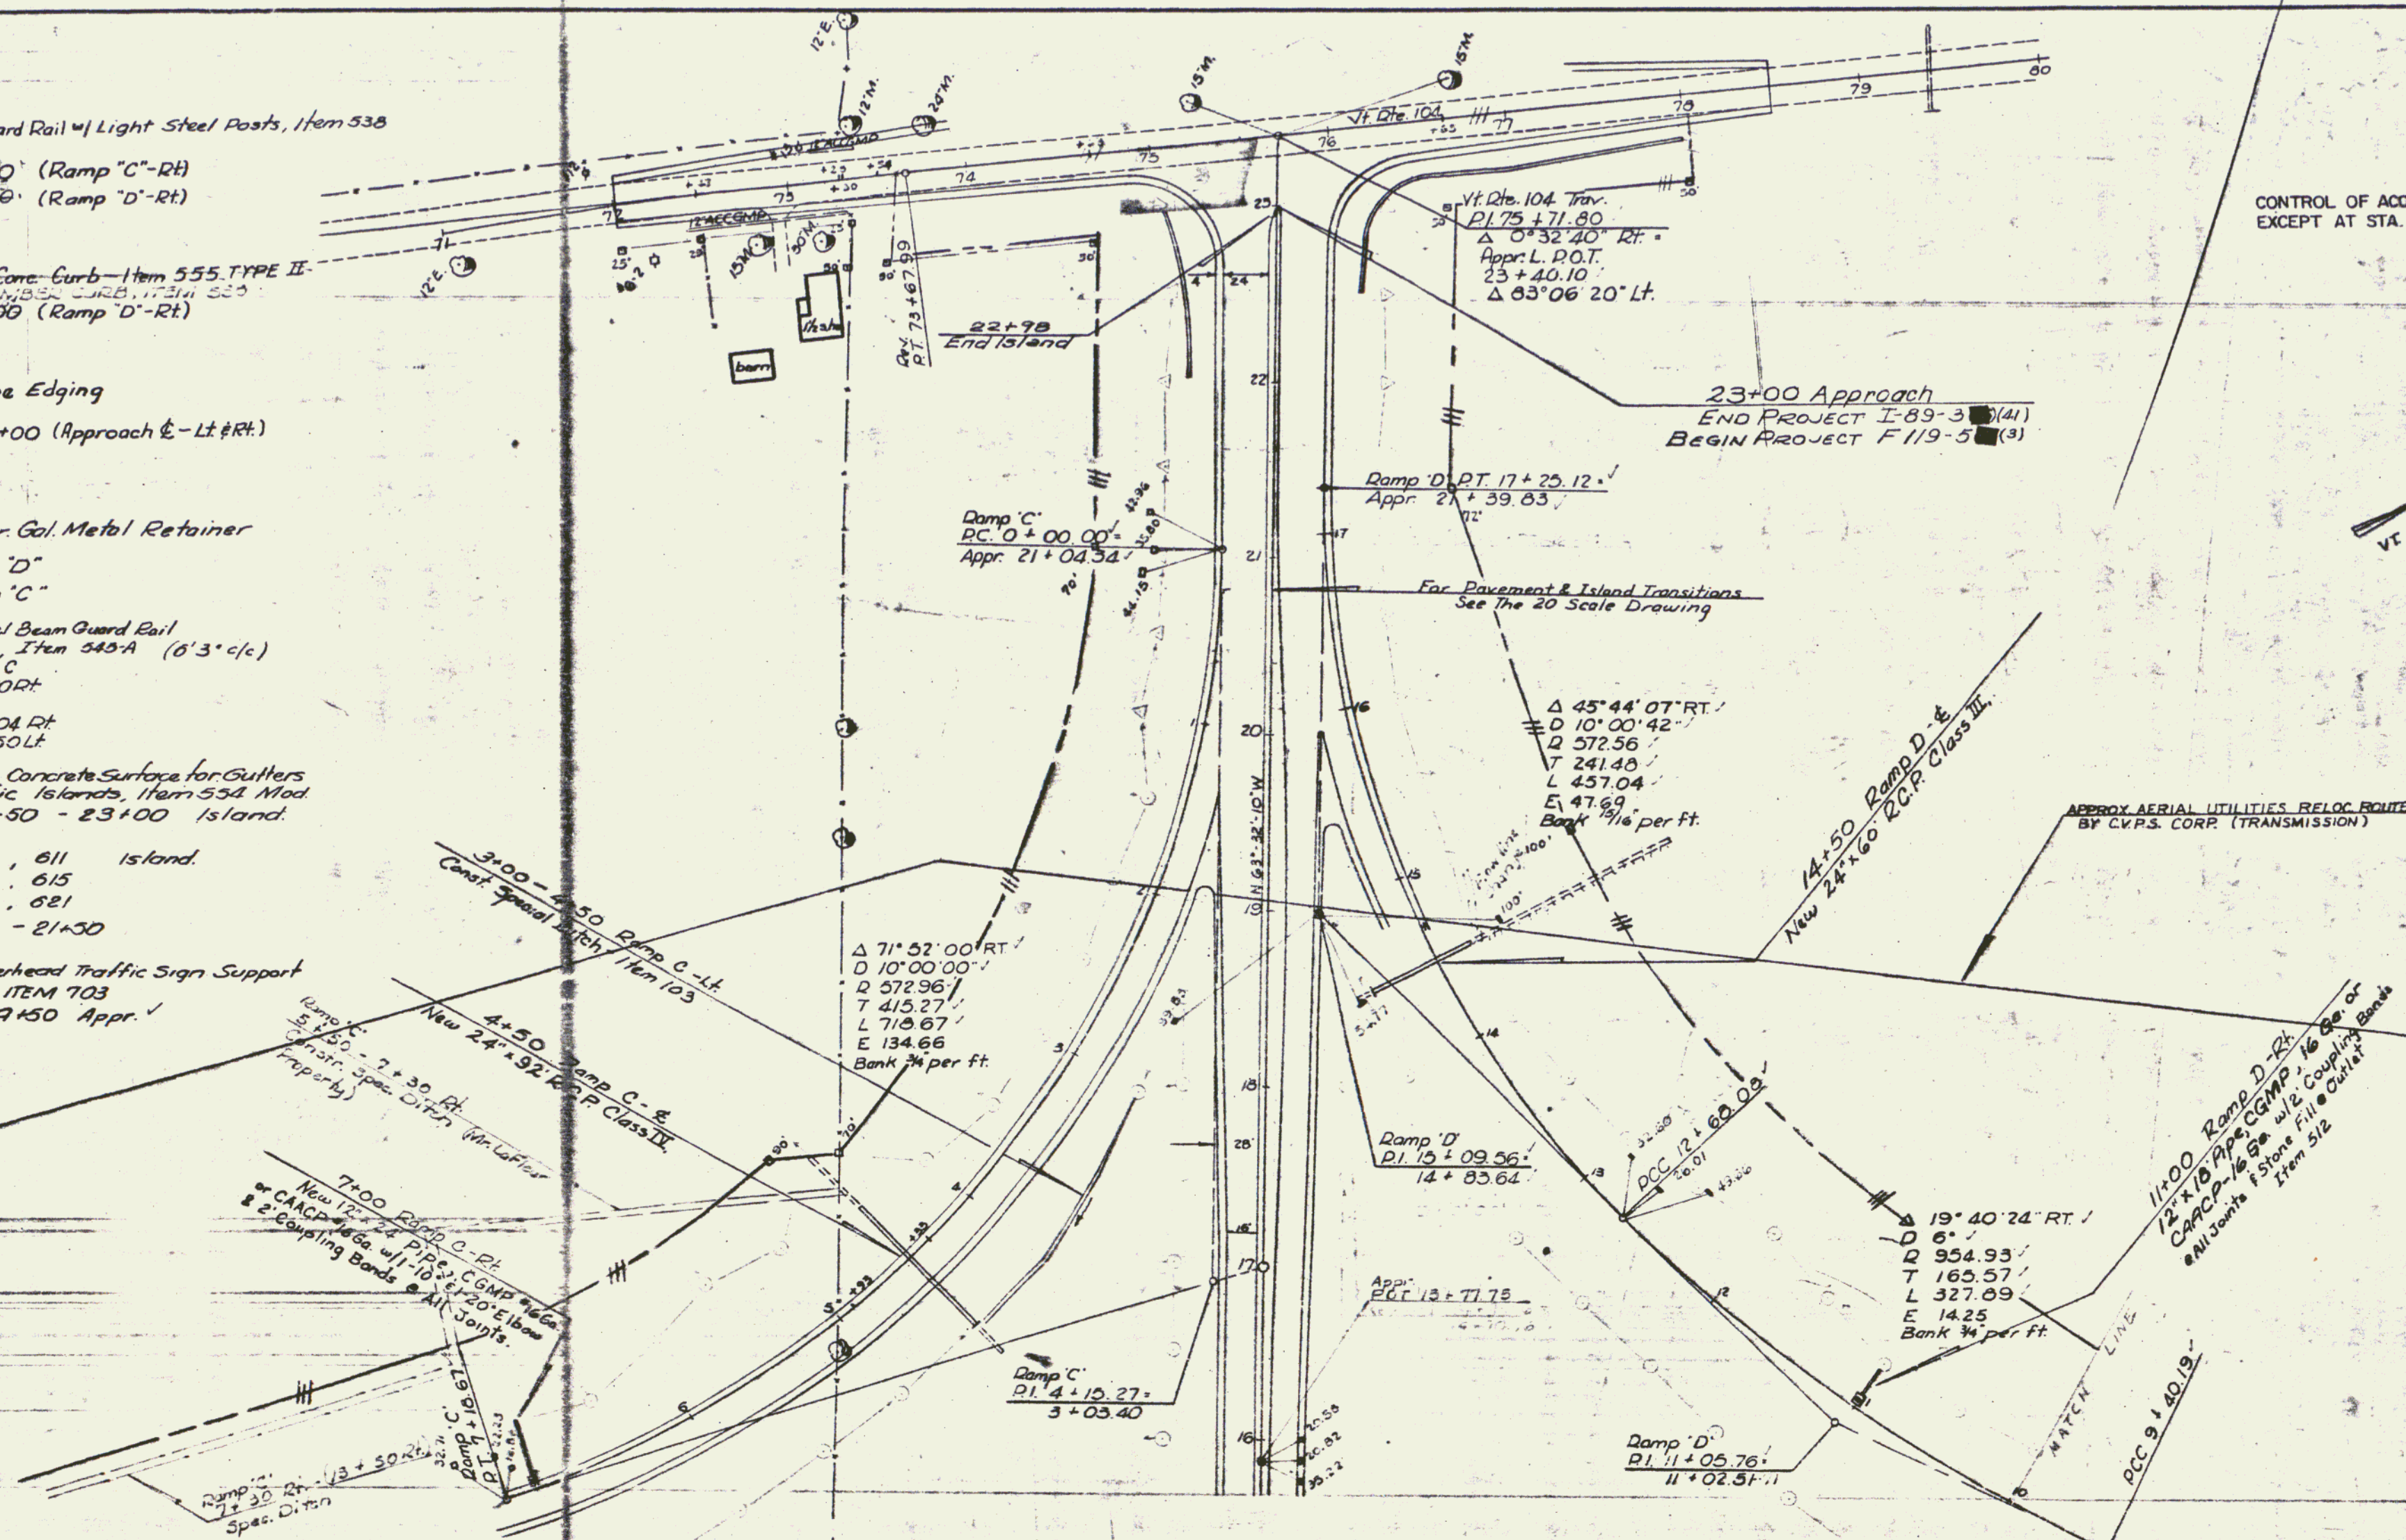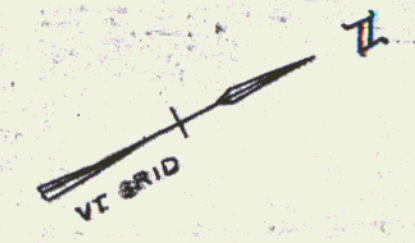

APPROX AERIAL UTILITIES RELOC ROUTE BY CV.P.S. CORP. (TRANSMISSION)

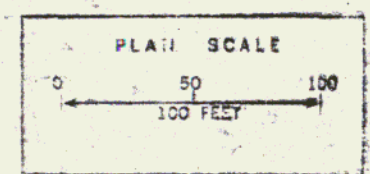

Stage 2 Construction

GEORGIA - FAIRFAX - FAIRFIELD - ST. ALBANS

SURVEYED BY \_\_\_\_\_ DATE \_\_\_\_\_  
DRAWN BY \_\_\_\_\_ DATE \_\_\_\_\_  
TRACED BY *WJ* DATE *9/66*

PROJ. *201* NO. 89-3 (41)  
SHEET *201* OF *213*

86