

VT 36 BITUMINOUS CONCRETE
CURE Item
L 13'-00" - 8'-00"
E 12'-30" - 8'-90"



VT 36 TREATED TIMBER
CURE Item
L 13'-00" - 16'-00"
E 13'-00" - 16'-00"

N 3444+00
END PROJECT I 89-300
BEGIN PROJECT I 89-3(25)
BEGIN CONTRACT #1

I 8
S Burlington
S Swanton
4375 (17PS)

For Details of
VT 36 see sheet
op

Approx. location
of water line from
spring house to
house and barn.

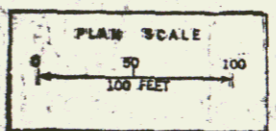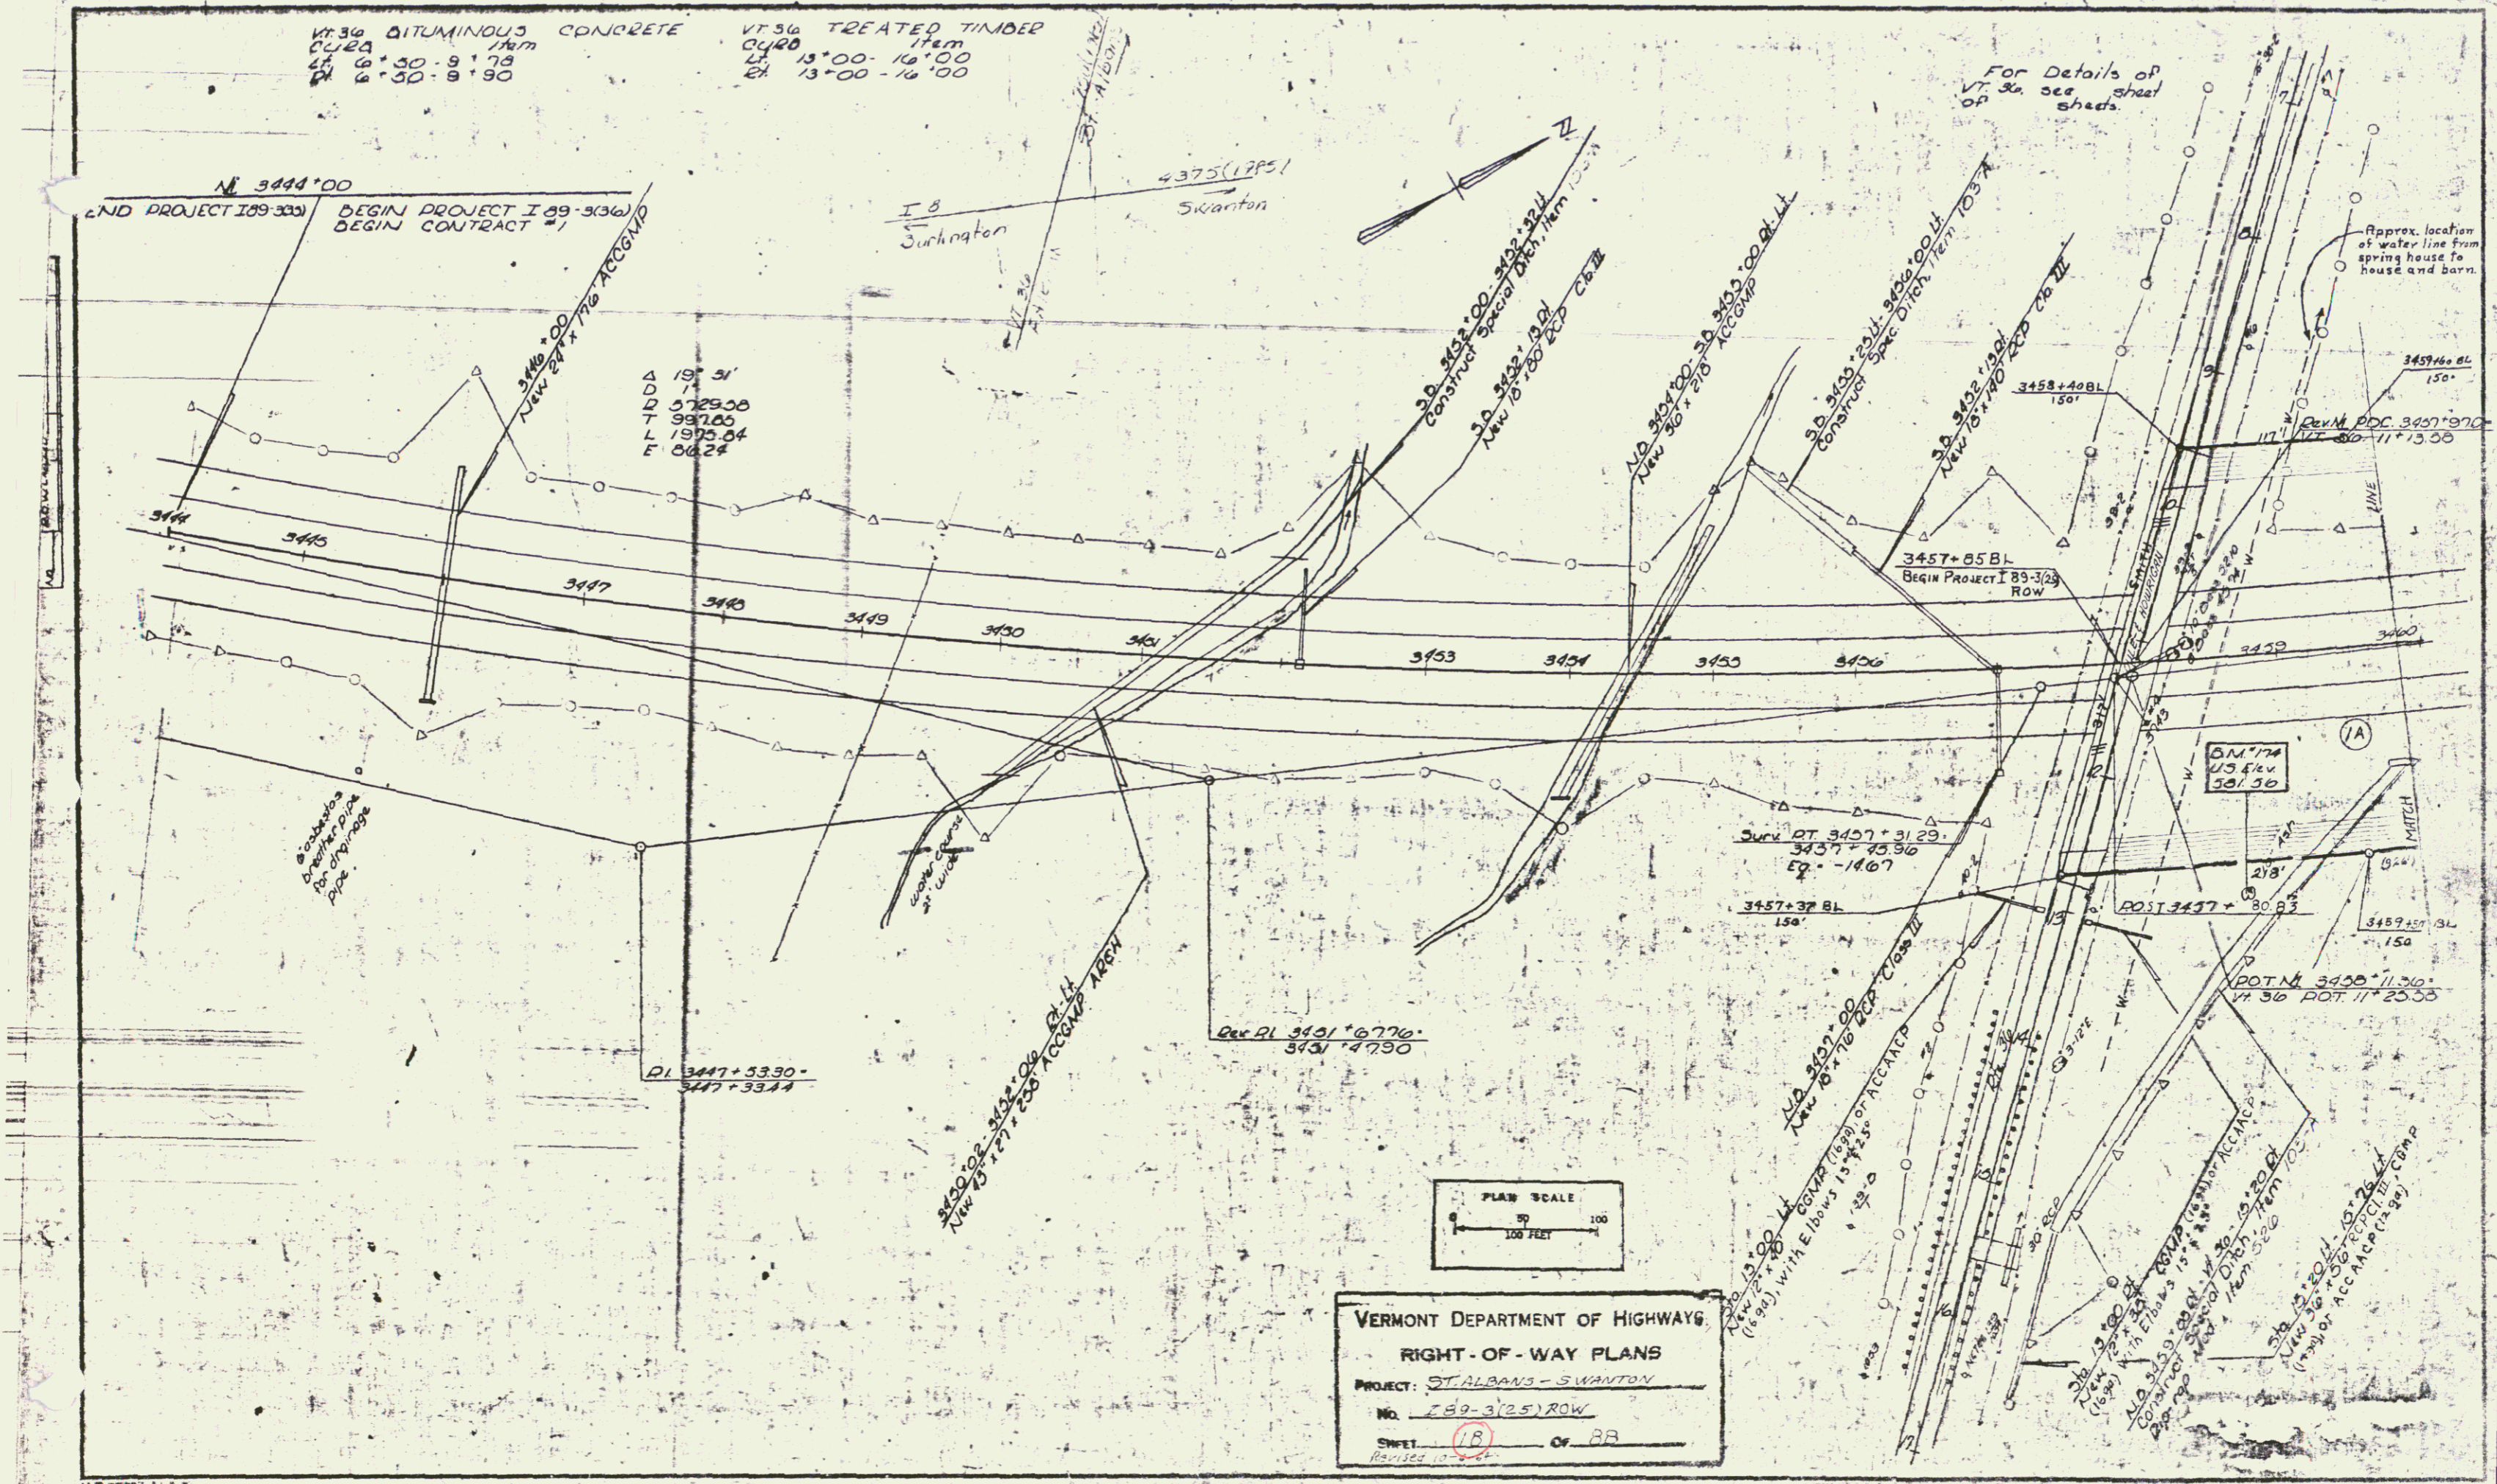

VERMONT DEPARTMENT OF HIGHWAYS
RIGHT-OF-WAY PLANS
PROJECT: ST. ALBANS - SWANTON
NO. 789-3(25) ROW
SHEET 18 OF 22
Revised 10-2-62