


PLAN
 DATE: 10/17/07
 DRAWN BY: [Signature]
 CHECKED BY: [Signature]
 SCALE: 1" = 100'
 SHEET NO. 26 OF 28

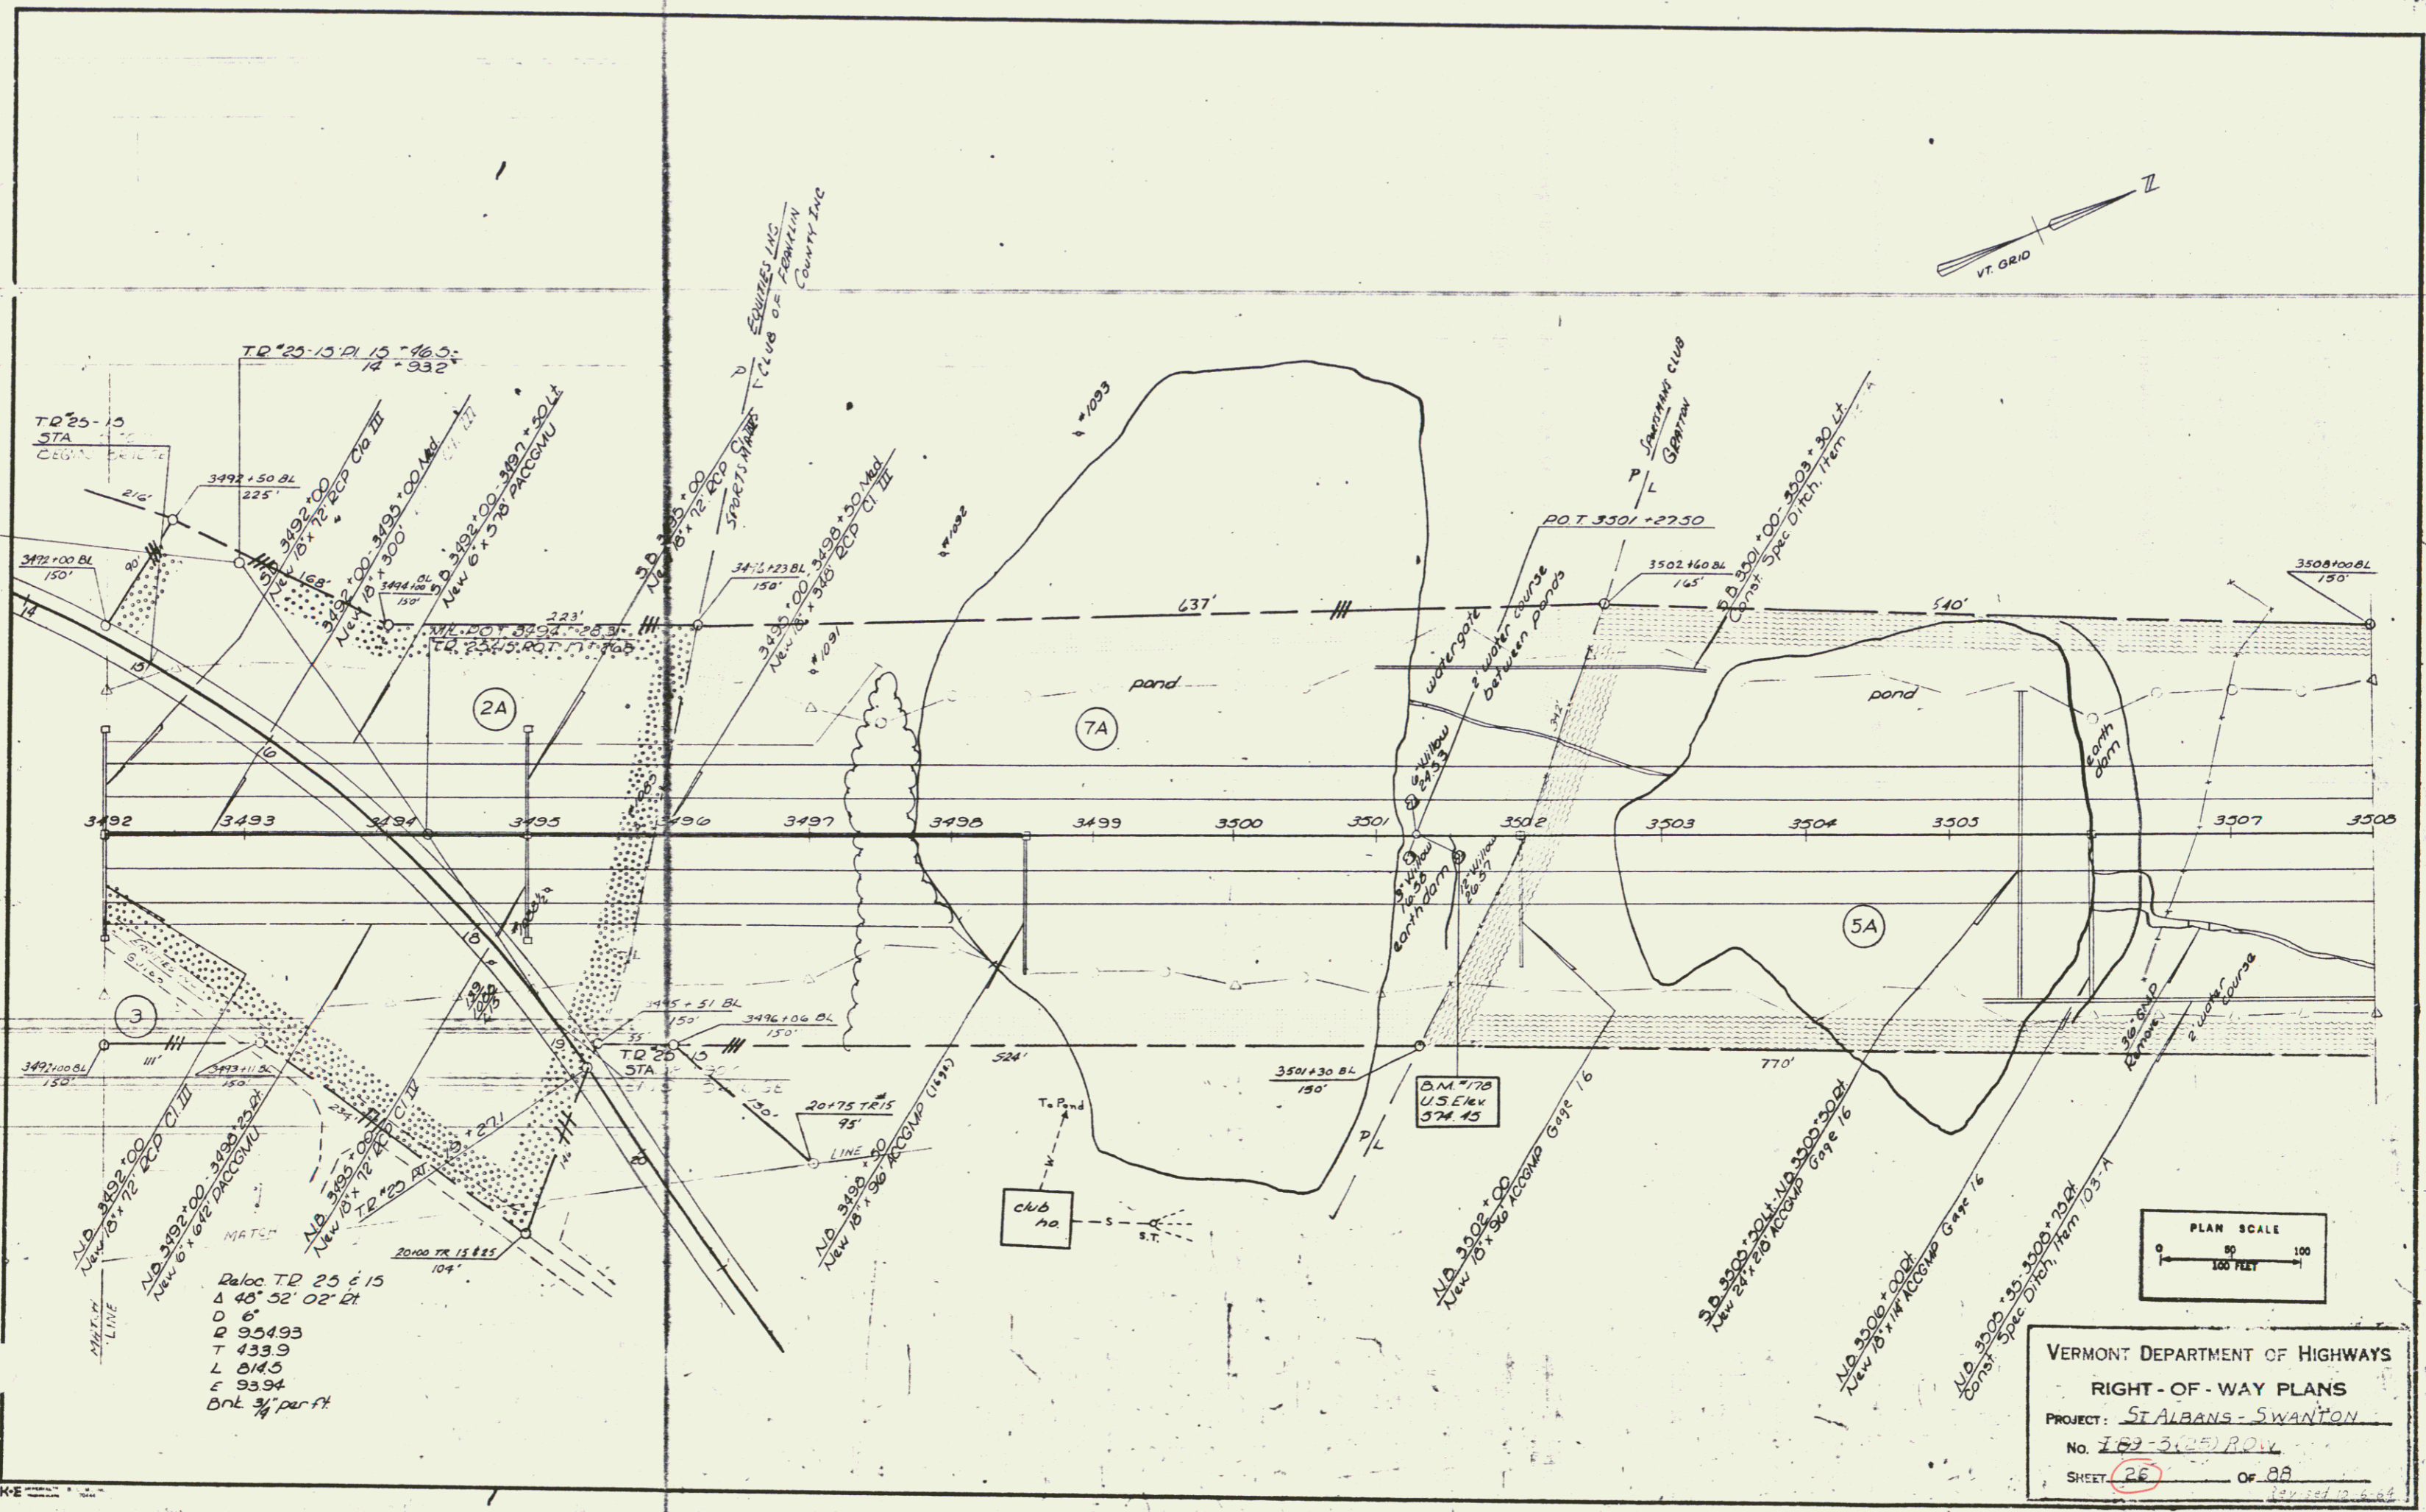

Reloc. TR 25 & 15
 Δ 48° 52' 02" Et
 D 6'
 R 954.93
 T 433.9
 L 014.5
 E 93.94
 Bnl 3/4" per ft

VERMONT DEPARTMENT OF HIGHWAYS
 RIGHT-OF-WAY PLANS
 PROJECT: ST ALBANS - SWANTON
 No. 169-3(25) R.O.W.
 SHEET 26 OF 28