
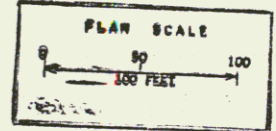


PLAN	NO. 100	DATE	10/1/50
BY	W. H. BROWN	SCALE	AS SHOWN
CHECKED	W. H. BROWN	PROJECT	ST. ALBANS - SWANTON
DATE	10/1/50	NO.	33

THREE CABLE GUARD RAIL
W/ STEEL POSTS, ITEM
N.D. 3588+00-3602+14.2'
S.D. 3588+00-3603+10.1'

DID RAP FOR BANK PROTECTION
MOD FOR CULVERT ENDS
N.D. 3604+00.2'

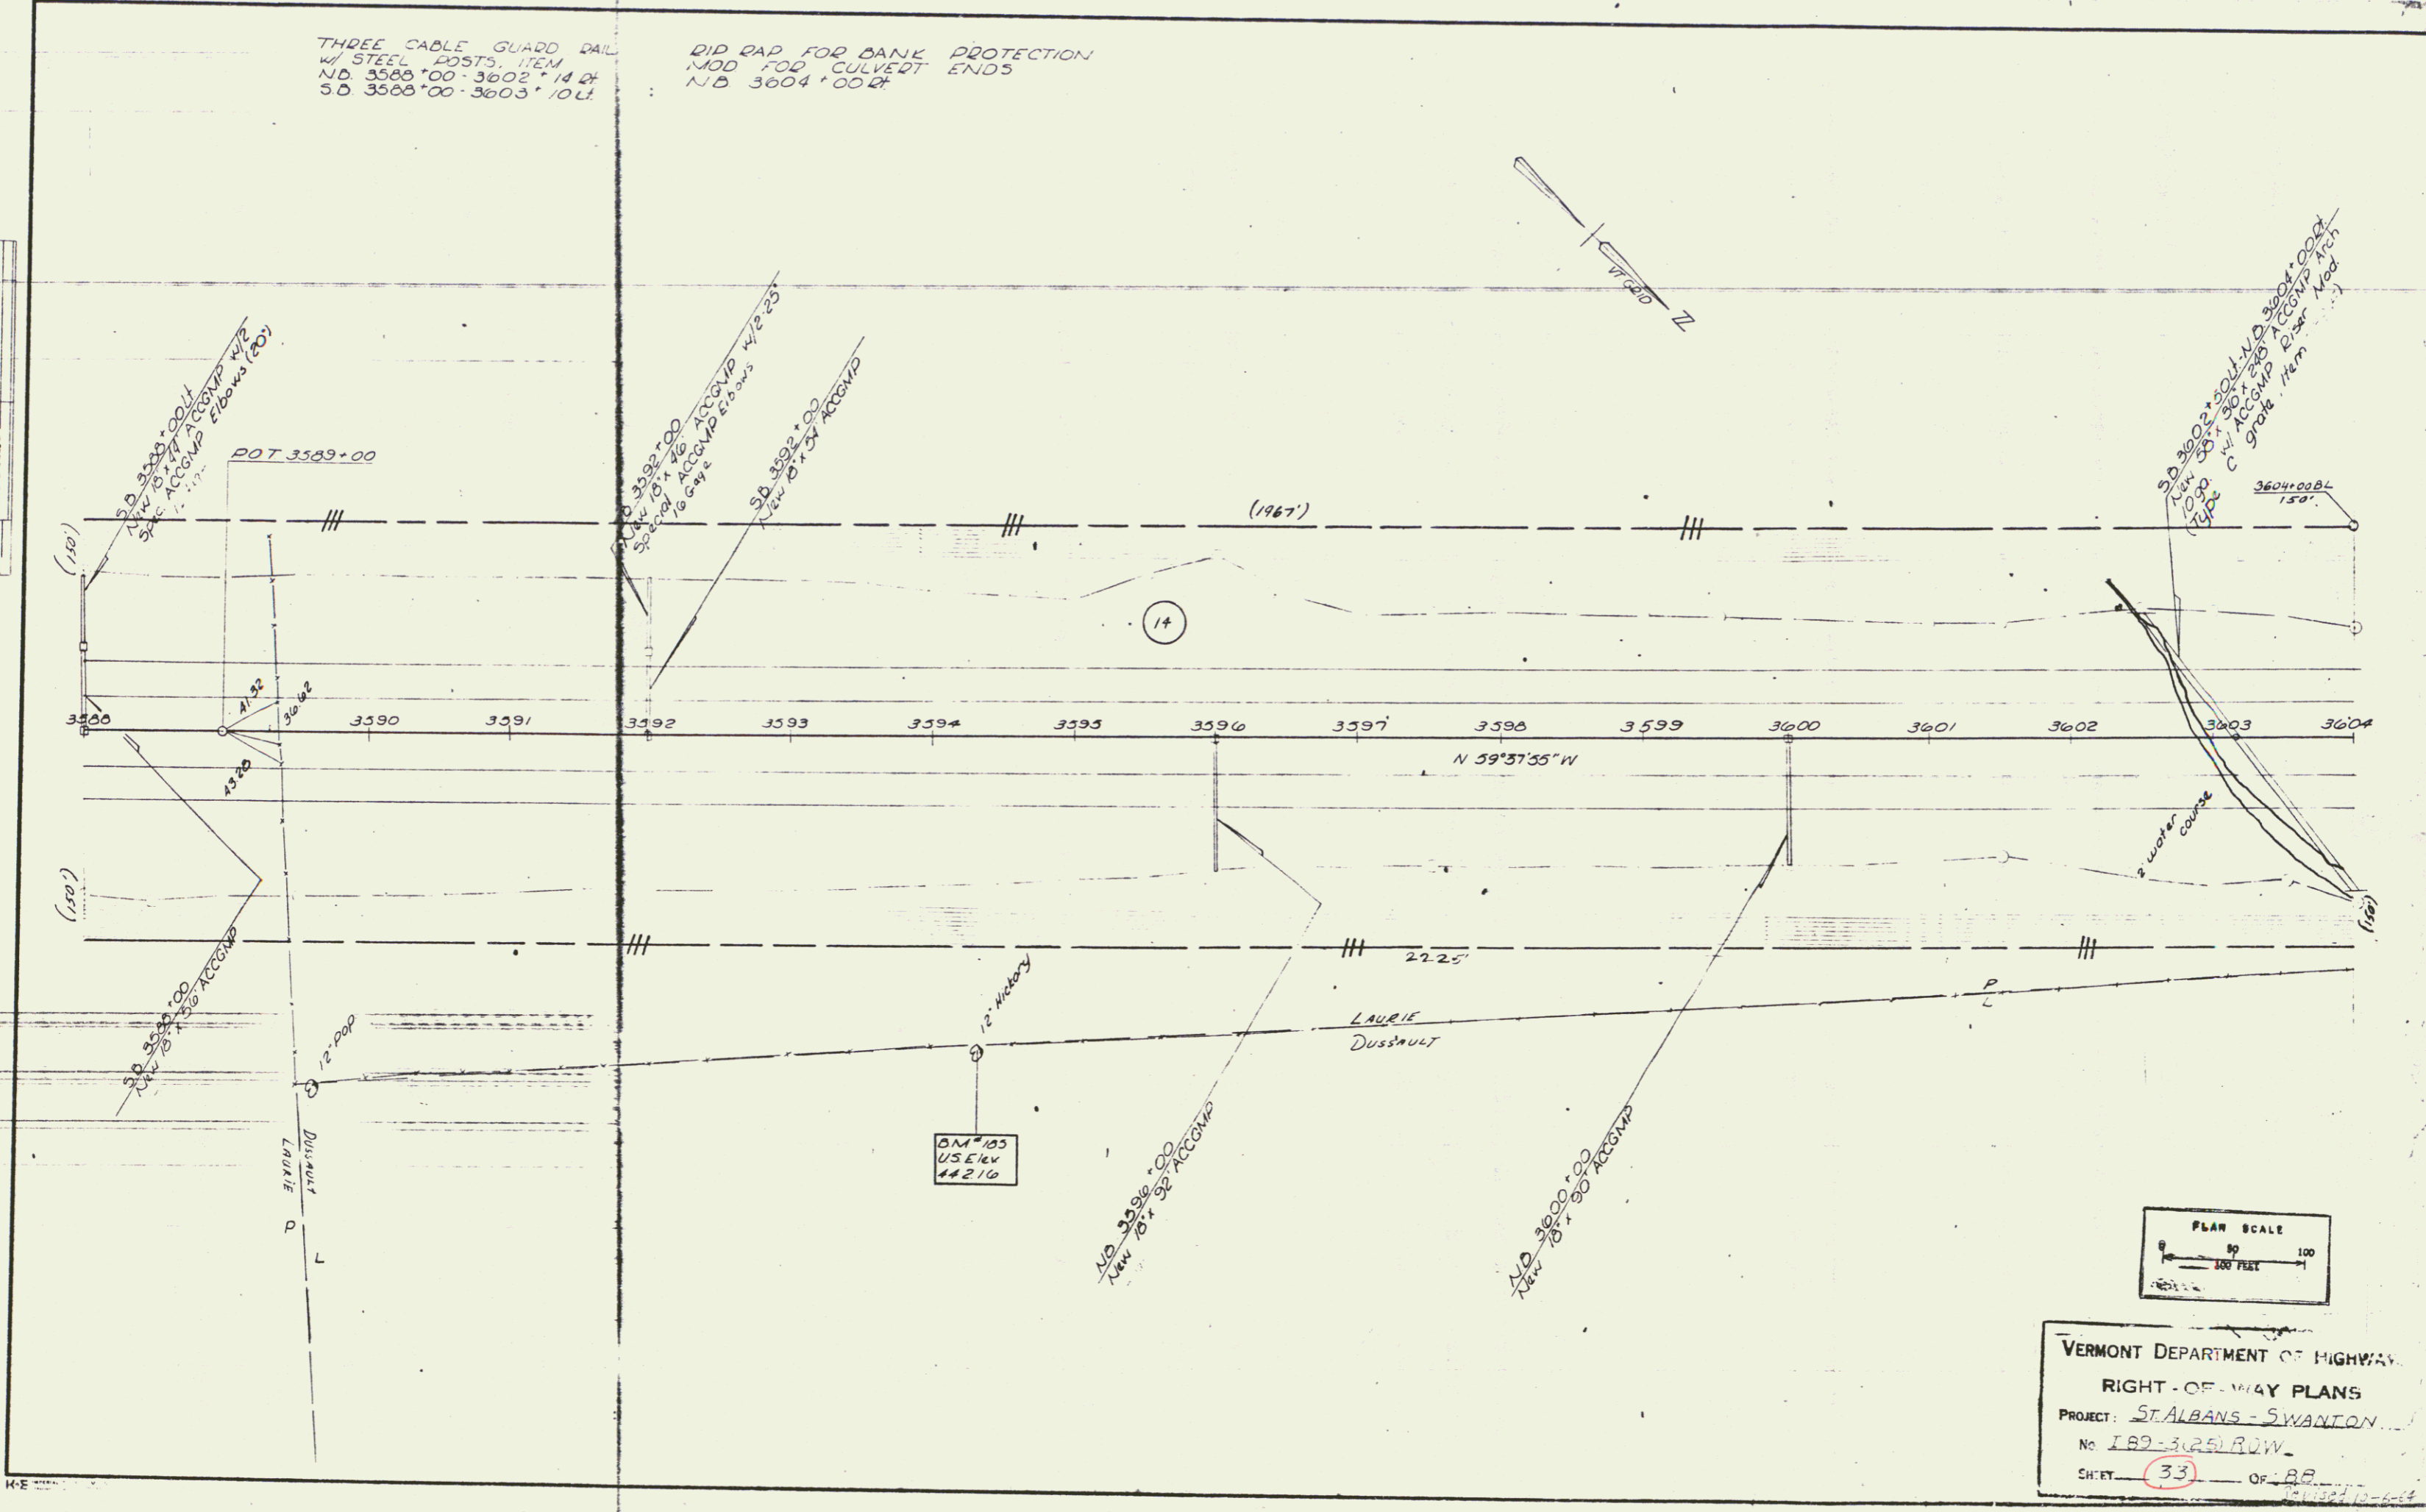

VERMONT DEPARTMENT OF HIGHWAY
RIGHT-OF-WAY PLANS
PROJECT: ST. ALBANS - SWANTON
No. 189-30251 ROW
SHEET 33 OF 88

31