



PLAN
 DRAWN BY
 CHECKED BY
 DATE

THREE CABLE GUARD RAIL w/
 STEEL POSTS, ITEM
 SB 3620+00 Lt 3621+12 Lt
 NB 3620+00 Rt 3620+64 Rt
 SB 3623+96 Lt 3627+96 Lt
 NB 3627+50 Lt 3627+85 Lt
 NB 3624+49 Rt 3627+85 Rt
 NB 3629+86 Lt 3630+00 Rt
 NB 3629+91 Lt 3634+13 Rt
 NB 3636+87 Lt 3641+13 Lt
 SB 3627+60 Rt 3627+101 Rt
 SB 3629+96 Rt 3630+00 Rt
 SB 3629+91 3635+11 Lt
 Ramp B 3+50 4+62 Lt
 Ramp D 4+00 5+02 Rt
 Ramp A 4+45 5+75 Rt
 Ramp A 5+71 6+75 Lt

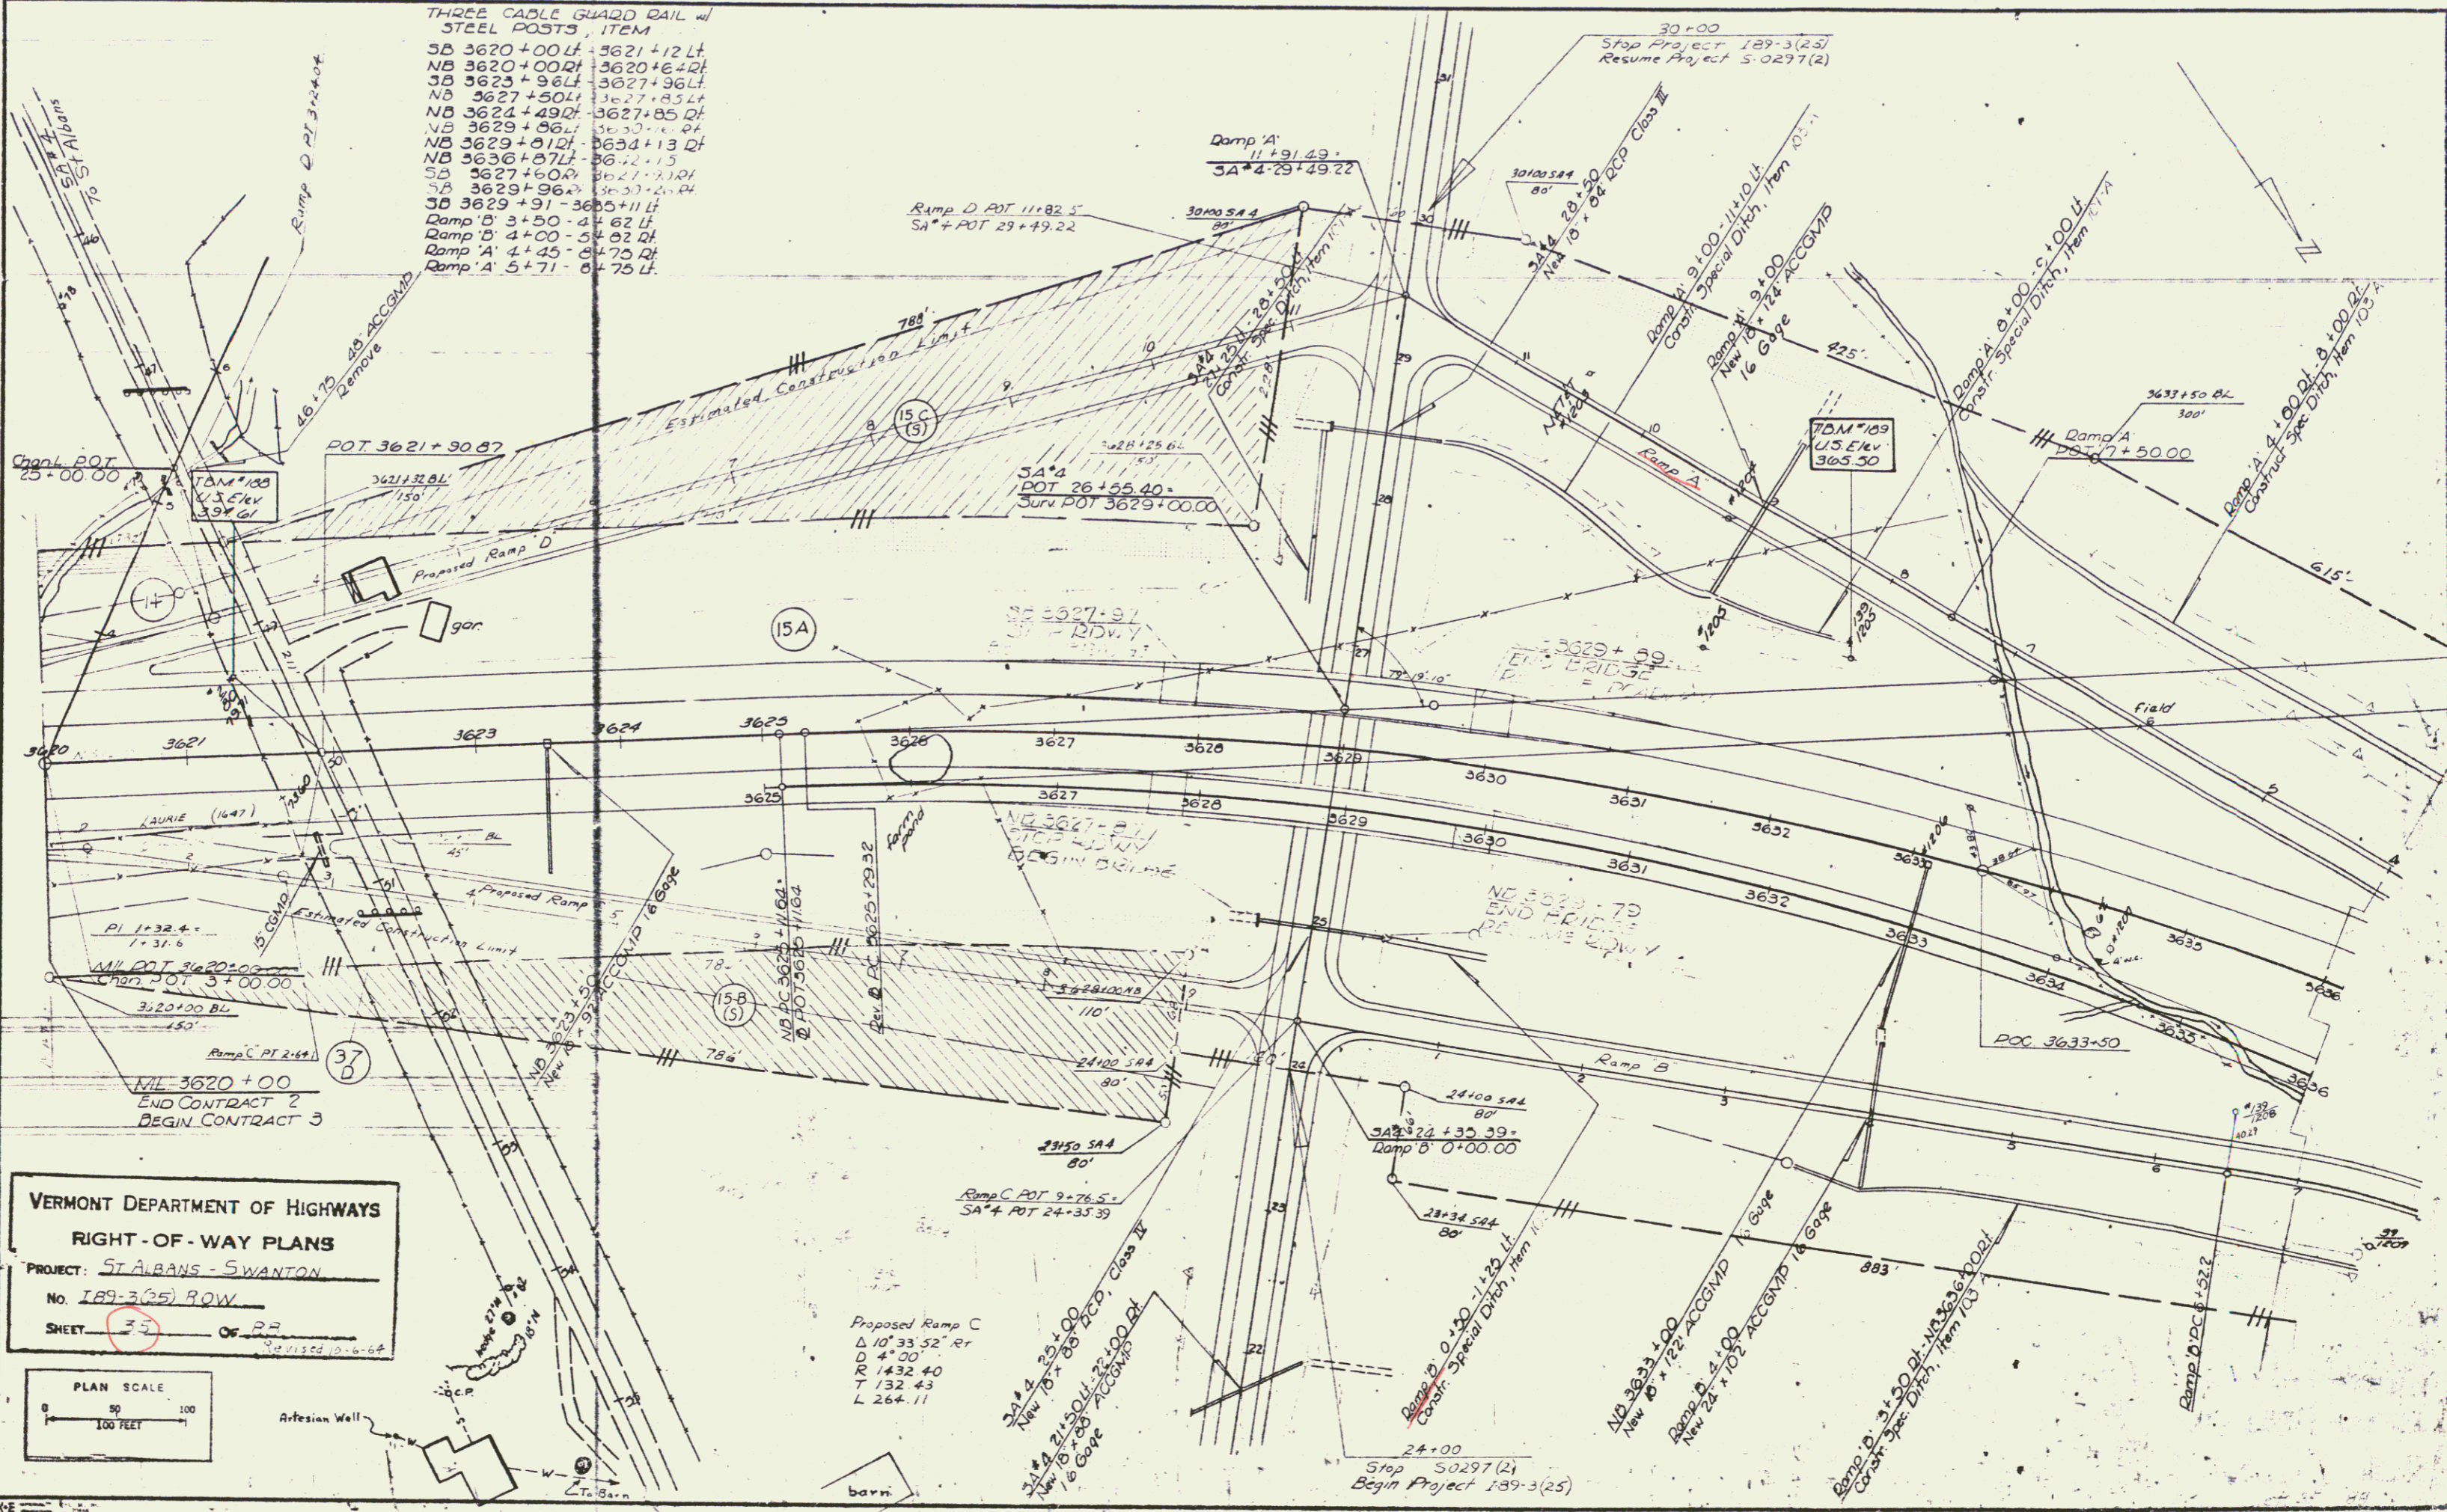

VERMONT DEPARTMENT OF HIGHWAYS
 RIGHT-OF-WAY PLANS
 PROJECT: ST. ALBANS - SWANTON
 No. 189-3(25) ROW
 SHEET: 35 OF 33

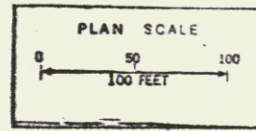

Sheet 35 R.O.W
 I-89-3(25) 33