
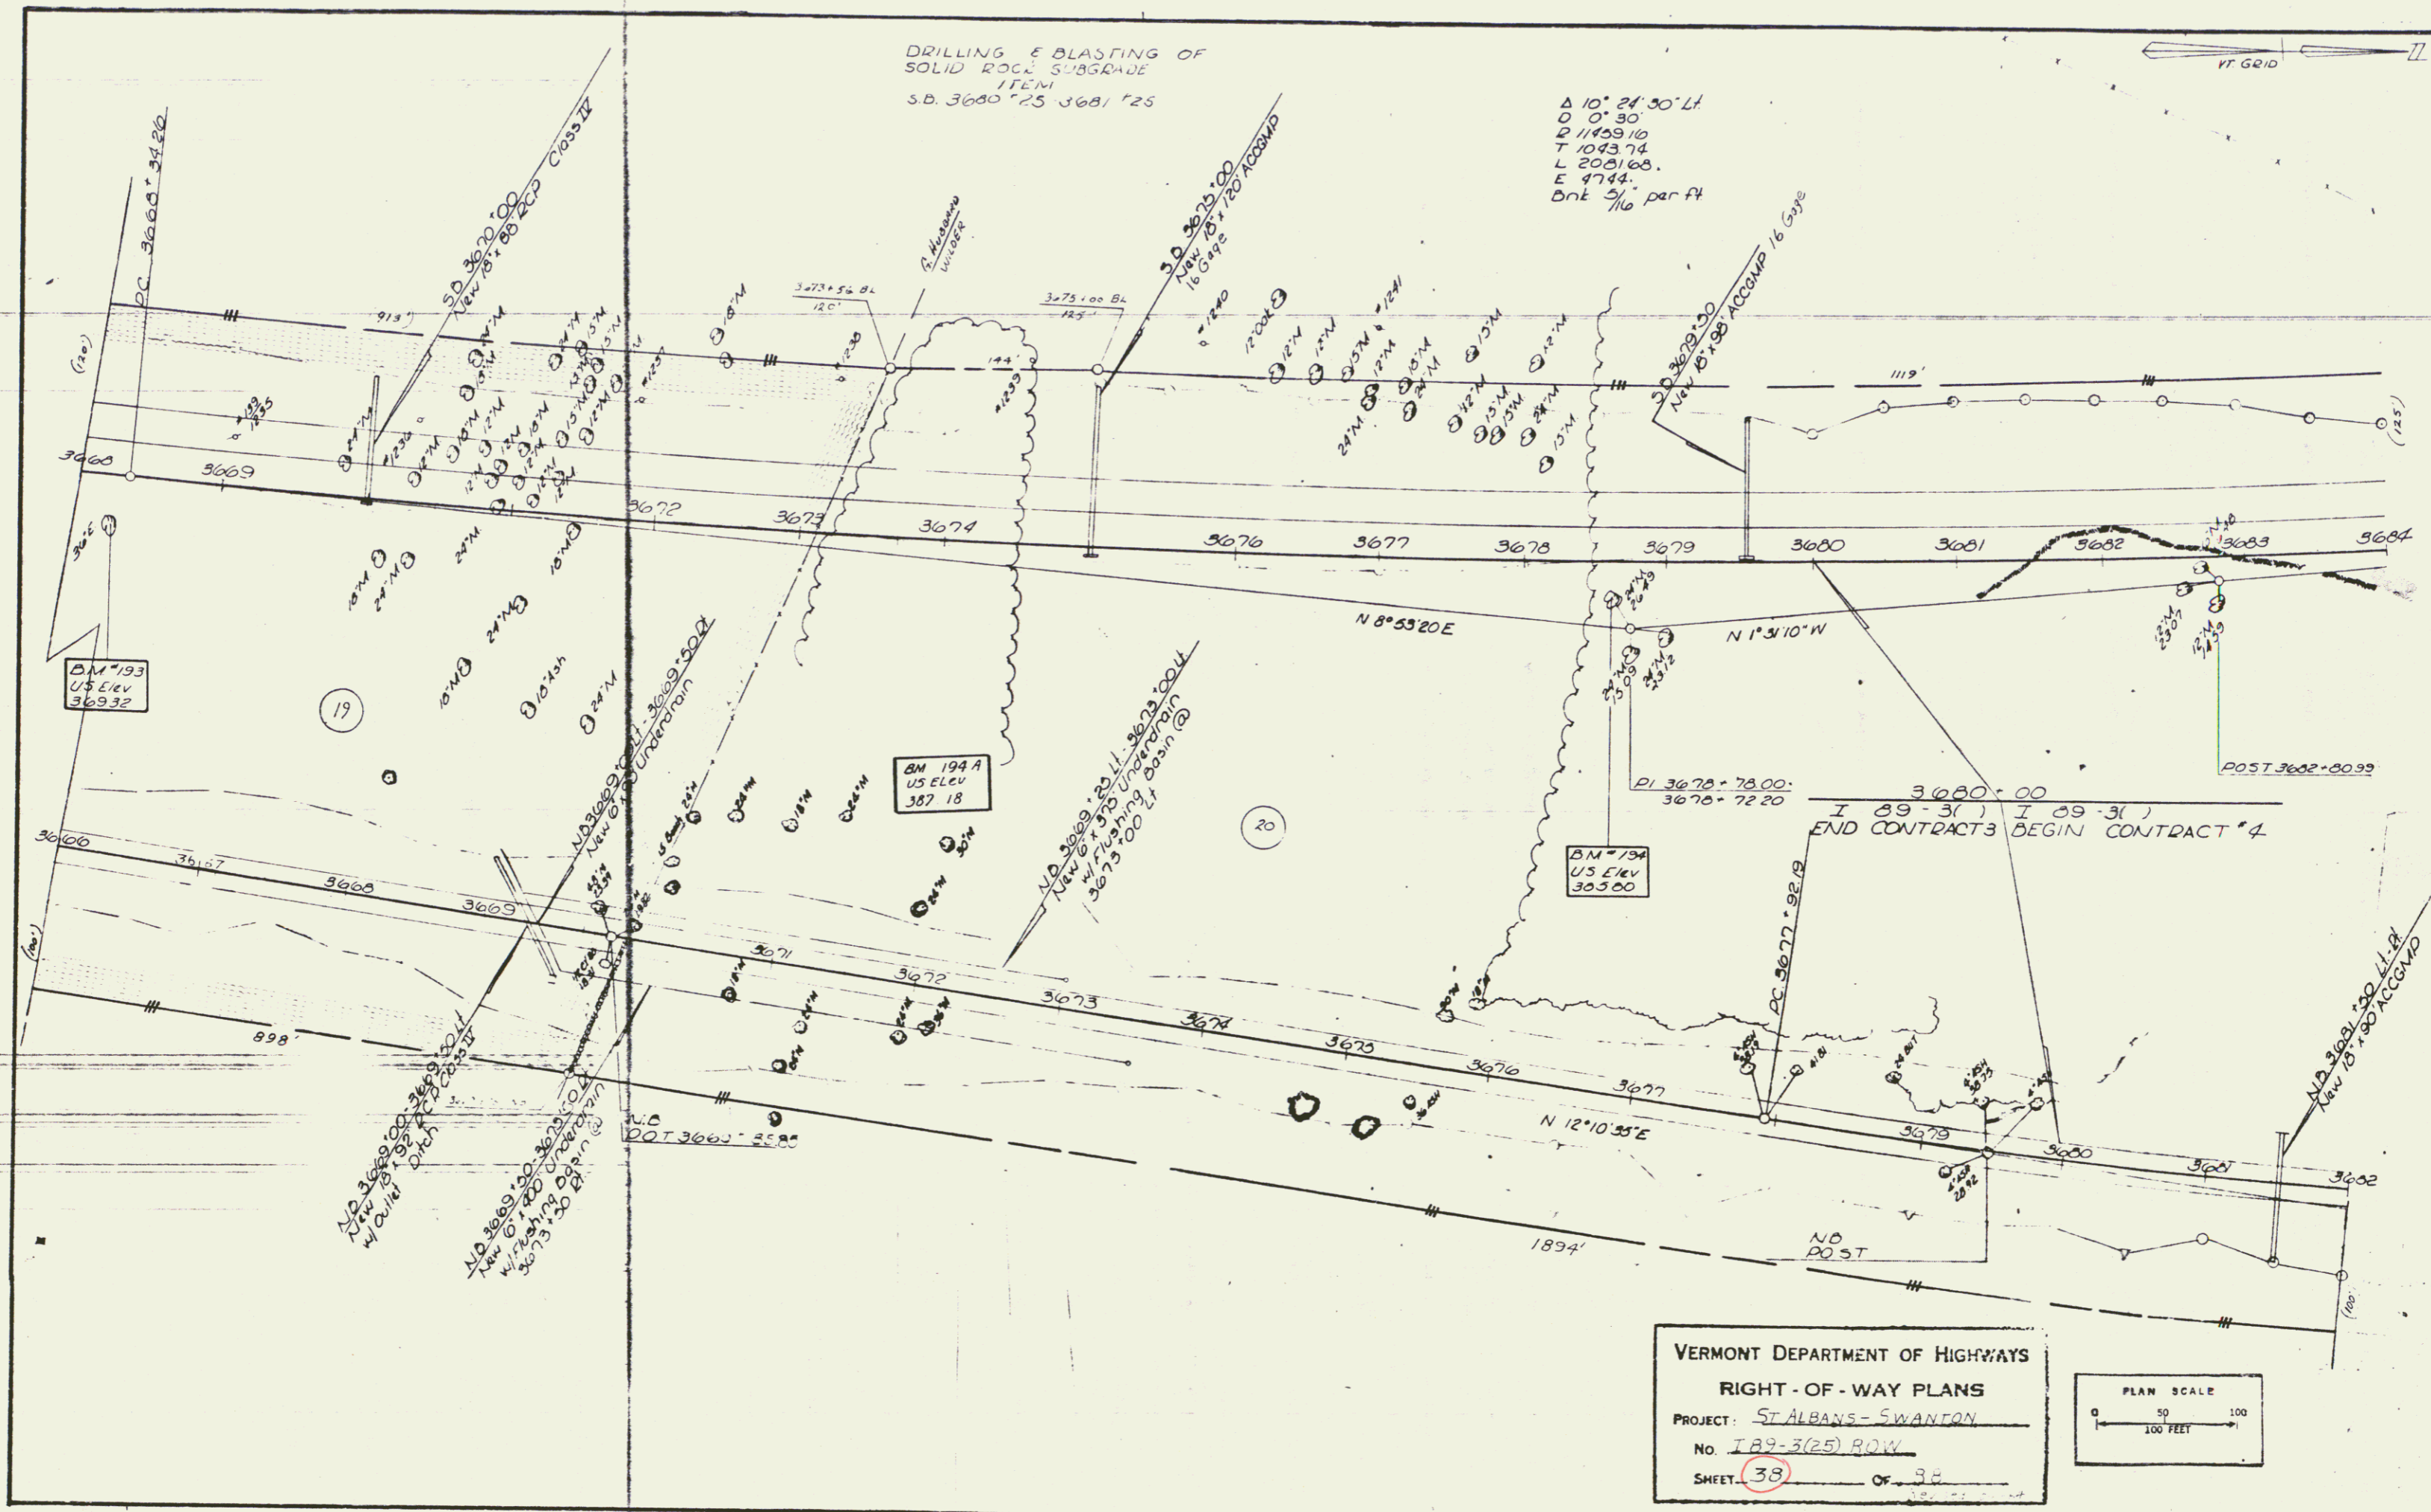


DRILLING & BLASTING OF  
SOLID ROCK SUBGRADE  
ITEM  
S.D. 3600 '25 3681 '25

$\Delta 10^{\circ} 24' 30''$  LI  
D 0' 30"  
R 11499.16  
T 10493.74  
L 2021.68  
E 4744.  
Dnk  $\frac{5}{16}$  per ft

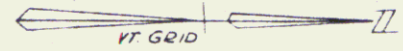


BM 193  
US ELEV  
369.92

BM 194 A  
US ELEV  
387.18

BM 194  
US ELEV  
365.60

VERMONT DEPARTMENT OF HIGHWAYS  
RIGHT - OF - WAY PLANS  
PROJECT: ST ALBANS - SWANTON  
NO. I 89-3(25) R.O.W.  
SHEET 38 OF 38

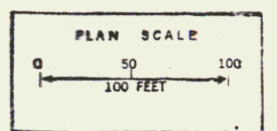

36