


DRILLING & BLASTING OF SOLID  
ROCK SUBGRADE, ITEM 114  
NB 3699 +75 - 3701 +25  
NB 3702 +25 - 3703 +75

MUCK EXCAVATION, ITEM 116  
SB 3706 +00 - 3716 +00

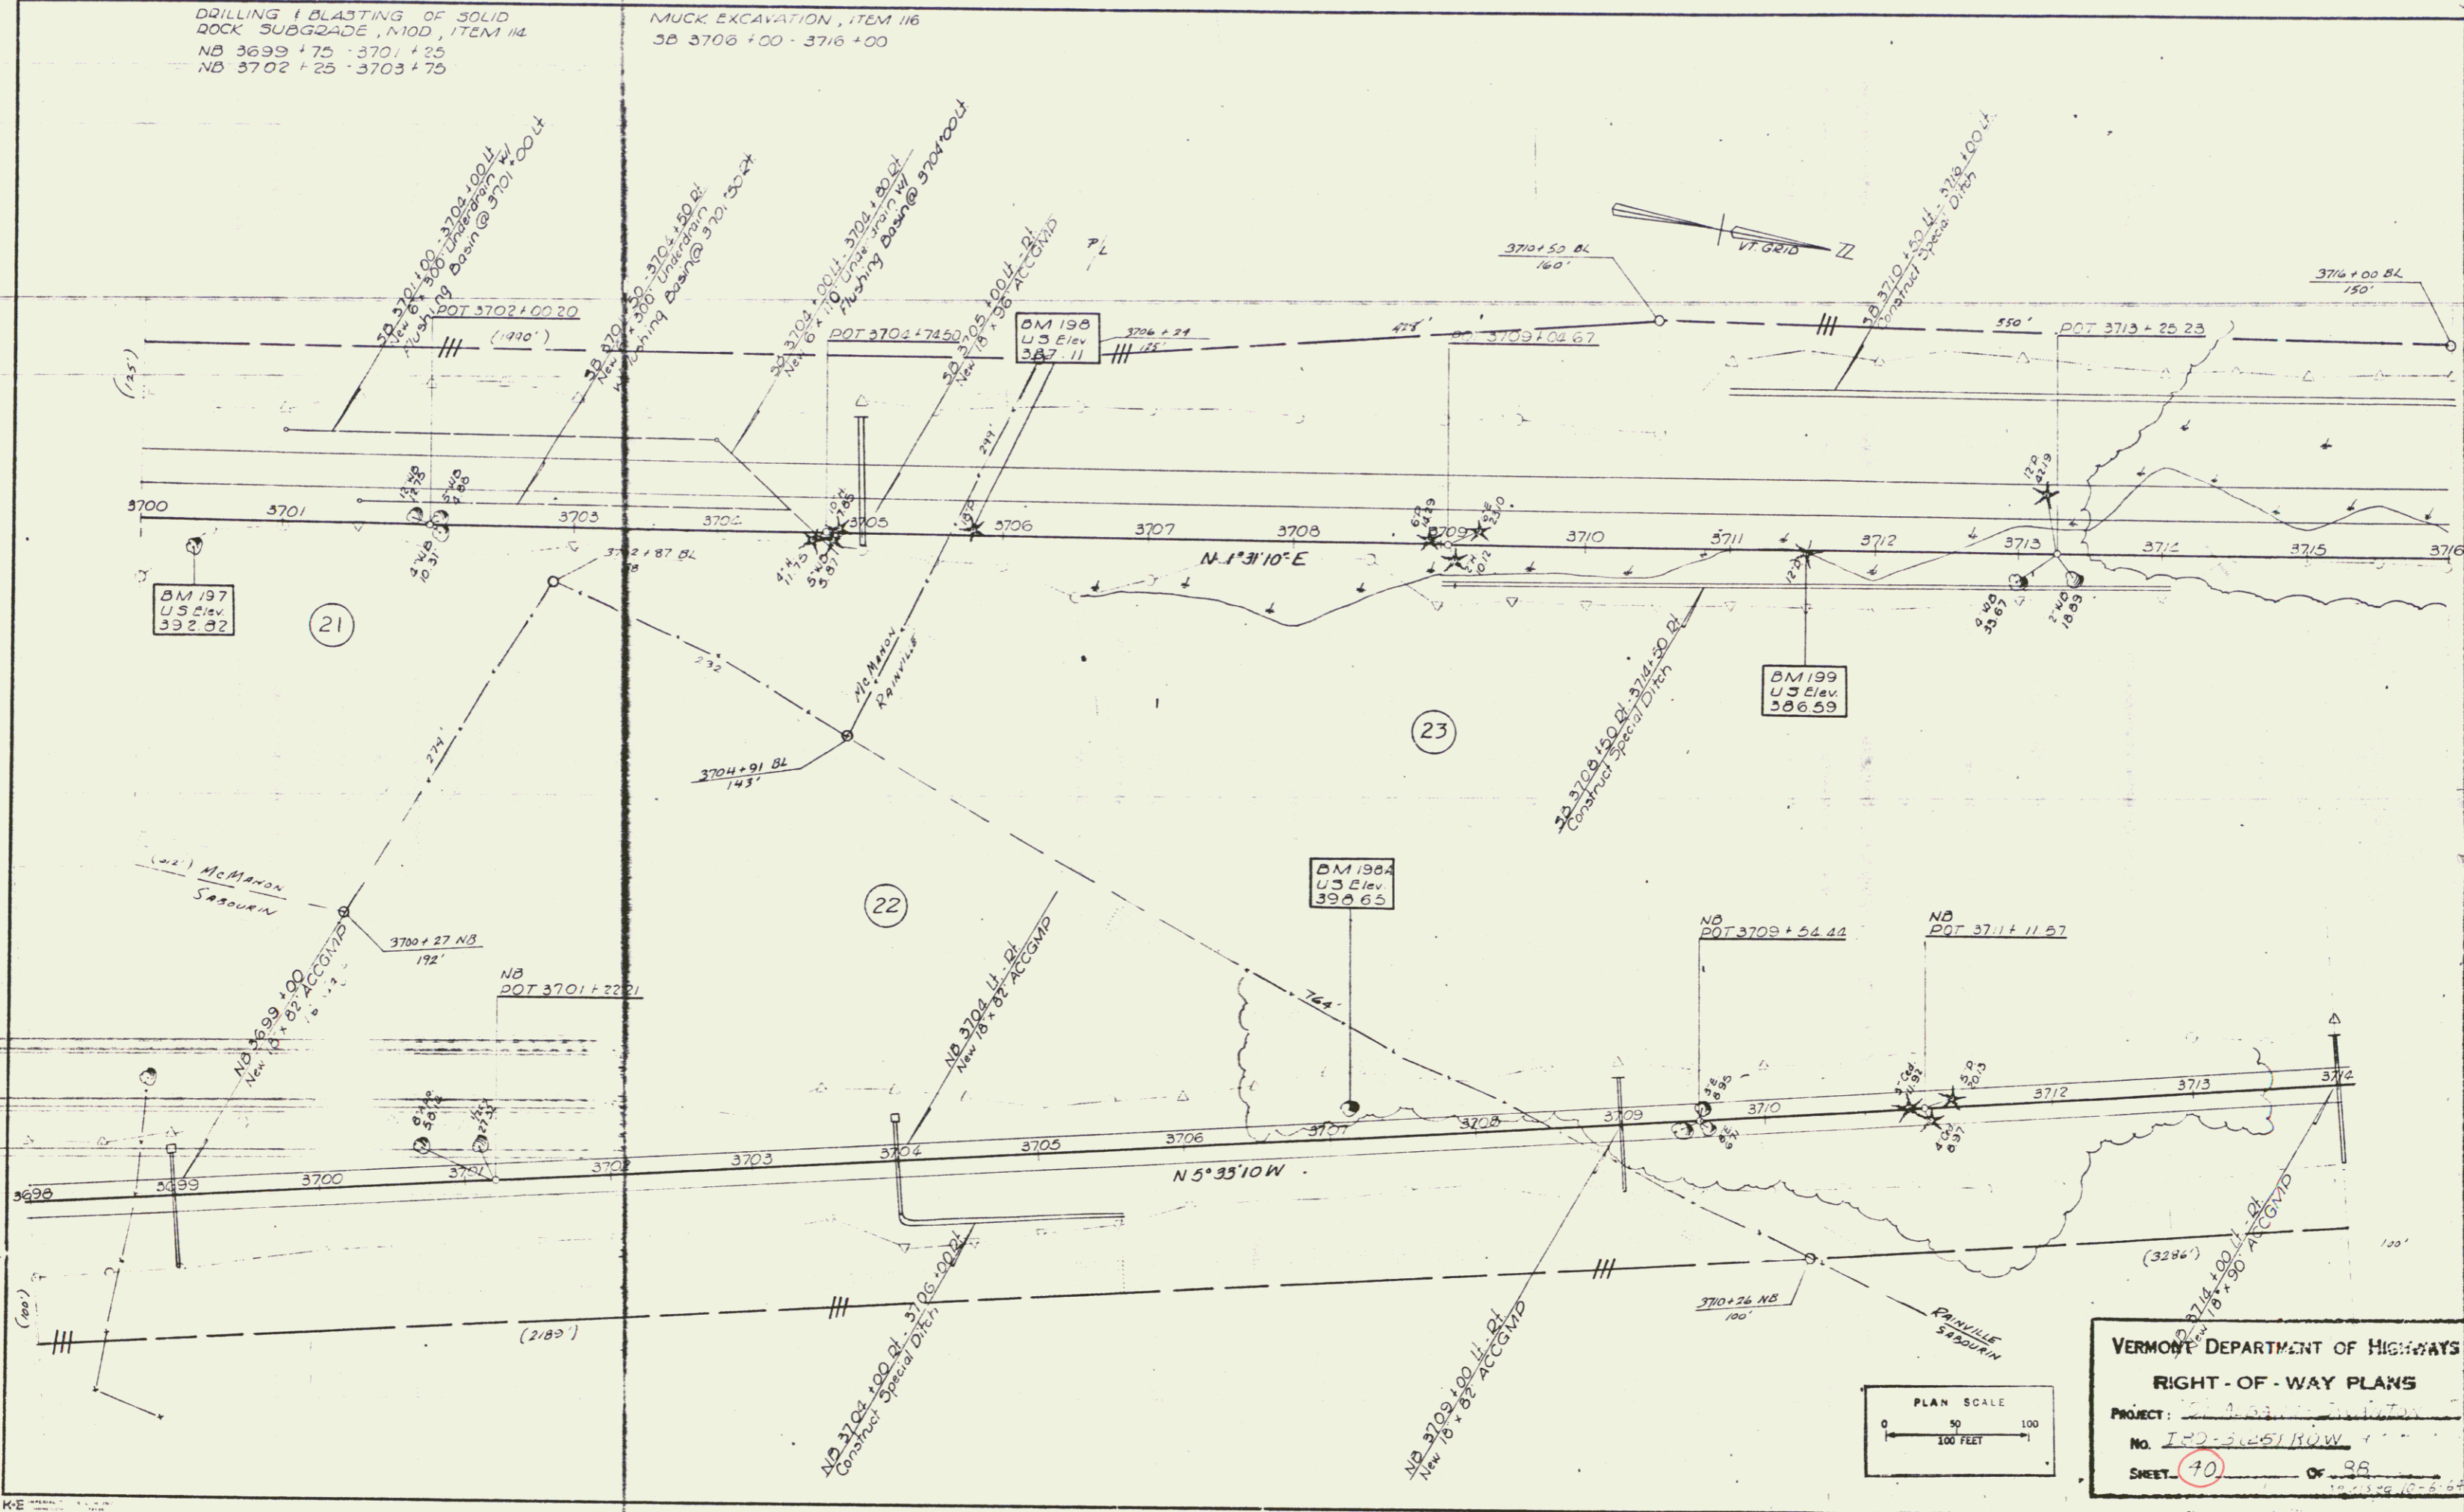

VERMONT DEPARTMENT OF HIGHWAYS  
RIGHT-OF-WAY PLANS  
PROJECT: 100-3251 ROW  
No. 100-3251 ROW  
SHEET 70 OF 98