


PLAN	DATE	BY
RIGHT-OF-WAY	12/15/88	J. CHASE
NO. 13		

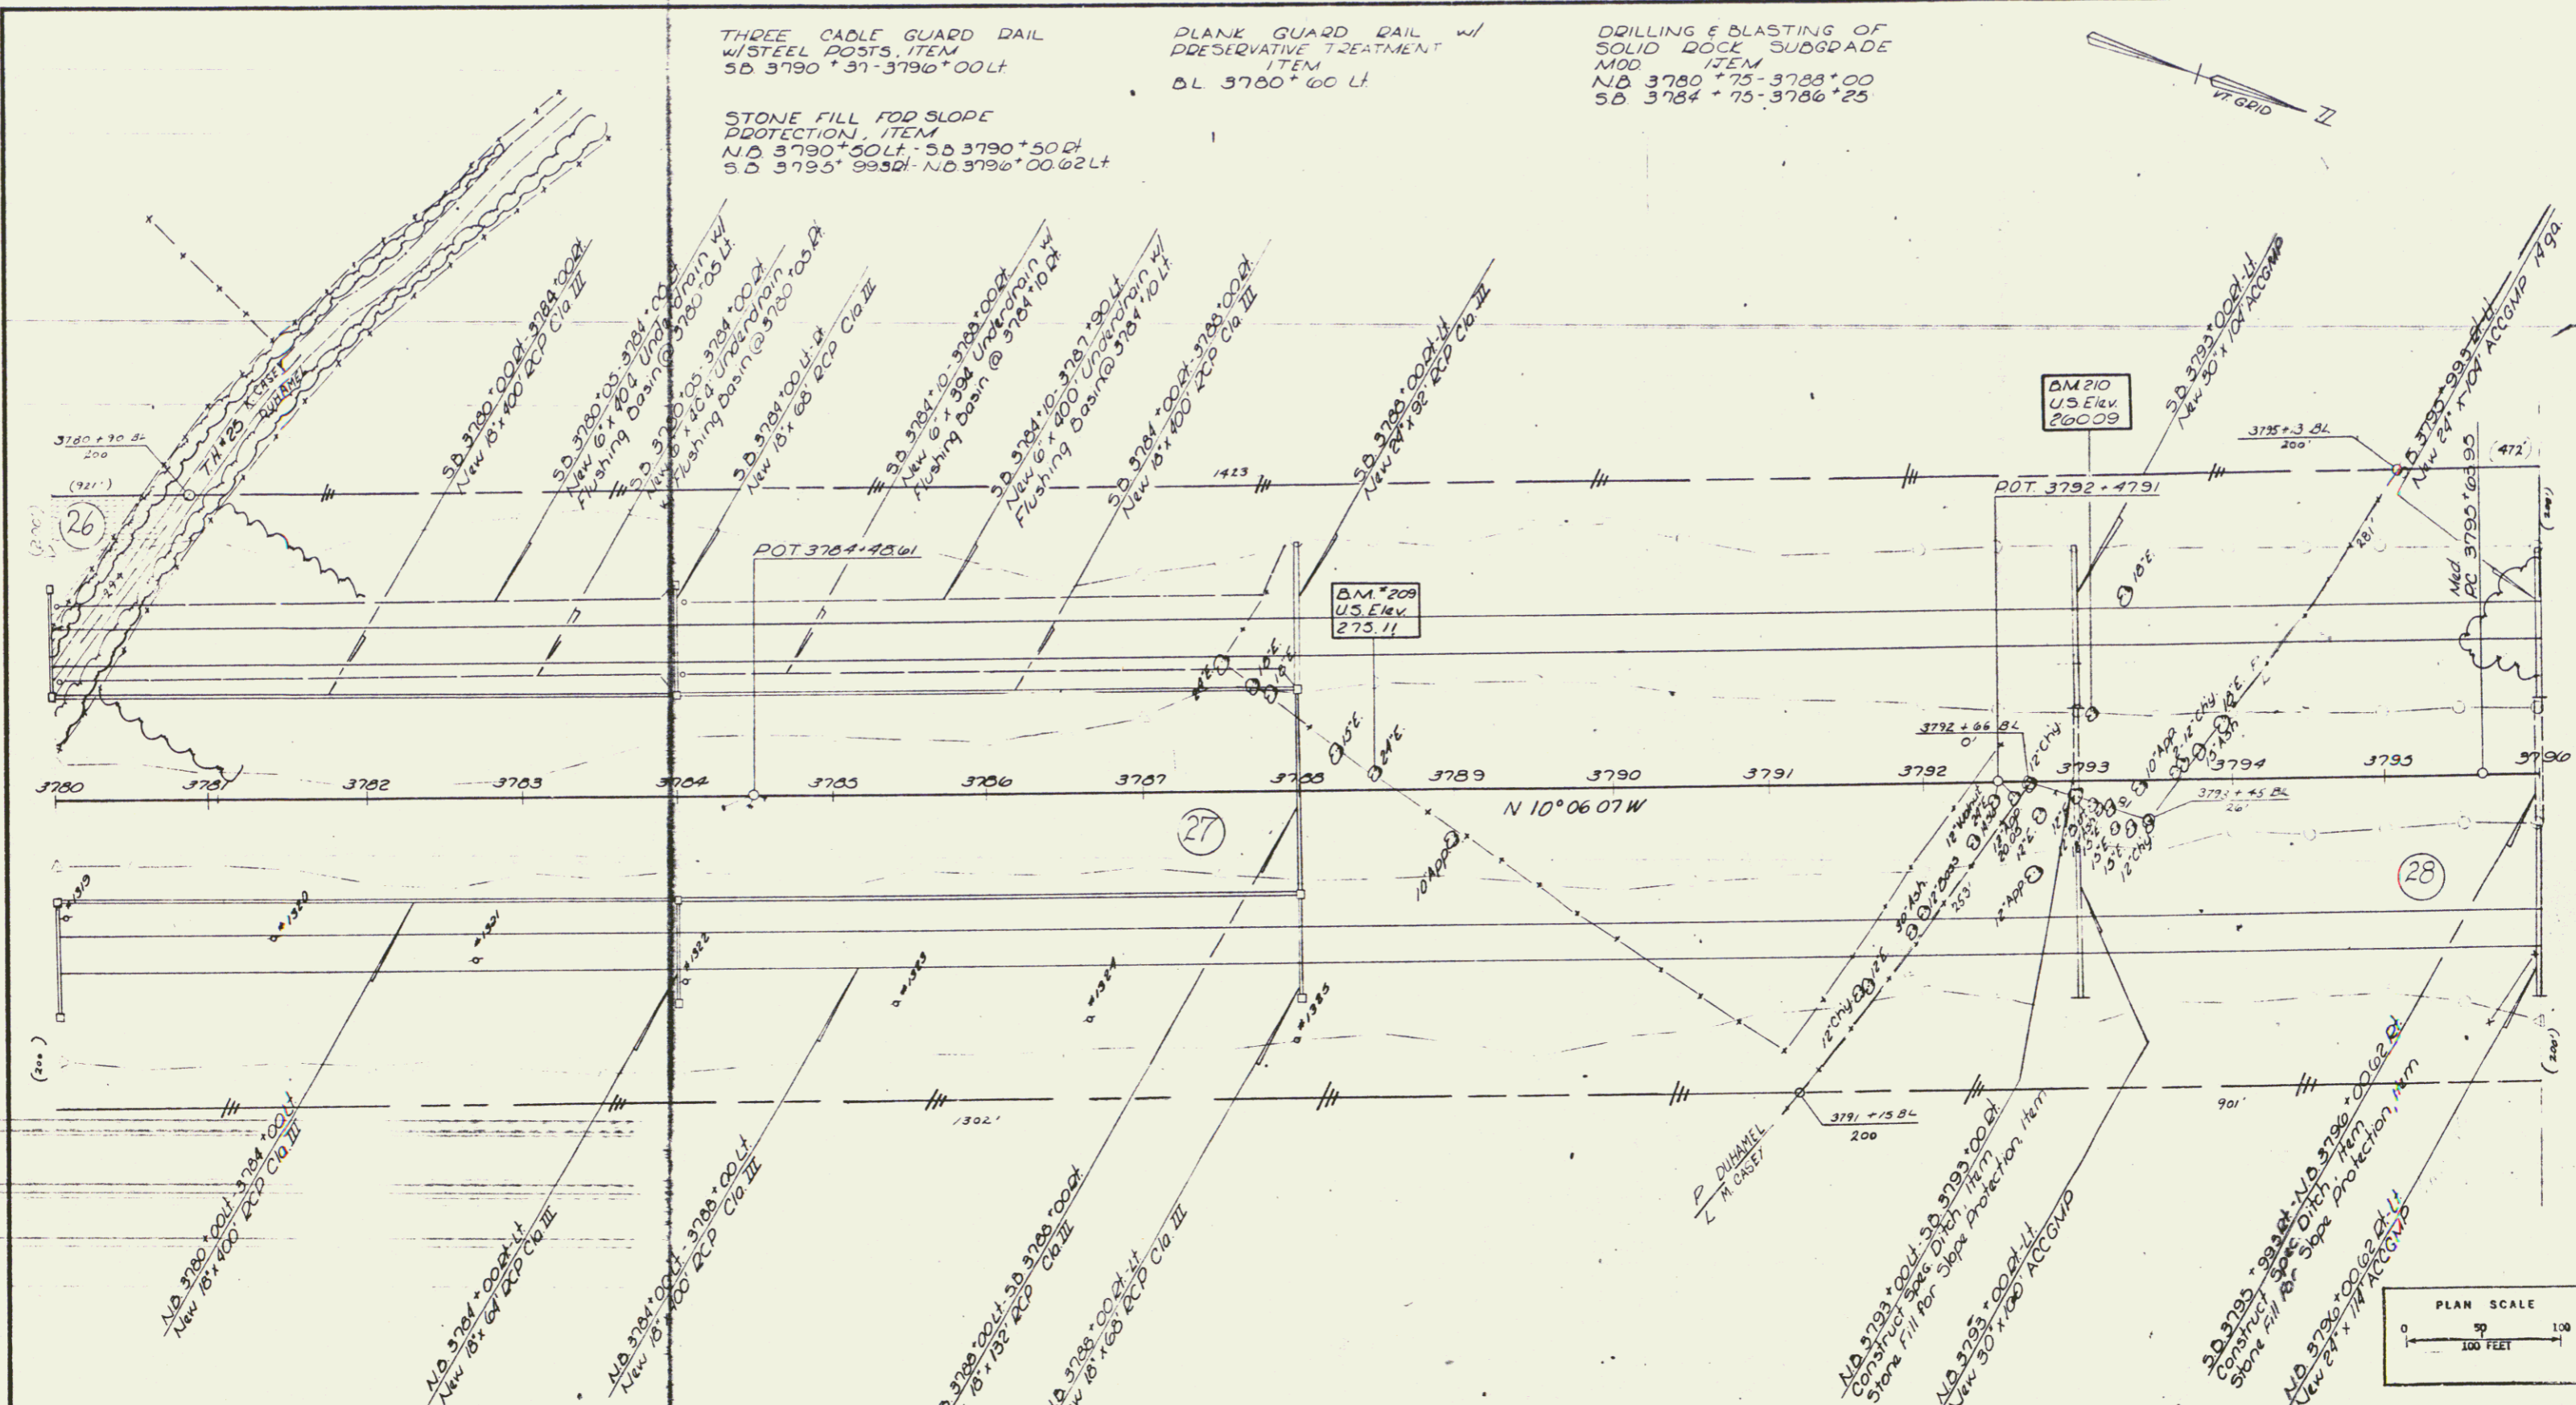

VERMONT DEPARTMENT OF HIGHWAYS
 RIGHT-OF-WAY PLANS
 PROJECT: ST. ALBANS SWANTON
 NO. 13
 SHEET: 45 OF 88