


189-3( )  
3800+00.00  
58 3796+00 - 3796+61 Lt

DRILLING & BLASTING OF SOLID ROCK SUBGRADE  
ITEM  
58 3806+50 - 3812+00

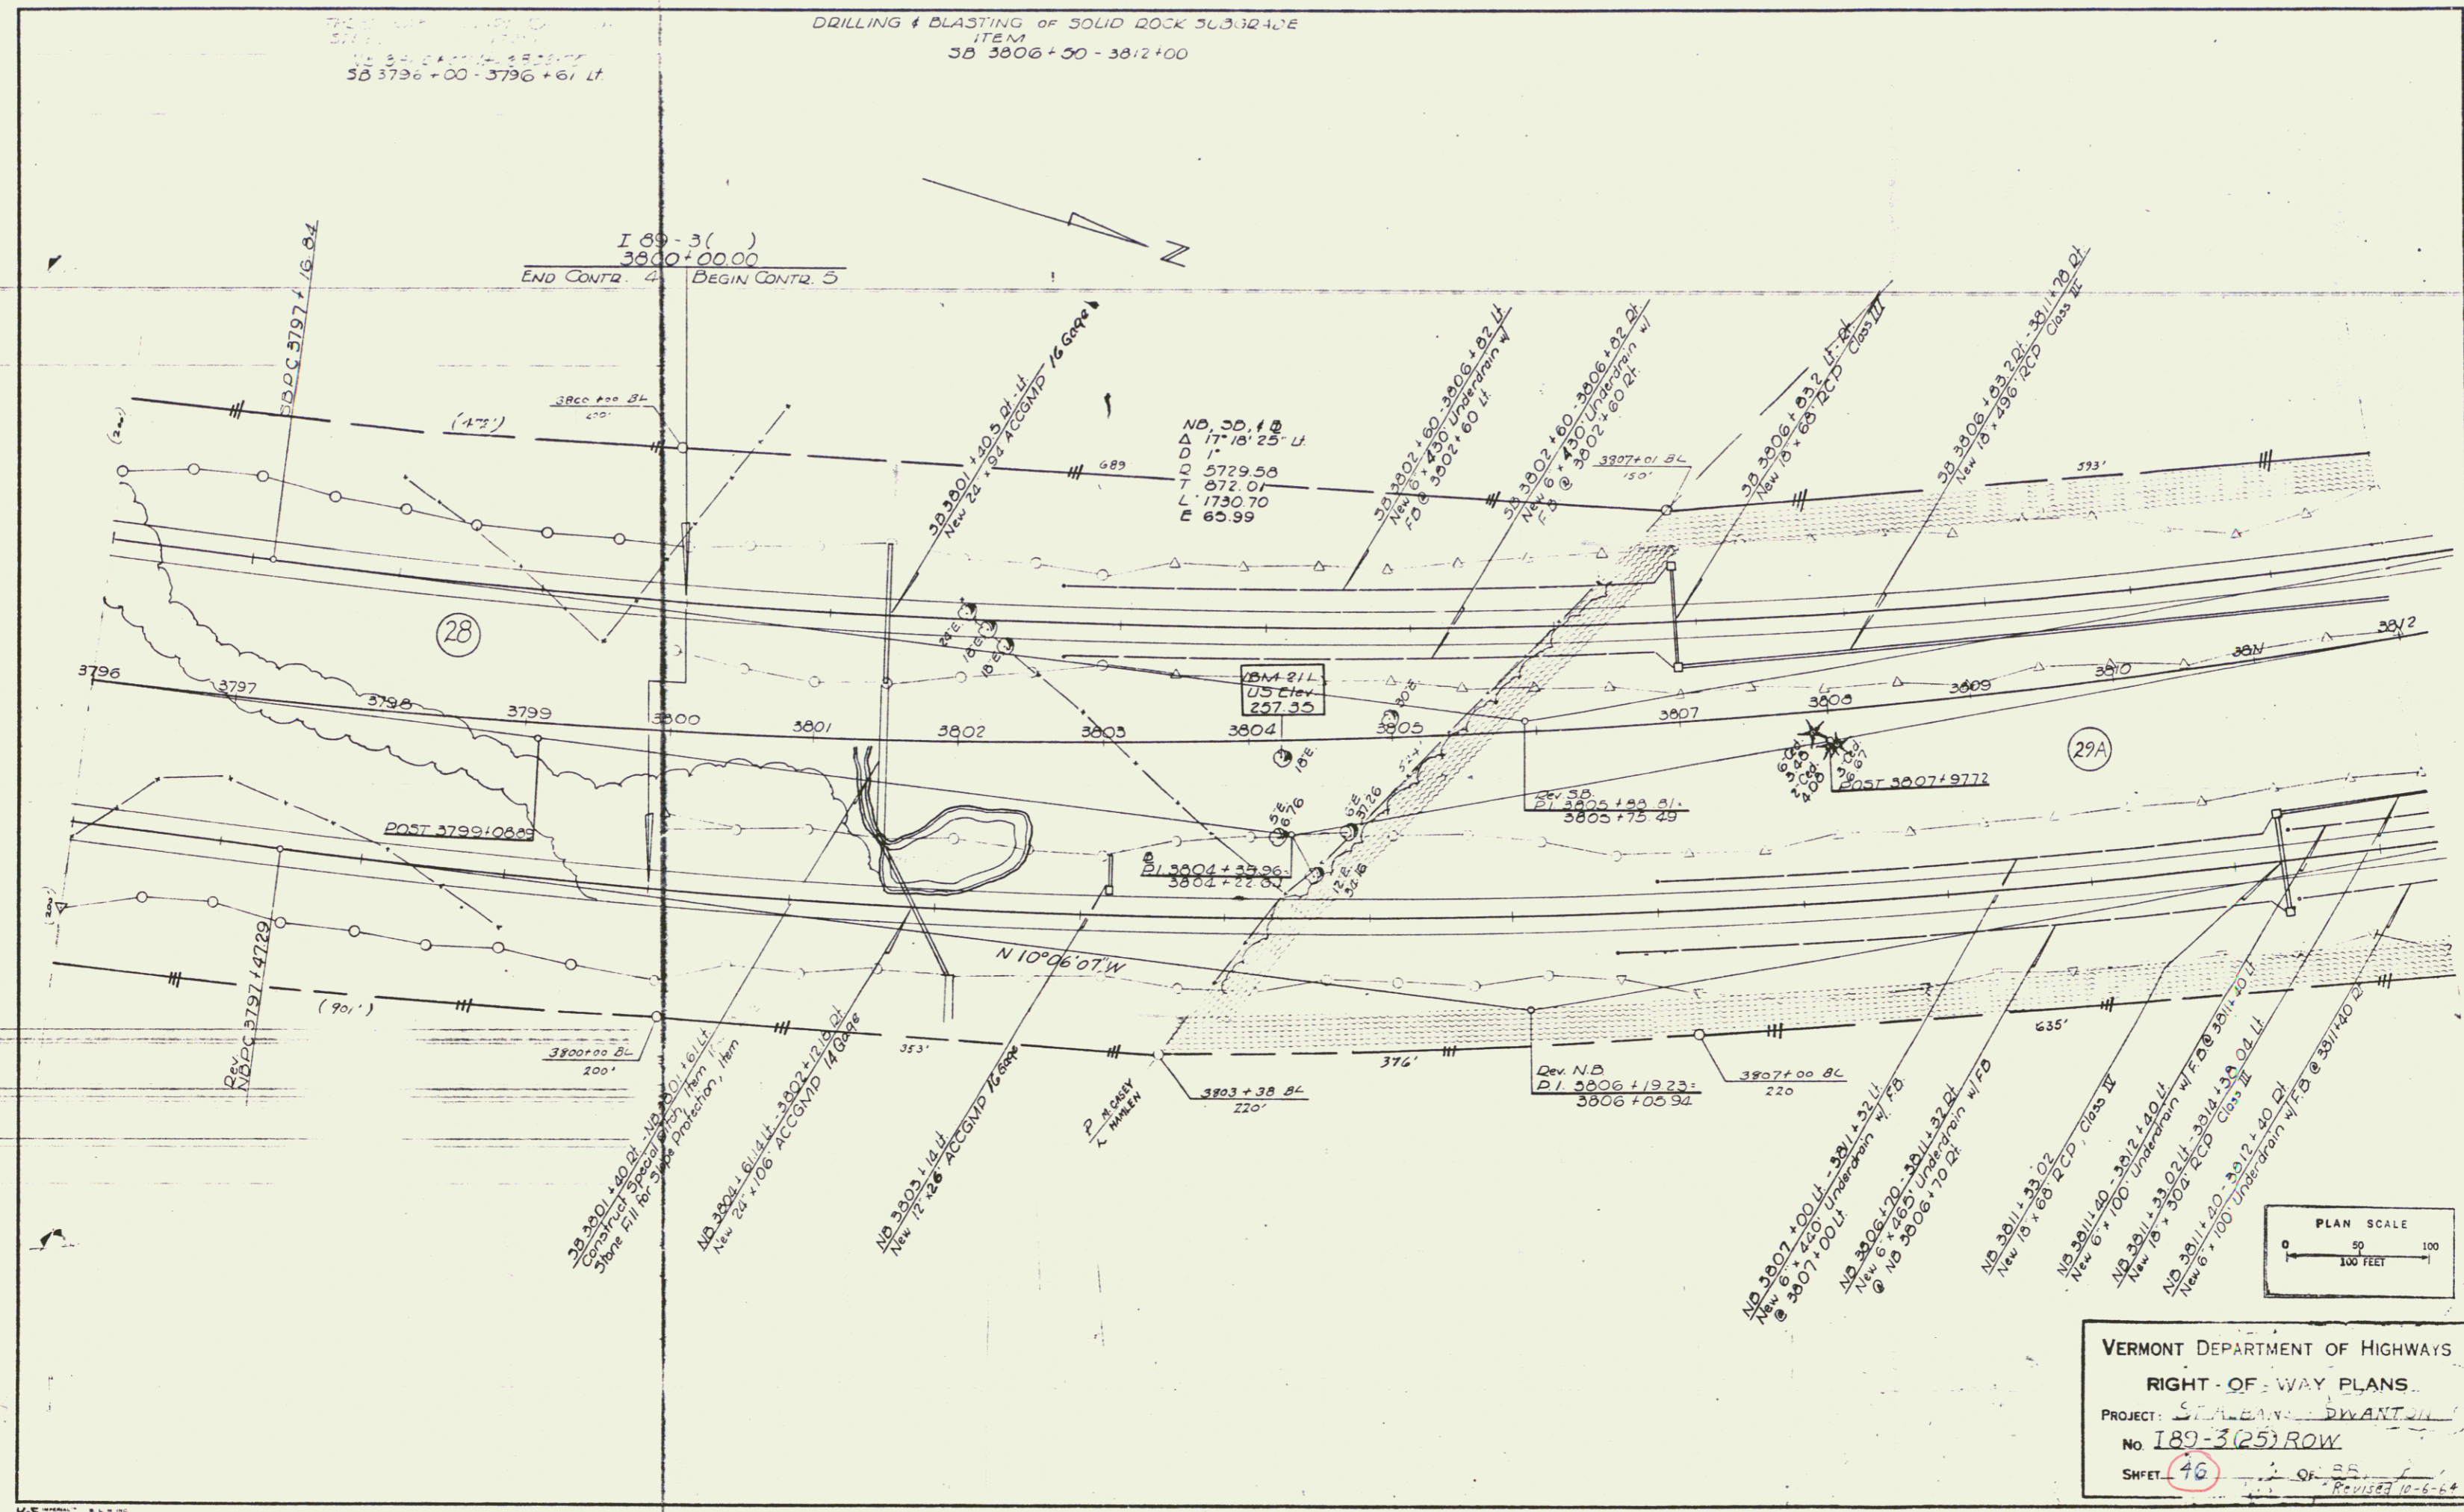

VERMONT DEPARTMENT OF HIGHWAYS  
RIGHT-OF-WAY PLANS  
PROJECT: STATE Rte. DWANTON  
No. 189-3(25) ROW  
SHEET 46 OF 85  
Revised 10-6-64

44