


THREE CABLE GUARD RAIL WITH  
STEEL POSTS, ITEM  
 SB 3815 + 37 LF - 3824 + 49 LF  
 SB 3826 + 01 LF - 3828 + 00 LF  
 SB 3816 + 01 LF - 3822 + 49 LF  
 SB 3826 + 01 LF - 3828 + 00 LF  
 NB 3816 + 49 LF - 3822 + 49 LF  
 NB 3826 + 01 LF - 3828 + 00 LF  
 NB 3815 + 09 LF - 3824 + 49 LF  
 NB 3826 + 01 LF - 3828 + 00 LF

DRILLING & BLASTING OF SOLID ROCK  
SUBGRADE  
 SB 3812 + 00 - 3813 + 00  
 NB 3812 + 00 - 3814 + 50

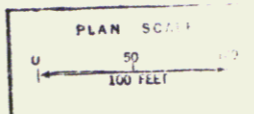


**VERMONT DEPARTMENT OF HIGHWAYS**  
**RIGHT-OF-WAY PLANS**  
 PROJECT: ST. ALBANS - SWANTON  
 NO: 187-3-25 ROW  
 SHEET: 47 OF 48

BEGIN RELINQUISHMENT NO. I  
 S.A. 3 2+75¢ (185')

END RELINQUISHMENT NO. I  
 BEGIN MAINT. AGREE. AREA NO. I  
 S.A. 3 4+60¢ (398')

END MAINT. AGREE. AREA NO. I  
 BEGIN RELINQUISHMENT NO. II  
 S.A. 3 8+58¢ (217')

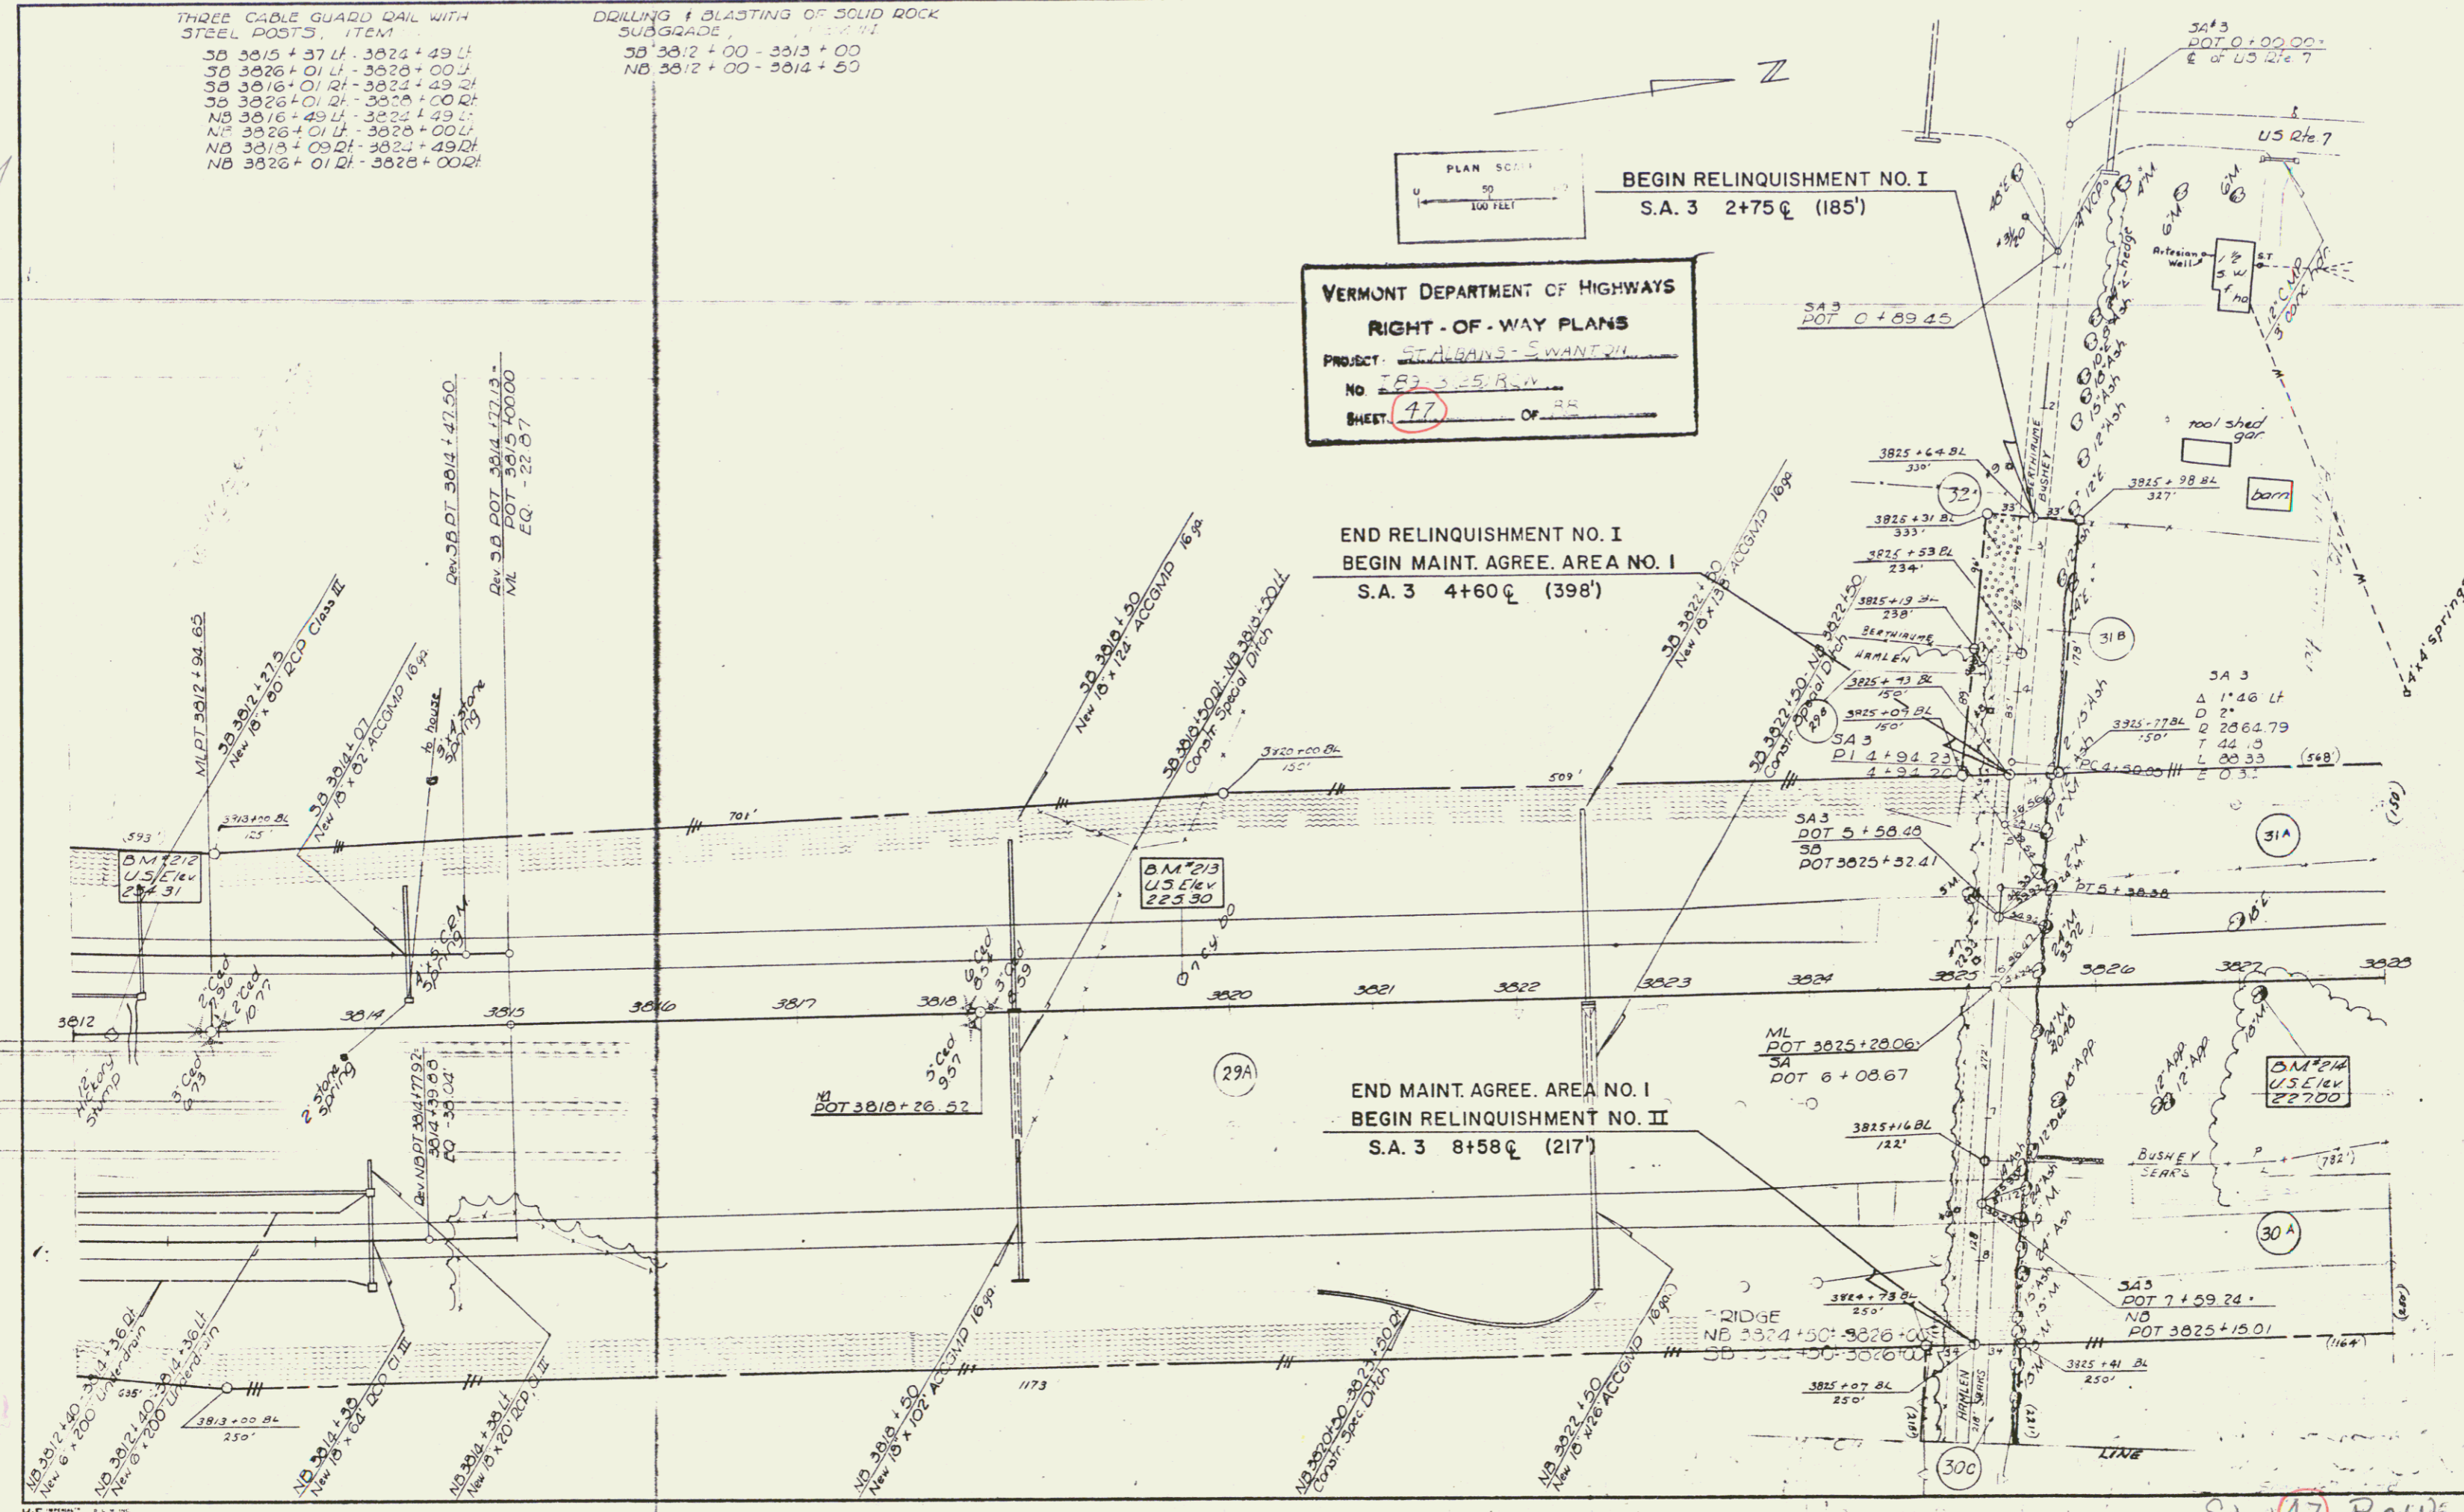

Sheet 47 ROW  
 187-3(25)  
 45