
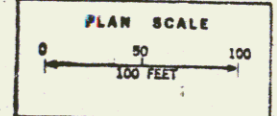


THREE CABLE GUARD RAIL  
W/ STEEL POSTS, ITEM  
S.D. 3860+00 LT-3860+63.3 LT  
S.D. 3864+31 LT-3865 73.45 LT

DRILLING & BLASTING OF SOLID  
ROCK, SUBGRADE, ITEM  
S.D. 3860+00-3865+73.43  
N.D. 3859+90-3865+73.43

DRILLING & BLASTING OF  
SOLID ROCK, ITEM  
S.D. 3860+00-38 3861+00  
S.D. 3864+30-38 3865+73.43

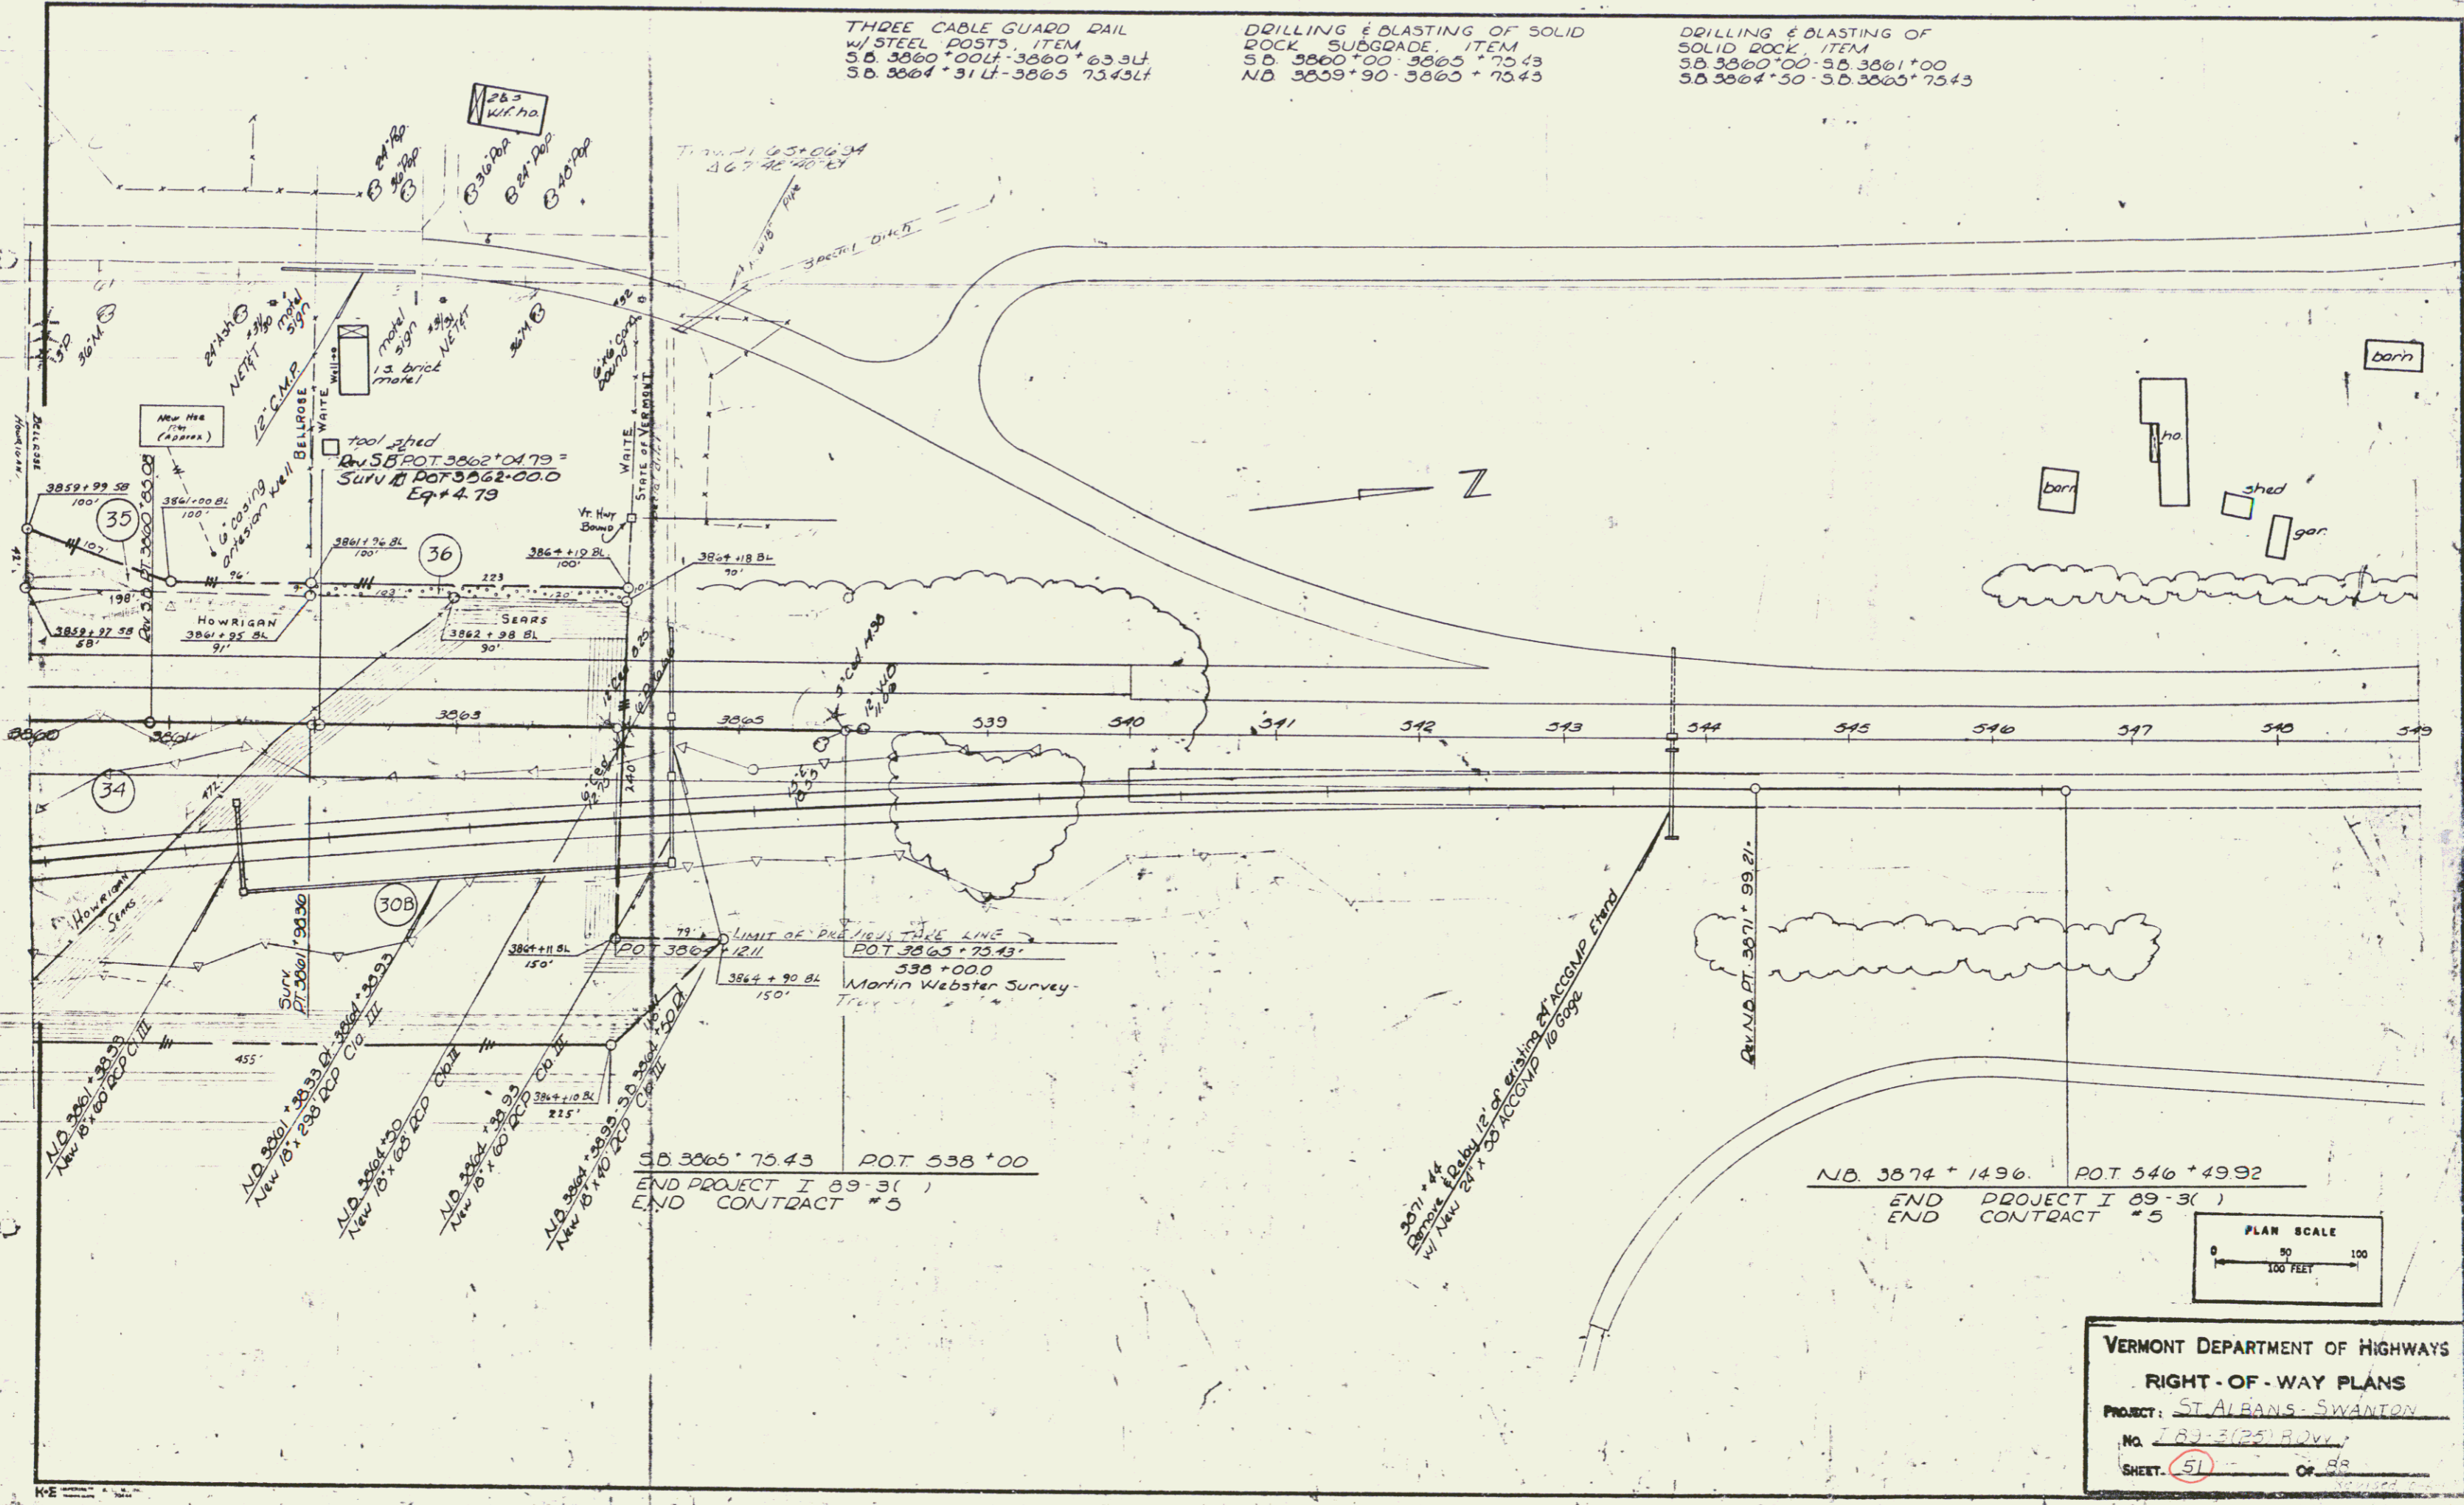

VERMONT DEPARTMENT OF HIGHWAYS  
RIGHT-OF-WAY PLANS  
PROJECT: ST ALBANS-SWANTON  
No. 787-3(25) R.O.W.  
SHEET: 51 OF 88

49