


PLAN	DATE
REVISIONS	BY
1	...
2	...
3	...
4	...
5	...
6	...
7	...
8	...
9	...
10	...

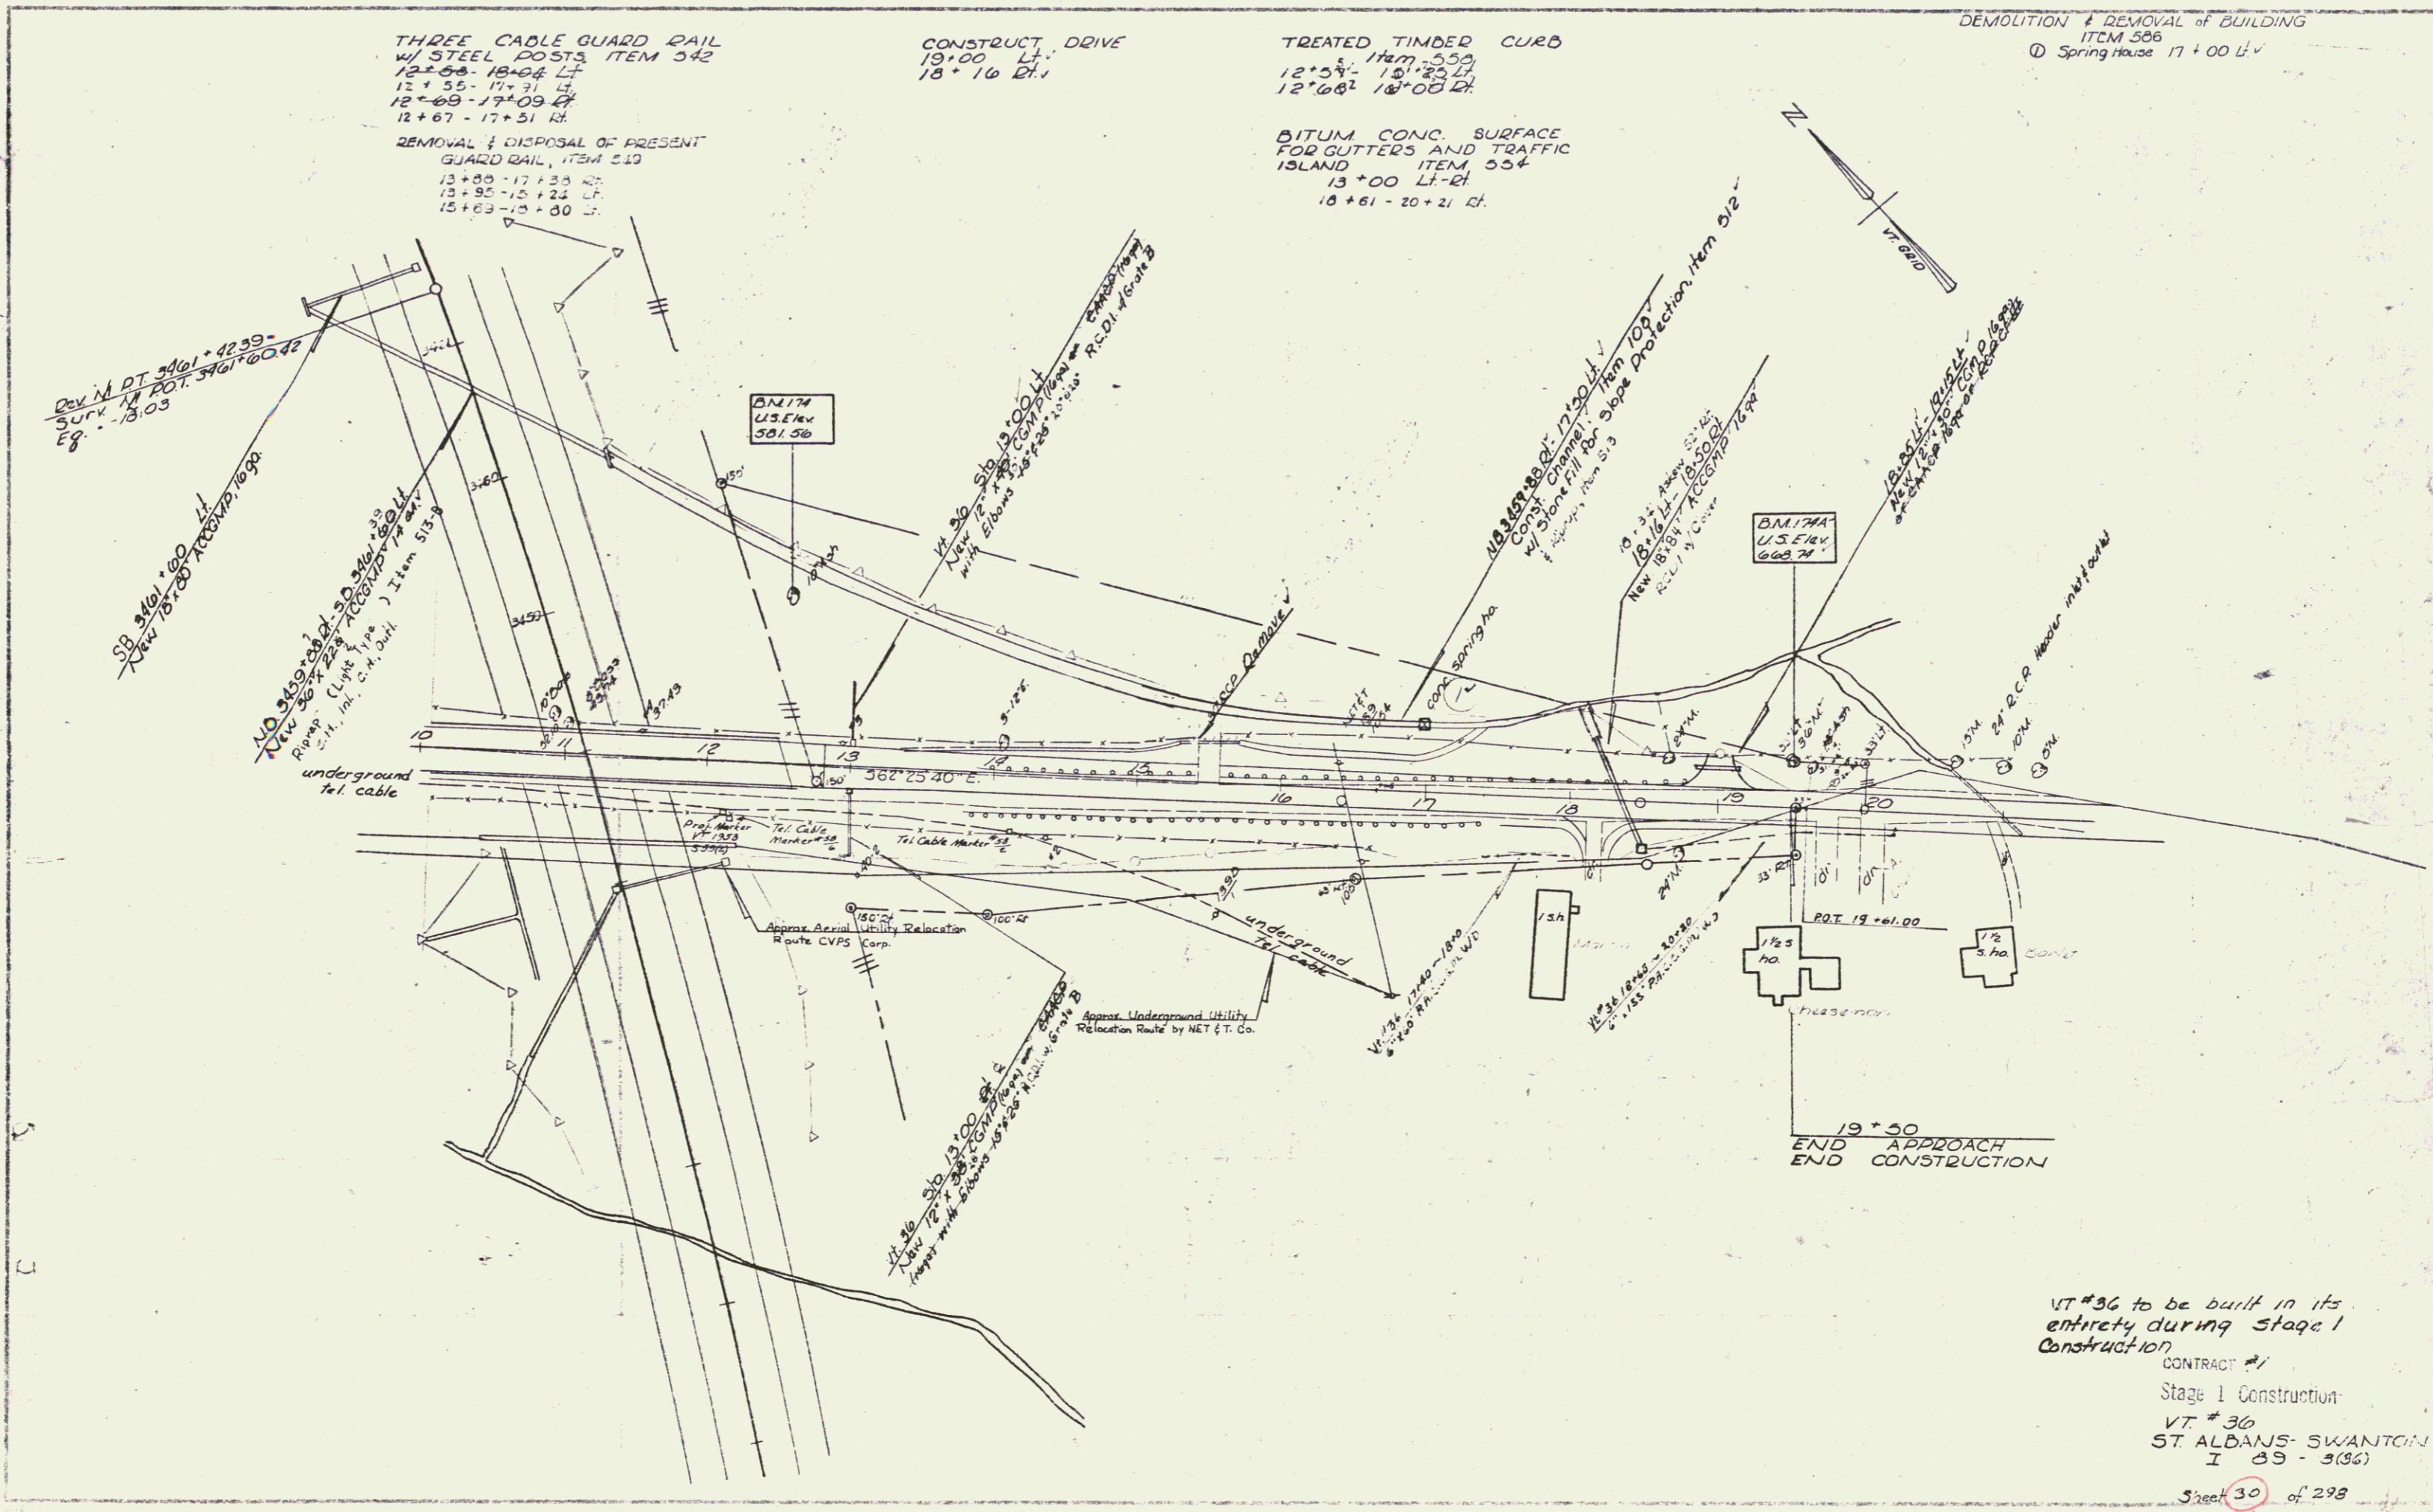

VT #36 to be built in its entirety during Stage 1 Construction

CONTRACT #1

Stage 1 Construction

VT #36

ST ALBANS-SWANTON

I 89 - 5(86)

Sheet 30 of 298