


\* BITUM-CONC. SURFACE FOR  
GUTTERS & TRAFFIC ISLANDS  
ITEM 554  
3461+25 - 3461+60 Med  
3463+25 - 3463+75 Med  
3465+25 - 3469+17 Med  
3474+60 - 3474+25 Med.

PROPERTY LINE FENCE, ITEM 553-II, MOD.  
3460+00 - 3476+00 LI & DI.

STA.	LOC.	OFFSET	DESCRIPT.
BL 3460+00	LT	750'	DRILLED WELL
BL 3463+00	LT	800'	DRILLED WELL

PLAN	DATE	BY
REVISED		
NO.		

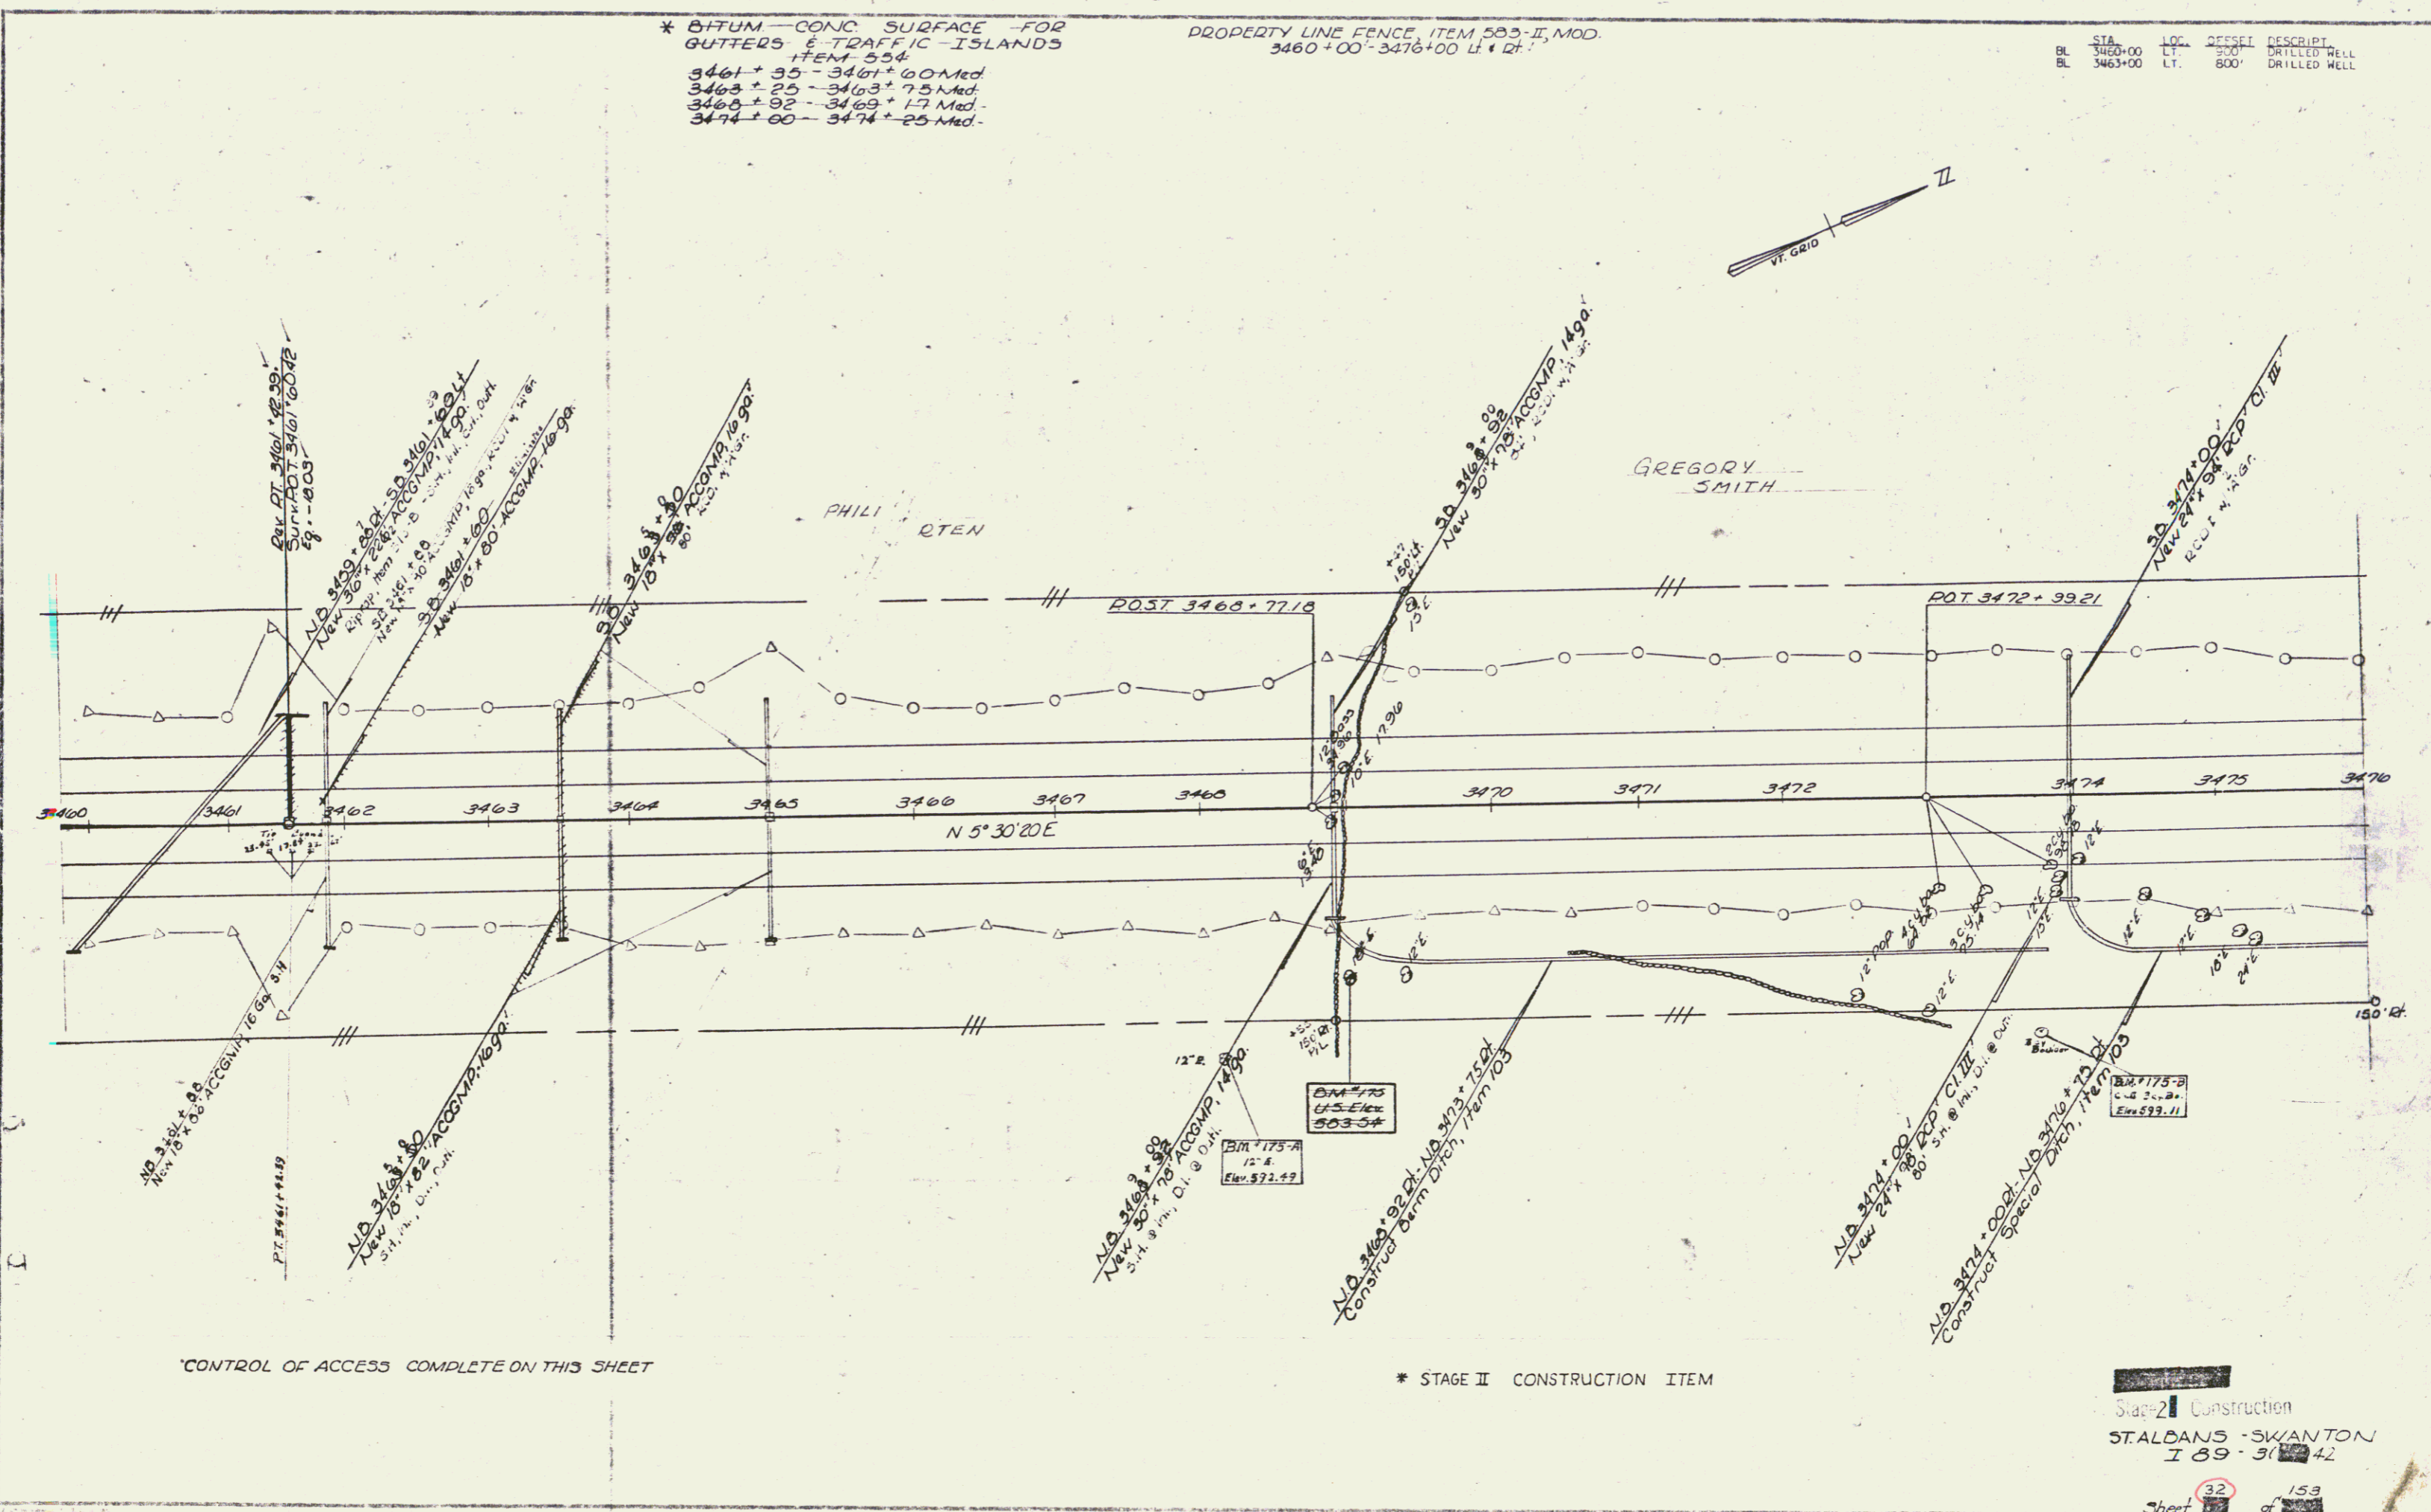

'CONTROL OF ACCESS COMPLETE ON THIS SHEET'

\* STAGE II CONSTRUCTION ITEM

Stage 2 Construction  
STALBANS - SWANTON  
I 89 - 31-22-42  
Sheet 32 of 153

52