

PLAN
 SURVEYED
 BY
 DATE
 R.O.W. CHECKED
 NO.



* STAGE II CONSTRUCTION ITEM

* BITUMINOUS CONC. SURFACE
 FOR GUTTERS & TRAFFIC
 ISLANDS ITEM 354
 3508 ± 75 - 3509 ± 00 Med.
 3511 ± 21 - 3511 ± 46 Med.
 3510 ± 75 - 3516 ± 00 Med.
 3519 ± 75 - 3520 ± 00 Med.

PROPERTY LINE FENCE
 ITEM 303-II, MOD
 3508 ± 00 - 3524 ± 00 Lt.

BM 179
 24' ± 317 ± 0
 E. 578.71

STA.	LOC.	OFFSET	DESCRIPT.
BL 3509+00	RT.	1700'	SPRING BOX
BL 3510+00	RT.	1700'	SPRING BOX
BL 3511+00	RT.	1700'	SPRING BOX
BL 3512+00	RT.	1300'	SPRING BOX
BL 3514+00	RT.	1200'	WELL
BL 3518+00	RT.	1700'	SPRING BOX
BL 3519+00	RT.	1700'	SPRING BOX
BL 3520+00	RT.	1700'	SPRING BOX
BL 3522+00	RT.	1800'	SPRING BOX

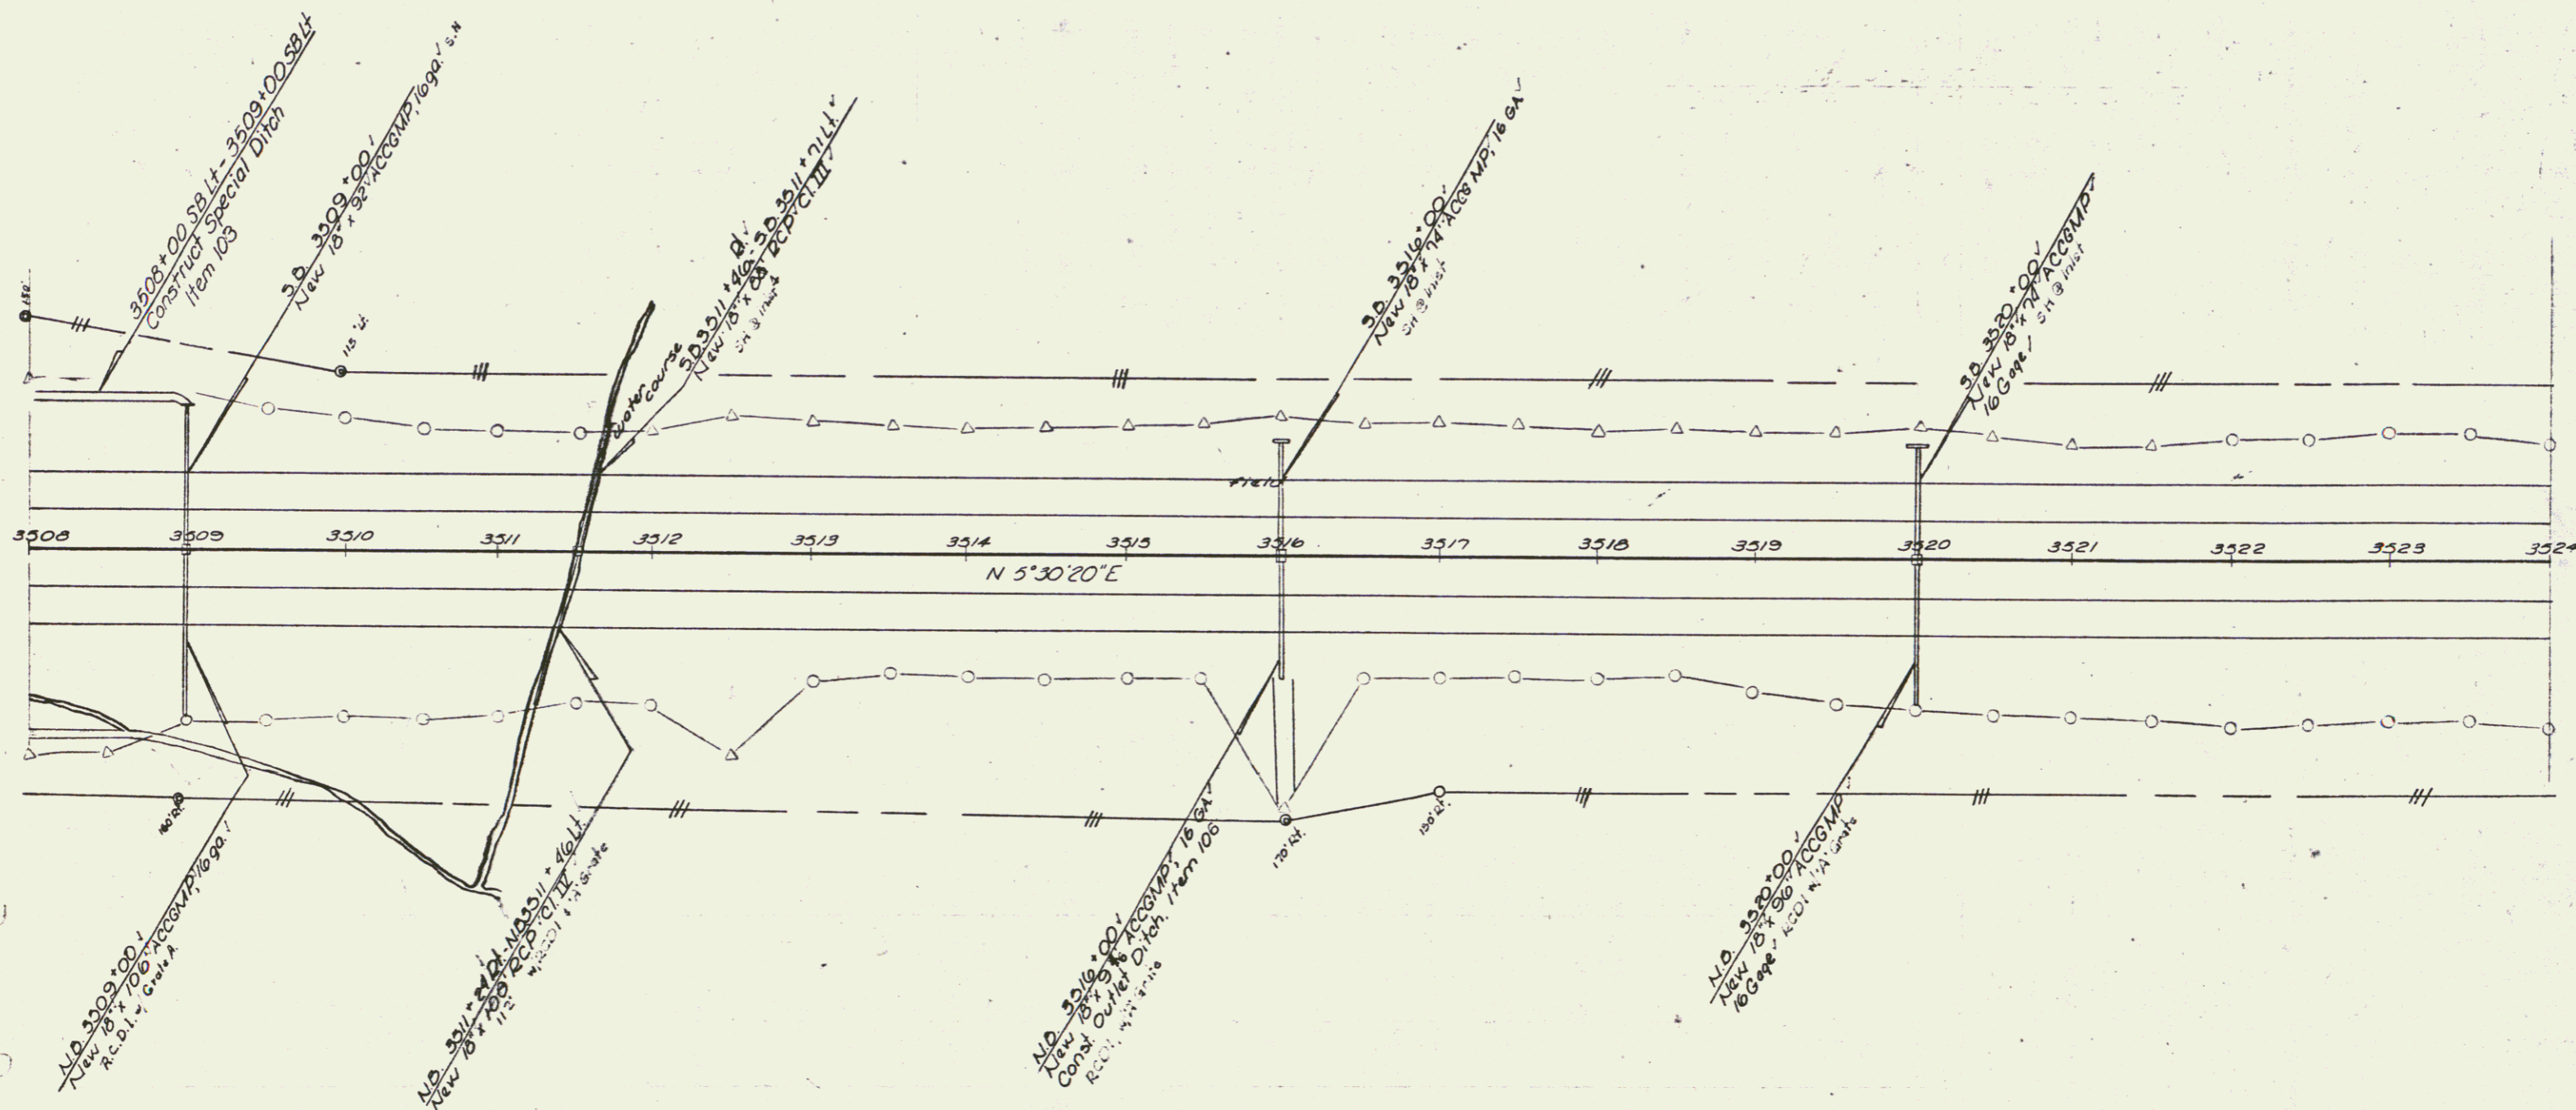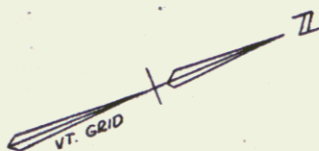

BM 179
 U.S. 64
 578.70

3513 + 60
 397 from E Lt.

Stage II Construction
 ST. ALBANS - SWANTON
 I 89 - 30442

CONTROL OF ACCESS COMPLETE ON THIS SHEET Sheet 38 of 153