

CONSTRUCT U TURN
 @ B.L. 3525+85


* BITUM CONC SURFACE FOR
 GUTTERS & TRAFFIC ISLANDS
 ITEM 554
 3525+26-3525+51 Med
 3528+75-3529+00 Med
 3532+75-3533+00 Med
 3536+75-3537+00 Med

PROPERTY LINE FENCE
 ITEM 503-II, MOD
 3524+00-3540+00 L+R

STA.	LOC.	OFFSET	DESCRIPTION
BL 3532+00	LT.	1500'	DUG SPRING
BL 3534+00	RT.	1500'	FARM POND
BL 3535+00	RT.	1500'	DUG SPRING
BL 3536+00	RT.	1400'	DUG WELL
BL 3540+00	LT.	600'	DUG WELL

* STAGE II CONSTRUCTION ITEM

DATE	BY	DESCRIPTION

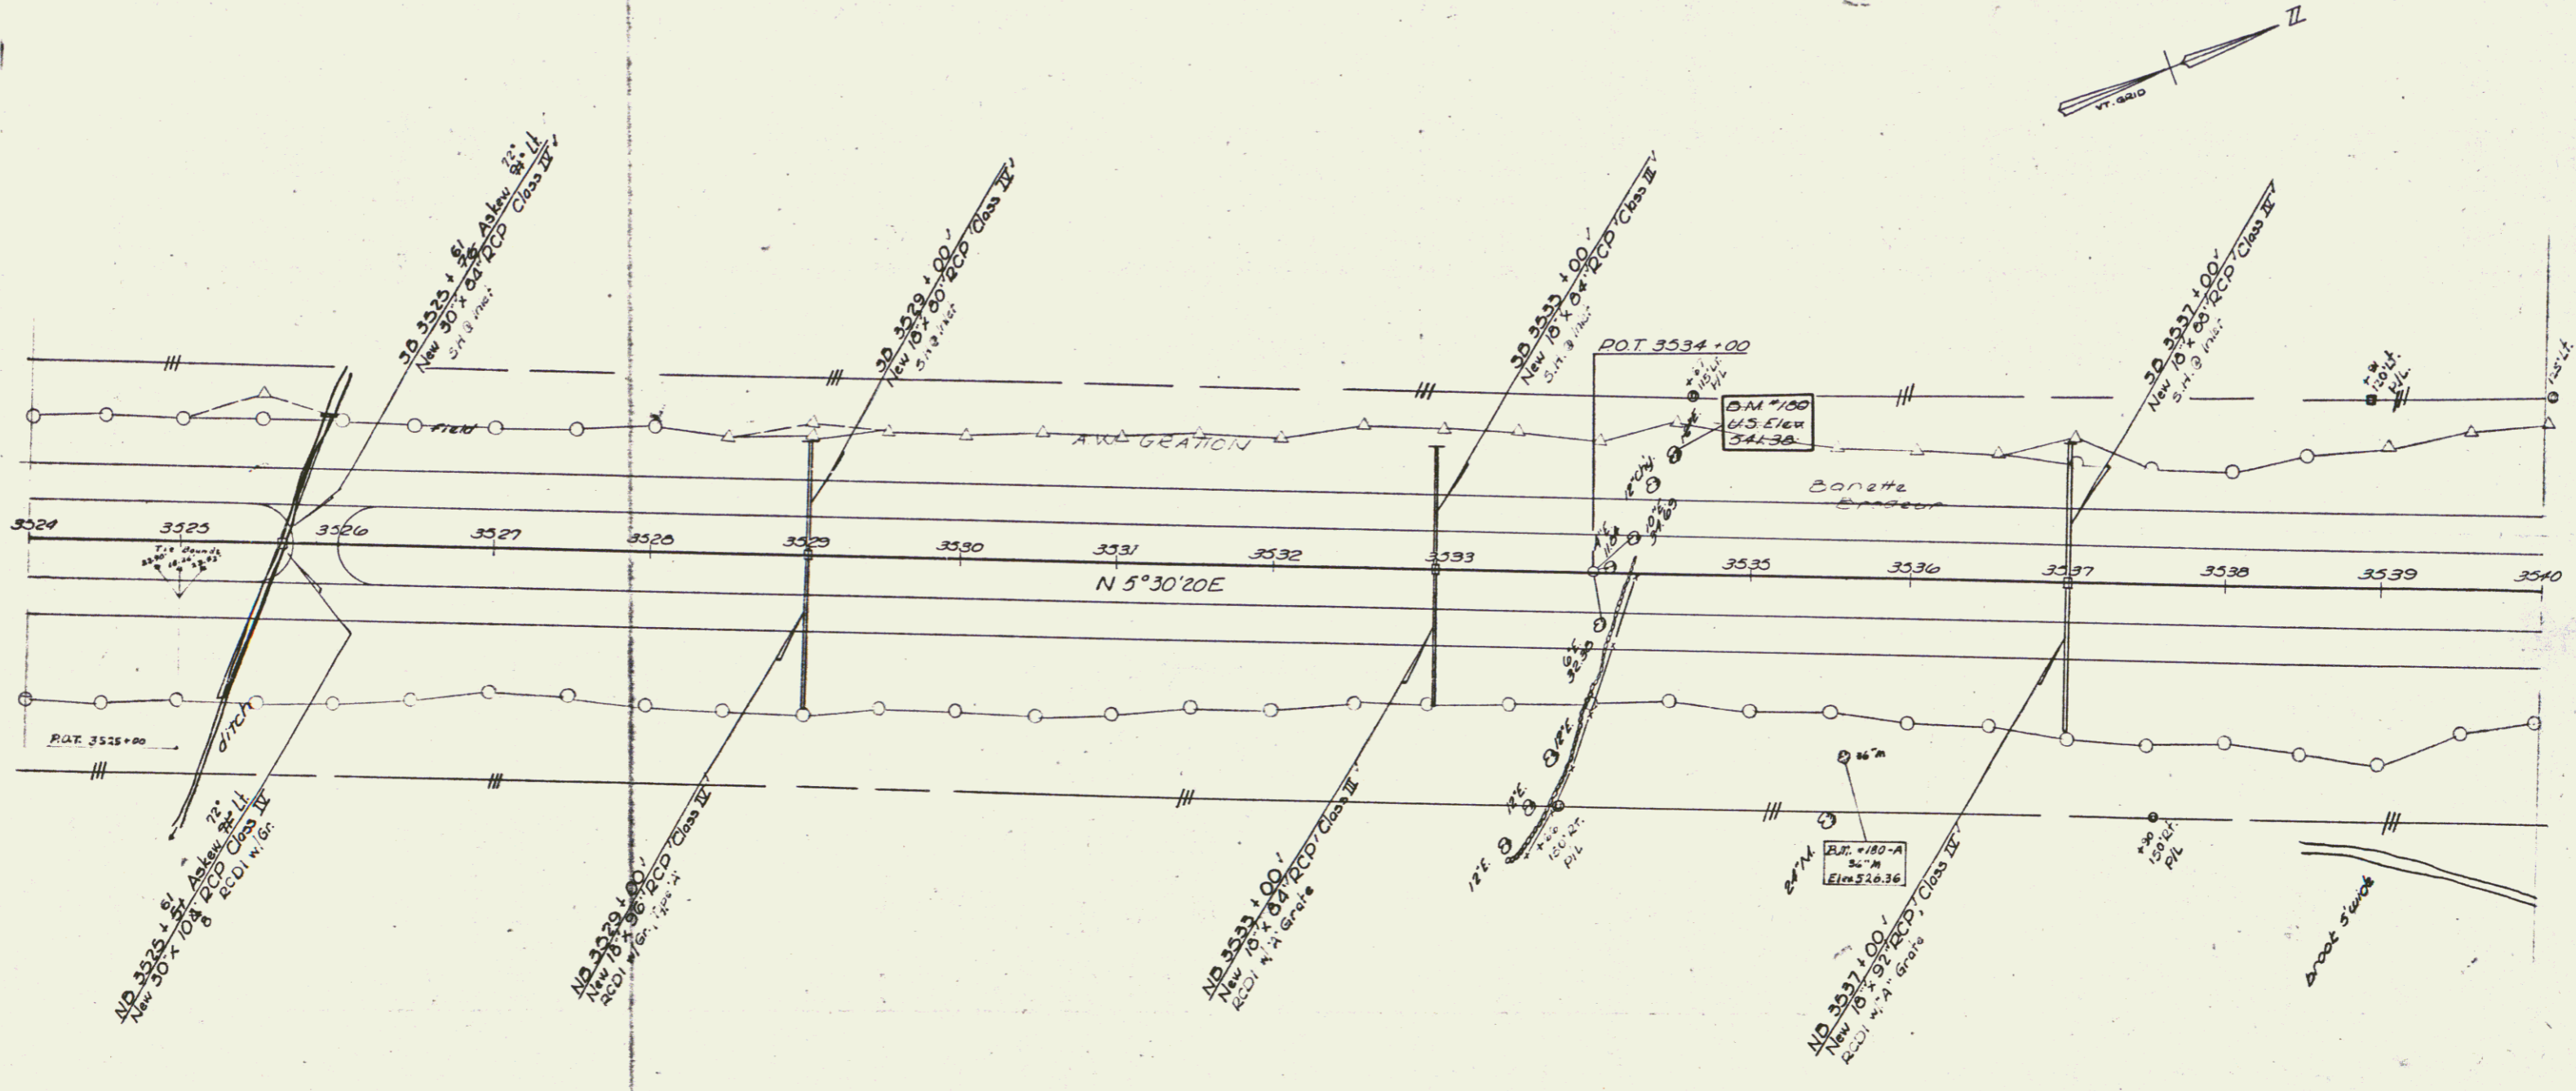

Control of Access is complete on this sheet

Stage II Construction
 ST. ALBANS-SWANTON
 I 89 - 3 (1991) 42
 Sheet 47 of 153