

* THREE CABLE GUARD RAIL
W/ LIGHT STEEL POSTS, ITEM 538
N.D. 3588+00 - 3603+00 Lf
S.D. 3588+00 - 3603+00 Lf
83

DIP RAP FOR BANK PROTECTION
MOD FOR CULVERT ENDS, ITEM 53B
N.D. 3604+00 Lf

TREATED TIMBER CURB, ITEM 558
SB 3588+00 - 3592+03



* BITUM CONC CURB
ITEM 555
SB 3588+00 - 3592+04 Lf

PROPERTY LINE FENCE
ITEM 503-II, MOD
3588+00 Lf - 3604+00 Lf
3588+00 Rf - 3604+00 Rf

* BITUM CONC SURF FOR
GUTTERS AND TRAFFIC
ISLANDS ITEM 554
3591+75 - 3592+00 Med
3595+75 - 3596+00 Med
3599+75 - 3600+00 Med
3602+92 - 3603+17 Med
SB 3588+00 - 3592+03 Lf

* STAGE II CONSTRUCTION ITEM

PLAN	DATE	BY	CHKD
STAGE II CONSTRUCTION	11/11/03	ALBERT D'AMICO	ALBERT D'AMICO
DATE	BY	CHKD	
11/11/03	ALBERT D'AMICO	ALBERT D'AMICO	

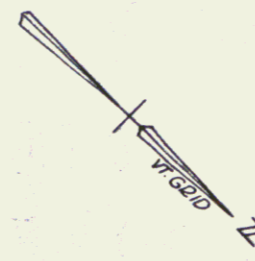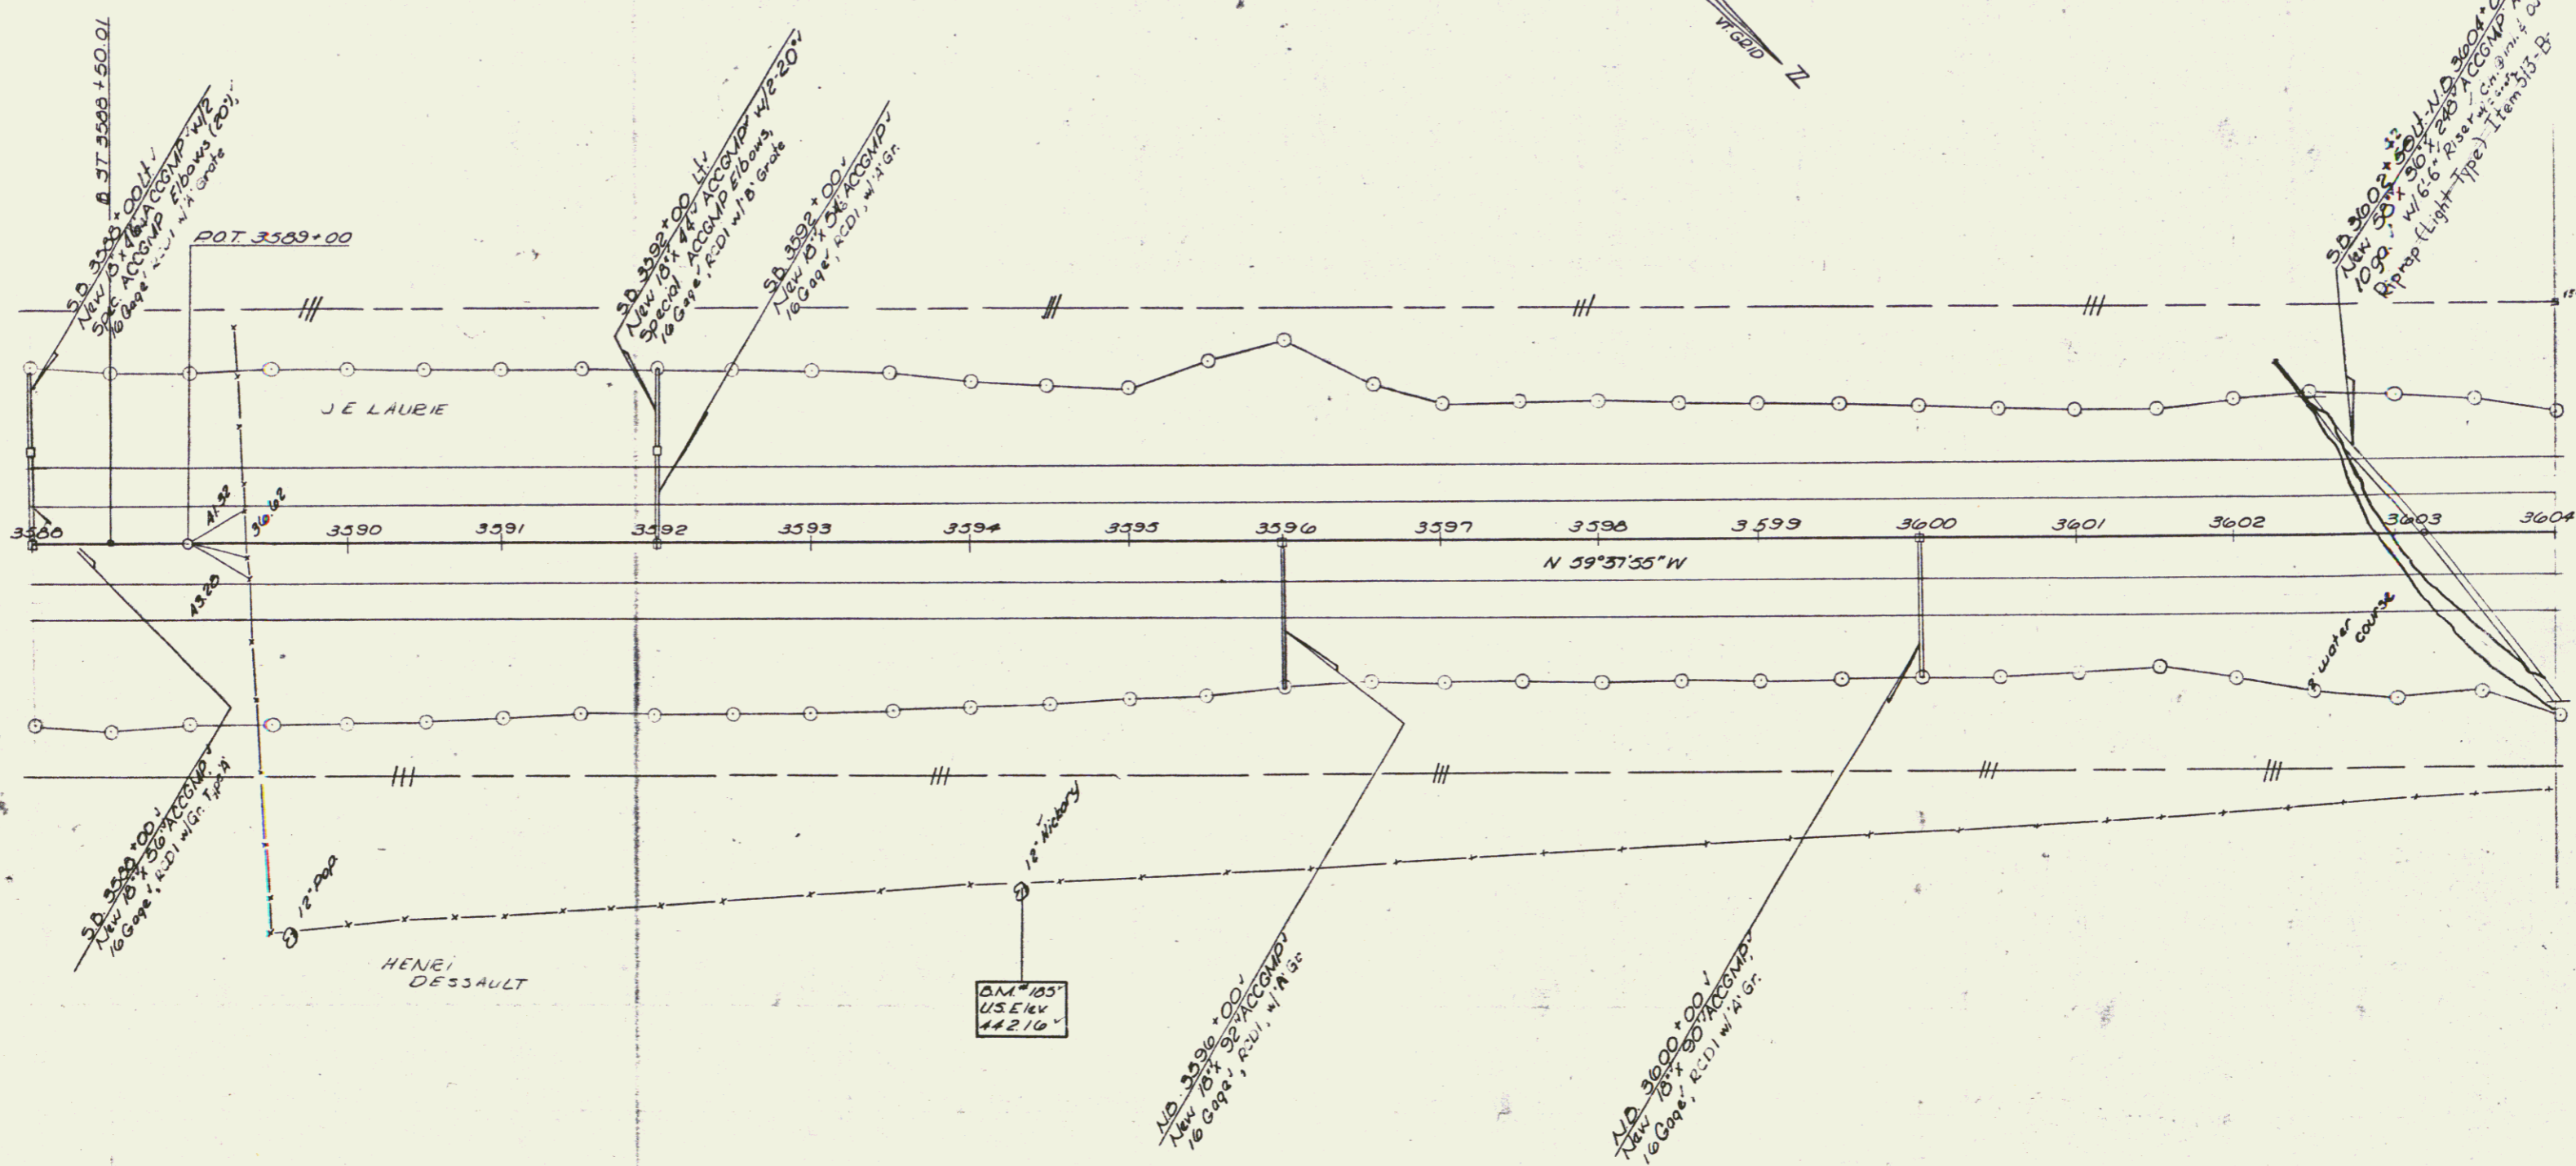

Stage II Construction
ST ALBANS - SWANTON
I 89-3042
Sheet 49 of 53

CONTROL OF ACCESS COMPLETE
ON THIS SHEET