


STATE OF VERMONT
 DEPARTMENT OF HIGHWAYS
Proposed Improvement
 INTERSTATE PROJECT
TOWNS OF ST. ALBANS--SWANTON
 COUNTY OF FRANKLIN
 INTERSTATE ROUTE 89
 BURLINGTON-PHILIPSBURG, QUE. ROAD

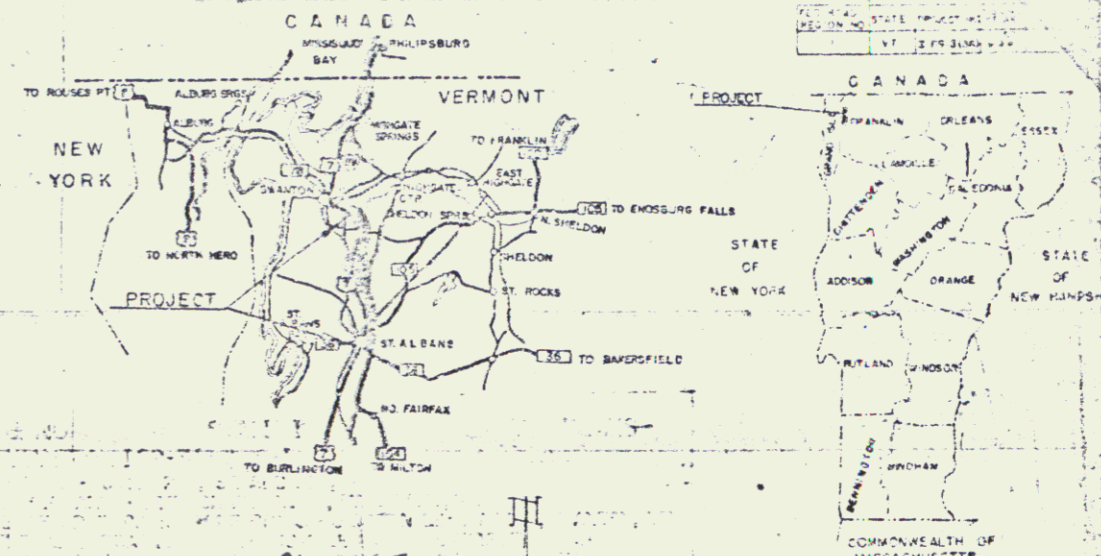


INDEX OF SHEETS

| | | | |
|------|-------------|---------|--|
| 1-10 | 1-10 Street | 101-102 | 101-315 & 101-316 Reinforcing Steel Schedule |
| 11 | 1-11 Street | 103 | 103-400 General Plan & Elevation |
| 12 | 1-12 Street | 104 | 104-401 Bridge Quantity Sheets |
| 13 | 1-13 Street | 105 | 105-402 Preliminary Info. Sheet |
| 14 | 1-14 Street | 106 | 106-403 Spring Layout |
| 15 | 1-15 Street | 107-109 | 107-404 thru 406 Spring Logs |
| 16 | 1-16 Street | 110 | 110-407 Framing Plan |
| 17 | 1-17 Street | 111 | 111-408 Curb & Railing Plan & Typical Bridge Section |
| 18 | 1-18 Street | 112-115 | 112-409 thru 412 Details of Abutments |
| 19 | 1-19 Street | 116 | 116-413 Details of Pier No. 1 & No. 2 |
| 20 | 1-20 Street | 117 | 117-414 Pier No. 1 & No. 2 Reinforcing Steel Details |
| 21 | 1-21 Street | 118-121 | 118-415 thru 418 Details of Approach Slabs |
| 22 | 1-22 Street | 122-123 | 122-419 & 123-420 Reinforcing Steel Schedule |
| 23 | 1-23 Street | 124-126 | 124-421 thru 423 Details of Approach Slabs |
| 24 | 1-24 Street | 127-128 | 127-424 & 128-425 Details of Approach Slabs |
| 25 | 1-25 Street | 129 | 129-426 Typical for Slopes in Solid Rock Area |
| 26 | 1-26 Street | 130 | 130-427 Drilling & Blasting of Solid Rock Subgrade |
| 27 | 1-27 Street | 131 | 131-428 Typical slope grading |
| 28 | 1-28 Street | 132 | 132-429 Muck Excavation, Item 117 |
| 29 | 1-29 Street | 133 | 133-430 Embankment on a Slope |
| 30 | 1-30 Street | 134 | 134-431 Use of Underdrain/Shoulder Rock Subgrade |
| 31 | 1-31 Street | 135 | 135-432 Stone Road Intersection |
| 32 | 1-32 Street | 136 | 136-433 Stone Intersection |
| 33 | 1-33 Street | 137 | 137-434 Interceptor Ditch |
| 34 | 1-34 Street | 138 | 138-435 Interceptor & Silt Trap |
| 35 | 1-35 Street | 139 | 139-436 Interceptor & Silt Trap |
| 36 | 1-36 Street | 140 | 140-437 Curb & Railing |
| 37 | 1-37 Street | 141 | 141-438 Truncated Gutters |
| 38 | 1-38 Street | 142 | 142-439 Met. Elbows, etc. |
| 39 | 1-39 Street | 143 | 143-440 Joints |
| 40 | 1-40 Street | 144 | 144-441 PRECAST JCI Grate & Frame, Item 531 |
| 41 | 1-41 Street | 145 | 145-442 ACCUM Vertical Riser |
| 42 | 1-42 Street | 146 | 146-443 Barricades, Signs & Lights (Roadway) |
| 43 | 1-43 Street | 147 | 147-444 Barricades, Signs & Lights (Bridge) |
| 44 | 1-44 Street | 148 | 148-445 Federal Aid Construction Plant, Signs |
| 45 | 1-45 Street | 149 | 149-446 Property Line Marker, Item 563 |
| 46 | 1-46 Street | 150 | 150-447 Two Cable Guard Rails, Item 543 |
| 47 | 1-47 Street | 151 | 151-448 Two Cable Guard Rails, Item 543 |
| 48 | 1-48 Street | 152 | 152-449 Three Cable Guard Rails, Item 542 |
| 49 | 1-49 Street | 153 | 153-450 Three Cable Guard Rails, Item 542 |
| 50 | 1-50 Street | 154 | 154-451 Road & Steel Marker Posts, Item 547 |
| 51 | 1-51 Street | 155 | 155-452 Erection of Project Markers |
| 52 | 1-52 Street | 156 | 156-453 |
| 53 | 1-53 Street | 157 | 157-454 |
| 54 | 1-54 Street | 158 | 158-455 |
| 55 | 1-55 Street | 159 | 159-456 |
| 56 | 1-56 Street | 160 | 160-457 |
| 57 | 1-57 Street | 161 | 161-458 |
| 58 | 1-58 Street | 162 | 162-459 |
| 59 | 1-59 Street | 163 | 163-460 |
| 60 | 1-60 Street | 164 | 164-461 |
| 61 | 1-61 Street | 165 | 165-462 |

CONTRACT # 1
 BEGINNING AT A POINT 3.755 MILES SOUTHERLY OF THE ST. ALBANS-SWANTON TOWN LINE AND EXTENDING NORTHERLY 3.337 MILES.
 LENGTH OF ROADWAY 17,474.9 FEET = 3.310 MILES
 LENGTH OF BRIDGE 1430 FEET = 0.27 MILE
 LENGTH OF CONTRACT 17,617.90 FEET = 3.327 MILES

CONSTRUCTION PLANS

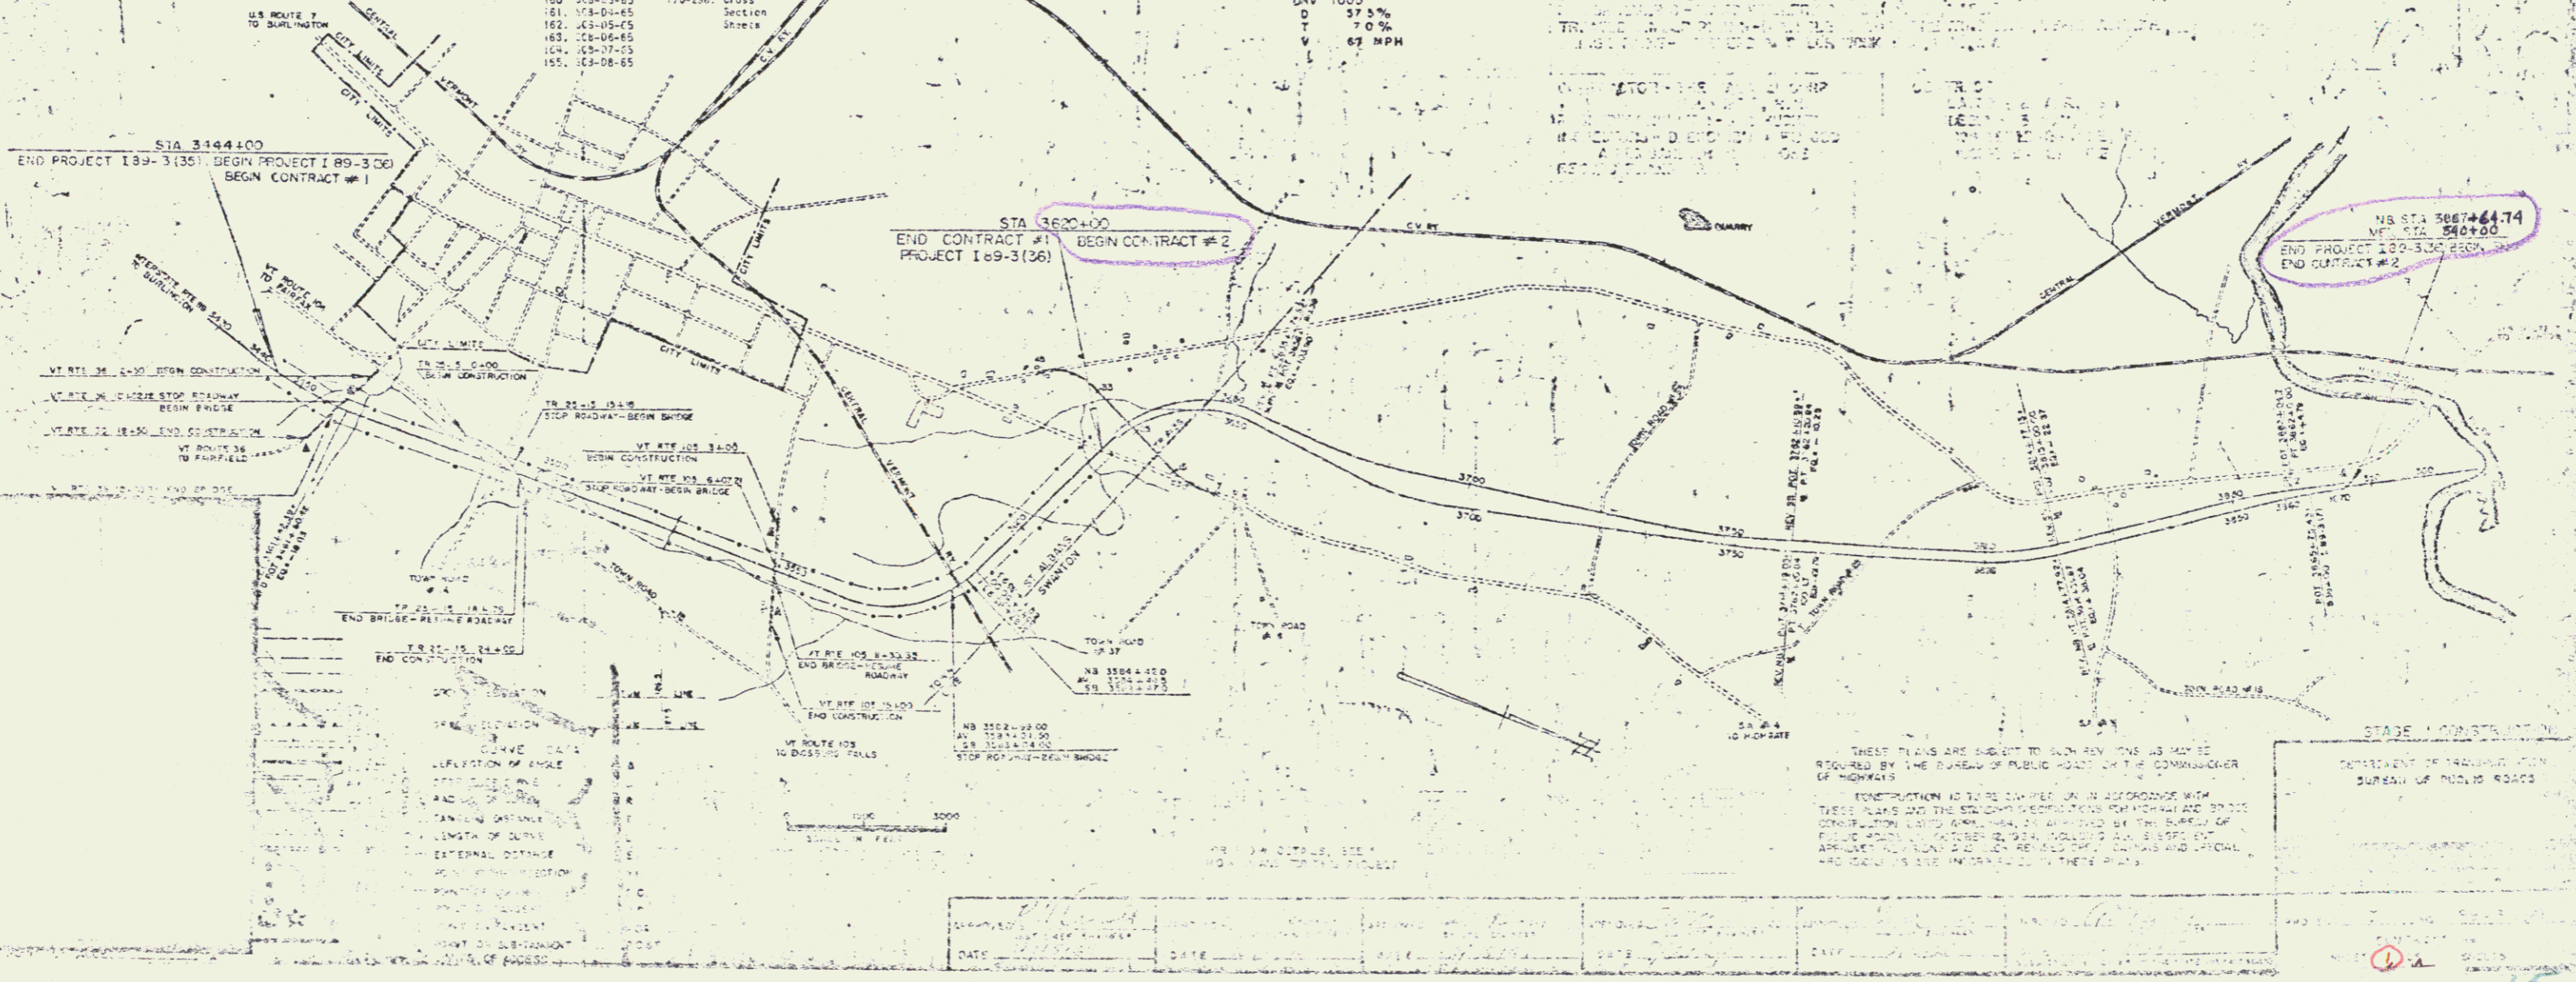

THESE PLANS ARE SUBJECT TO SUCH REVISIONS AS MAY BE REQUIRED BY THE BUREAU OF PUBLIC ROADS OR THE COMMISSIONER OF HIGHWAYS.

STAGE 1 CONSTRUCTION
 DEPARTMENT OF TRANSPORTATION
 BUREAU OF PUBLIC ROADS

| | | | | | | | |
|------|------|------|------|------|------|------|------|
| DATE | DATE | DATE | DATE | DATE | DATE | DATE | DATE |
| | | | | | | | |