

*THREE CABLE GUARD RAIL LIGHT STEEL POSTS ITEM 53B
 SD 3601+00 RT 3603+00 RT 3605+00 RT 3607+00 RT
 NB 3600+00 LT 3602+00 LT 3604+00 LT 3606+00 LT
 SD 3601+00 LT 3603+00 LT 3605+00 LT 3607+00 LT

MUCK EXCAVATION Item 117
 2-BORROW Item 104
 SD 3657+25-3659+25


DIP-DAP FOR BANK PROTECTION
 MOD FOR CULVERT ENDS Item 513-B
 NB 3600+68-Rt
 SB 3652+03-Rt

PROPERTY LINE FENCE ITEM 503-II, MOD
 SB 3652+00-3666+00 Lt
 NB 3650+00-3666+00 Rt

STA	LOC	OFFSET	DESCRIPTION
SB 3652+00	LT	1200'	DUG WELL
NB 3652+00	RT	1500'	OLD DUG WELL
NB 3654+00	RT	1400'	DRILLED WELL
NB 3658+00	RT	1300'	DUG WELL
SB 3664+00	LT	1900'	DUG WELL
SB 3667+00	LT	1700'	DRILLED WELL

STAGE II CONSTRUCTION ITEM

PLAN	DATE	BY
REVISED		
NO. 1	10/15/42	J. J. [unclear]
NO. 2		
NO. 3		
NO. 4		
NO. 5		

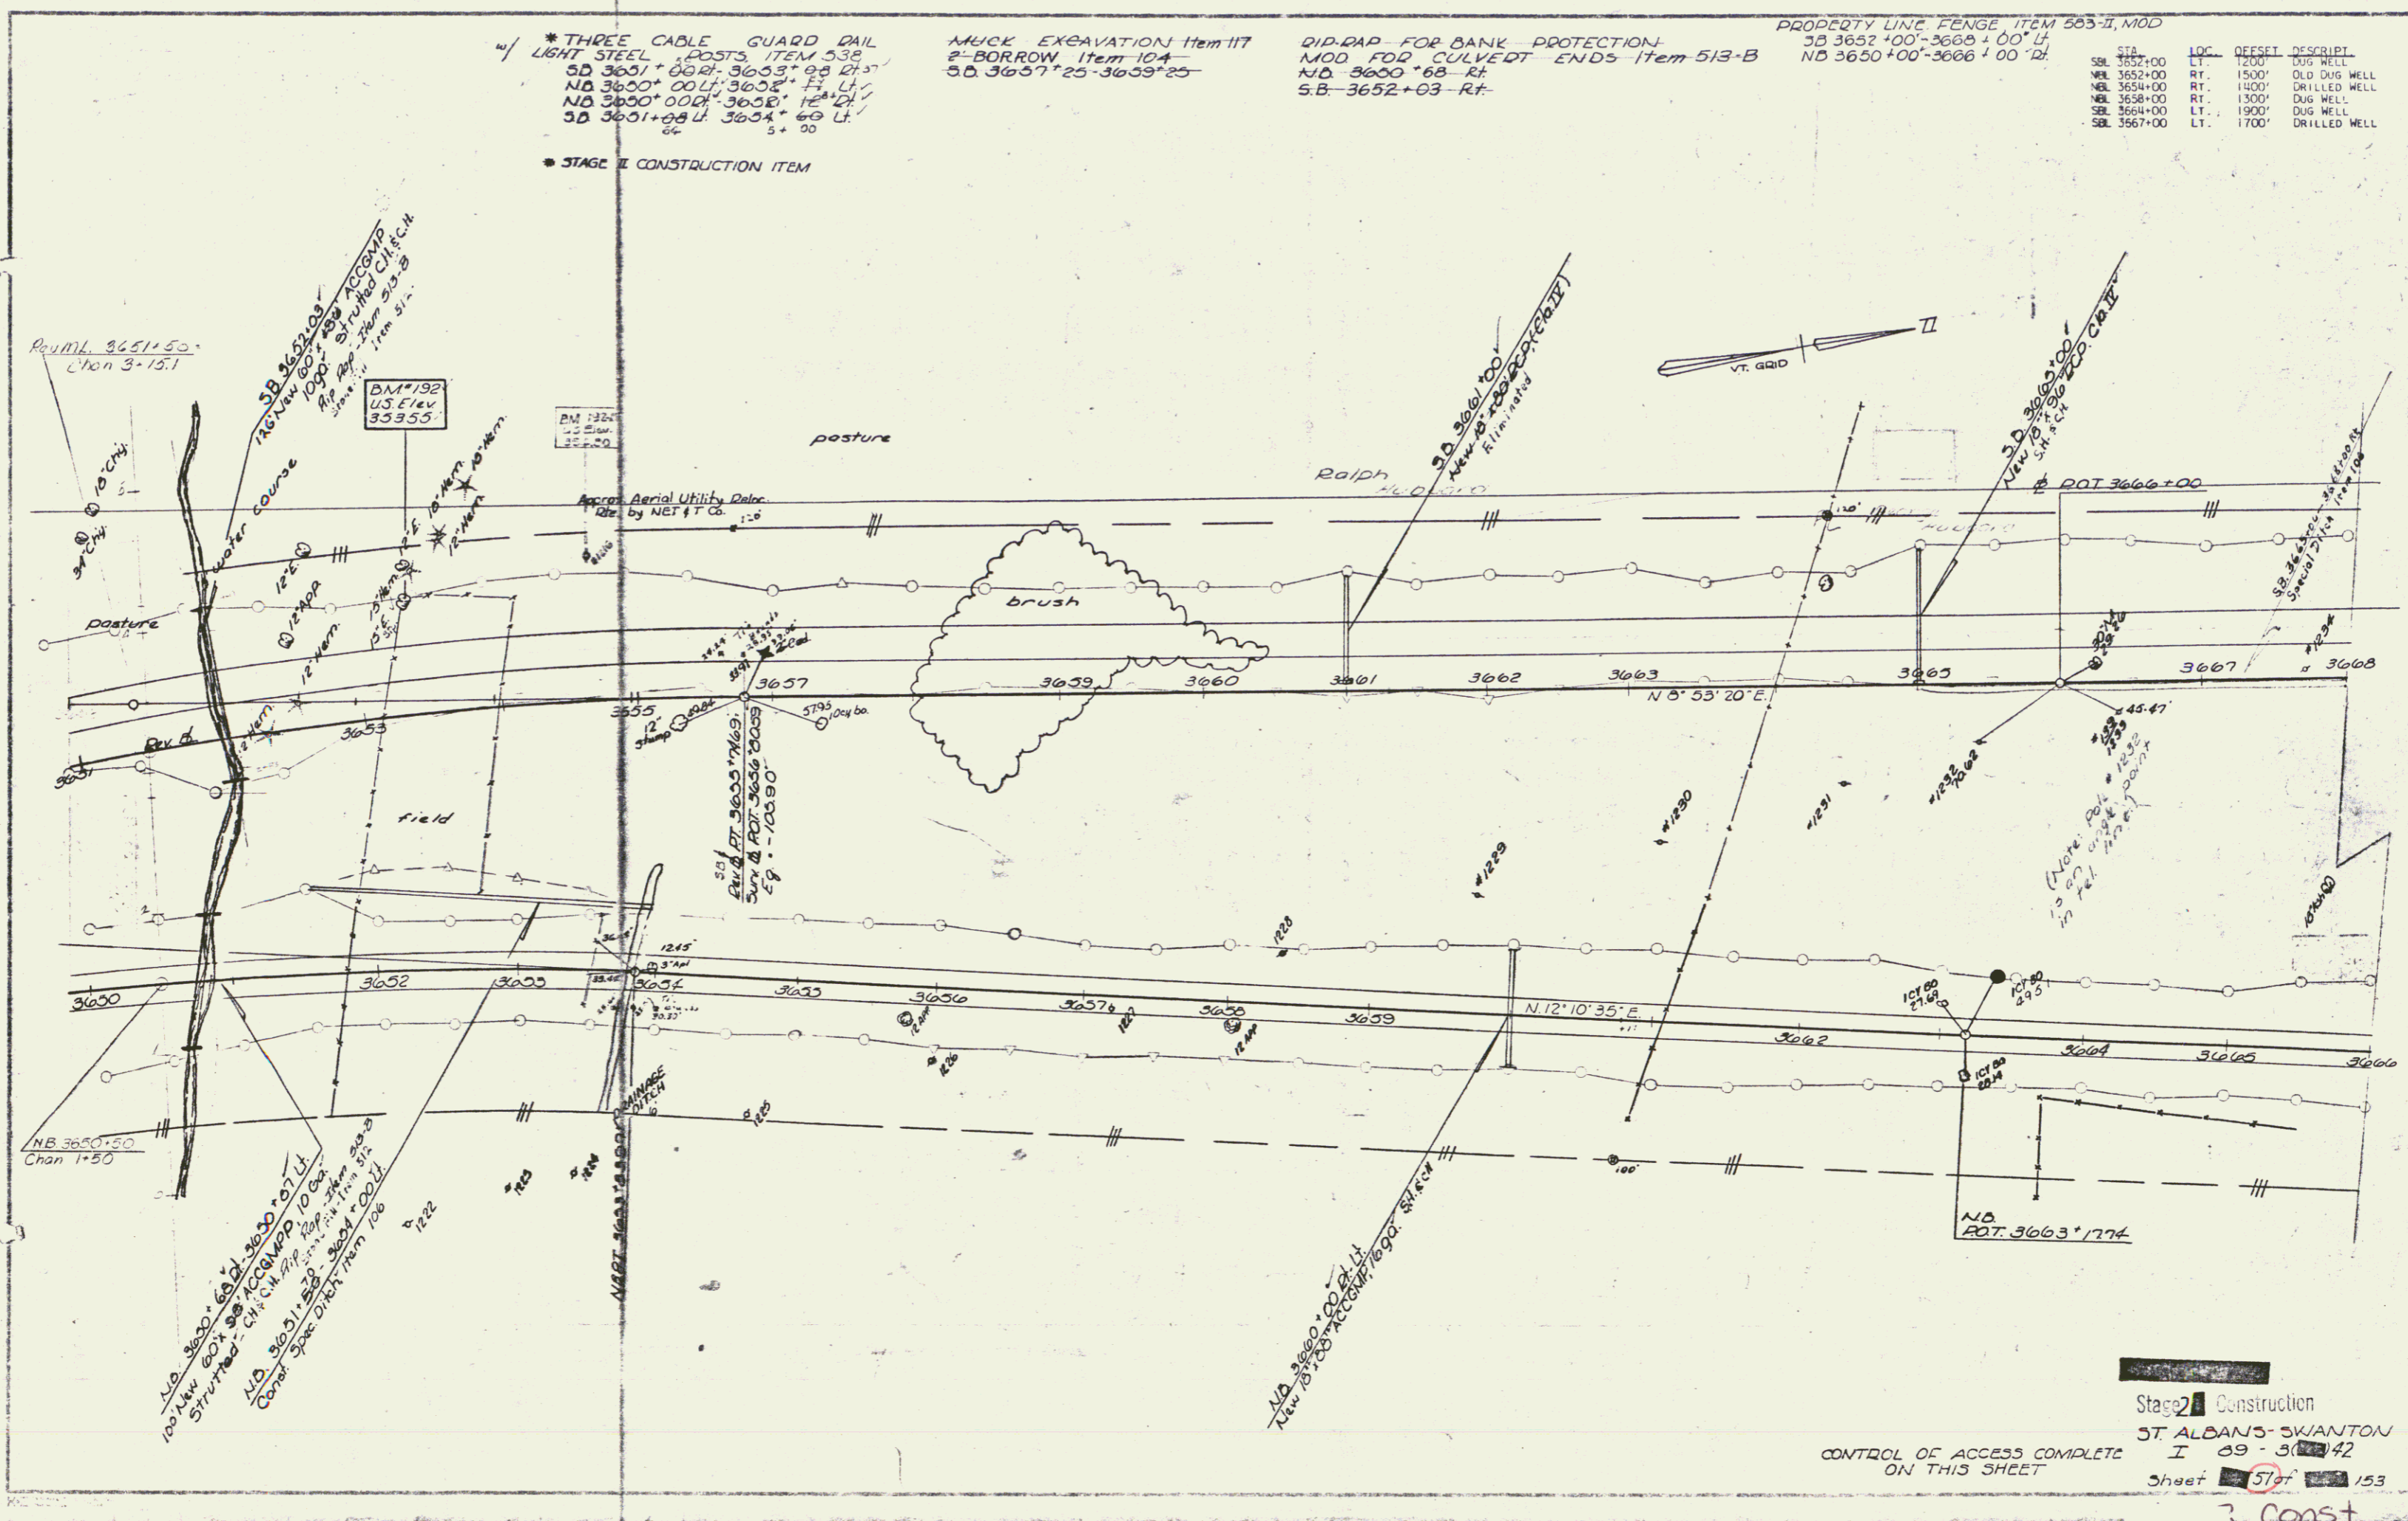

Stage II Construction
 ST. ALBANS-SWANTON
 I 09-31-42
 CONTROL OF ACCESS COMPLETE
 ON THIS SHEET
 Sheet 57 of 153
 Const

68