


DRILLING & BLASTING OF SOLID  
ROCK SUBGRADE, ITEM 113  
NB 3699 + 25 - 3704 + 25  
NB 3705 + 25 - 3710 + 25  
NB 3714 + 25 - 3714 + 00

MUCK EXCAVATION, ITEM 114  
SB 3706 + 00 - 3716 + 00  
NB 3704 + 25 - 3707 + 25

PROPERTY LINE FENCE, ITEM 503-II, MOD.  
NB 3695 + 00 - 3714 + 00 PL  
SB 3700 + 00 - 3716 + 00 PL  
DRILLING & BLASTING, ITEM 114  
NB 3712 + 00

STA	LOC	DEPTH	DESCRIPTION
NBL 3695+00	RT	700'	SPRING
SBL 3700+00	LT	3600'	DRILLED WELL
SBL 3702+00	LT	3400'	NATURAL POND
NBL 3705+00	RT	1600'	DRILLED WELL
NBL 3706+25	RT	120'	DUG SPRING
SBL 3708+00	LT	4000'	DRILLED WELL
NBL 3709+00	RT	1000'	DUG WATER TUBE
SBL 3709+00	LT	600'	FARM POND
NBL 3710+00	RT	2500'	SPRING
SBL 3710+00	LT	700'	SPRING

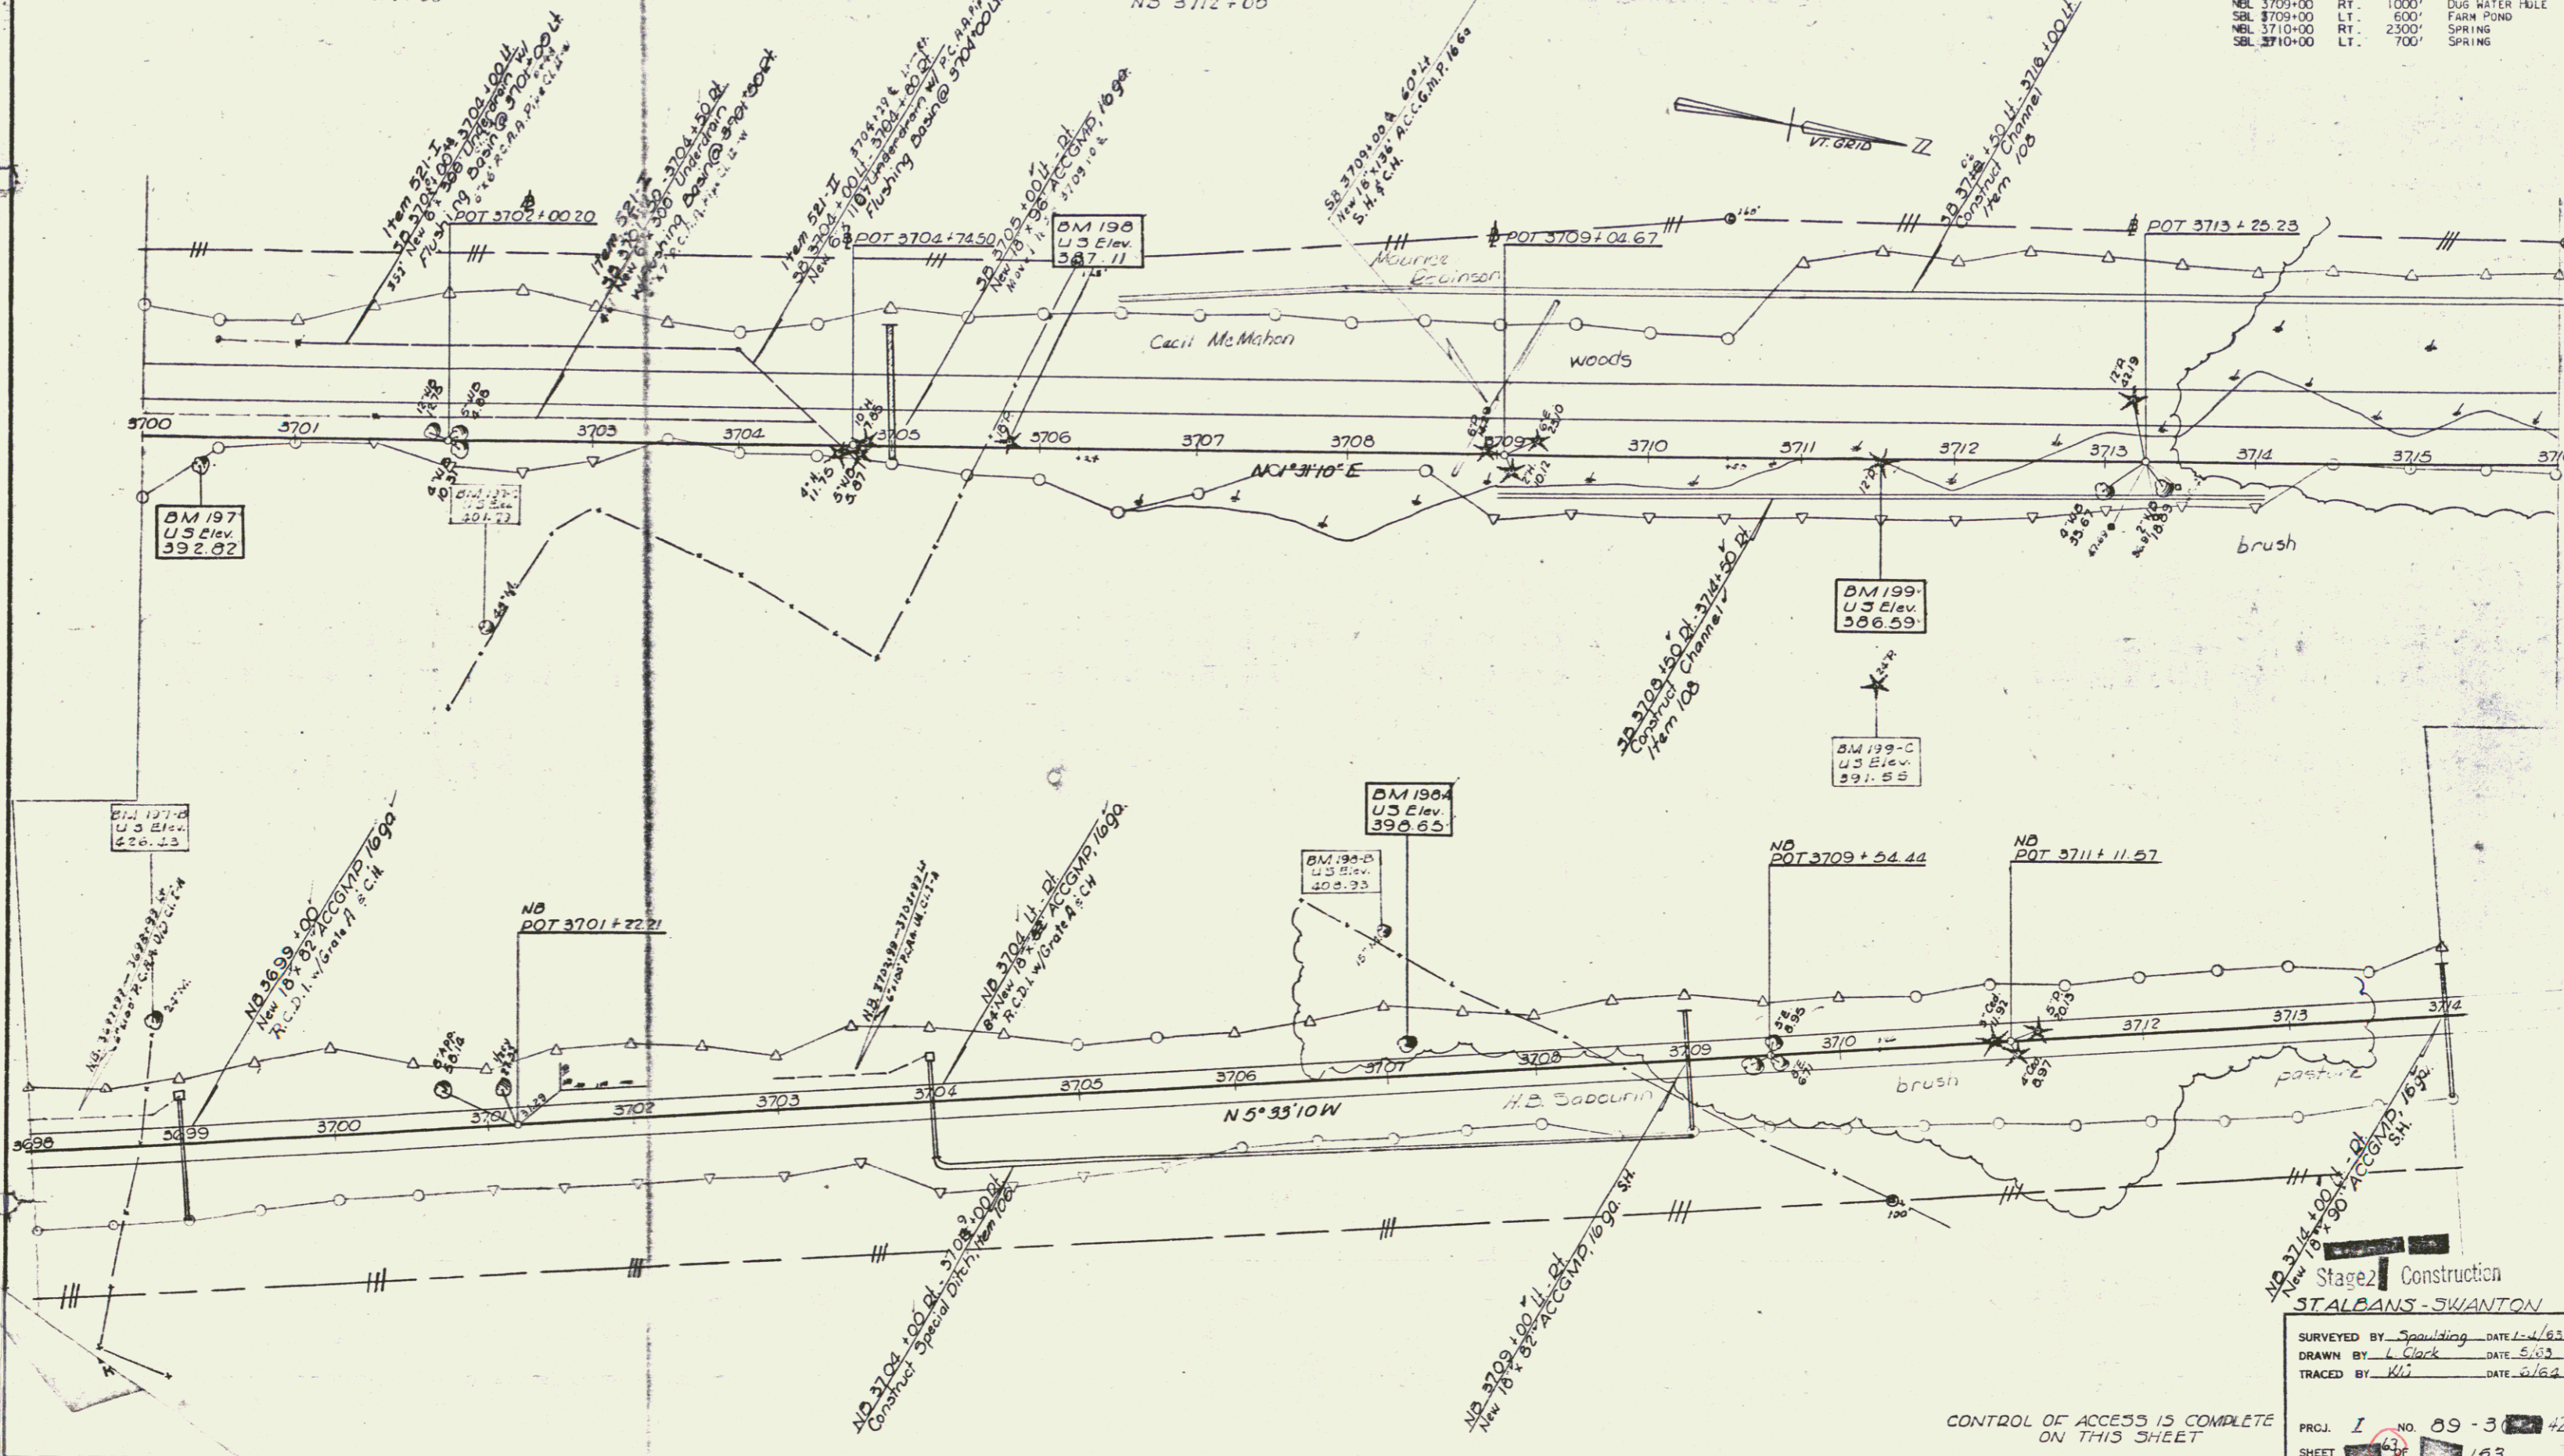

Stage 2 Construction  
STALBANS-SWANTON  
SURVEYED BY Spaulding DATE 1-4-63  
DRAWN BY L. Clark DATE 5-63  
TRACED BY W.L. DATE 5-62  
PRGJ. I NO. 89-3-42  
SHEET 63 OF 163

CONTROL OF ACCESS IS COMPLETE  
ON THIS SHEET