


PLAN
 REVISIONS
 No. Description
 1. As Shown
 2. As Shown

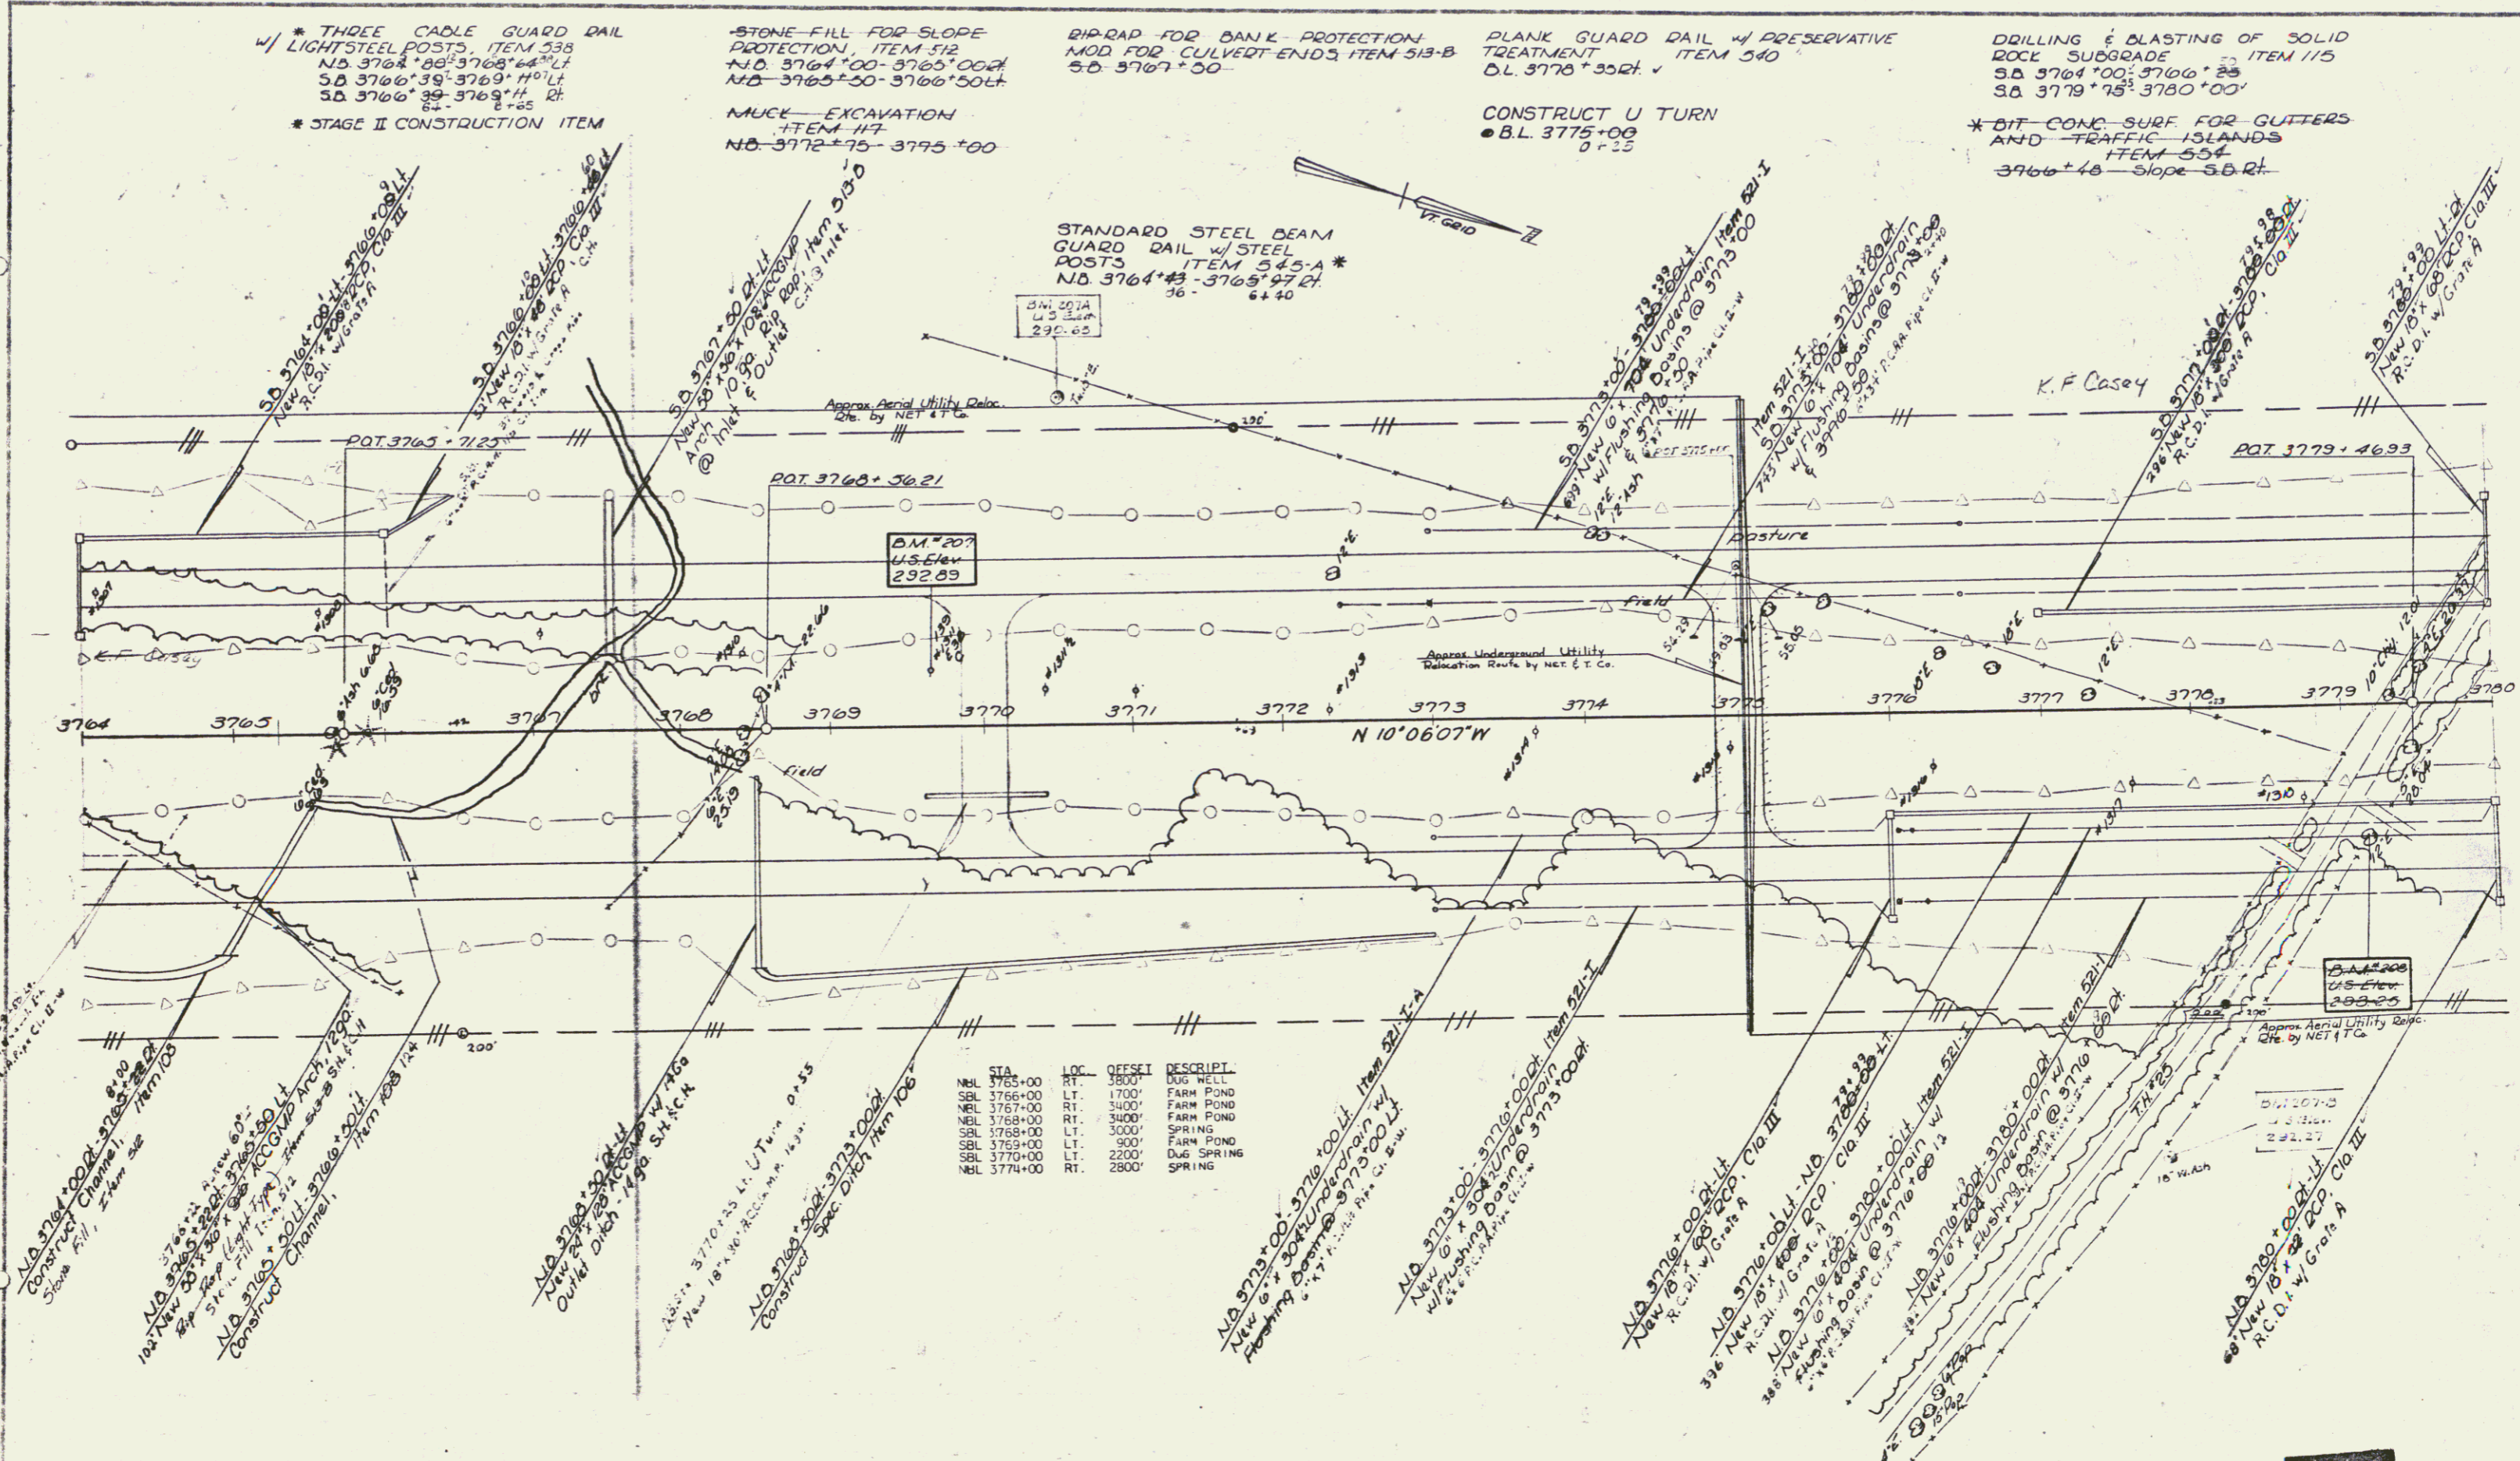

PROPERTY LINE FENCE, ITEM 553-II, MOD.
 @ 3764+00 - 3780+00 Lt. 1/2 Ct.

CONTROL OF ACCESS-15
 COMPLETE ON THIS SHEET

Stage 2 Construction
 ST. ALDANS - SWANTON
 I 89 - 300+12
 SHEET 153