



PLAN
 DATE: _____
 DRAWN BY: _____
 CHECKED BY: _____
 IN CHARGE: _____

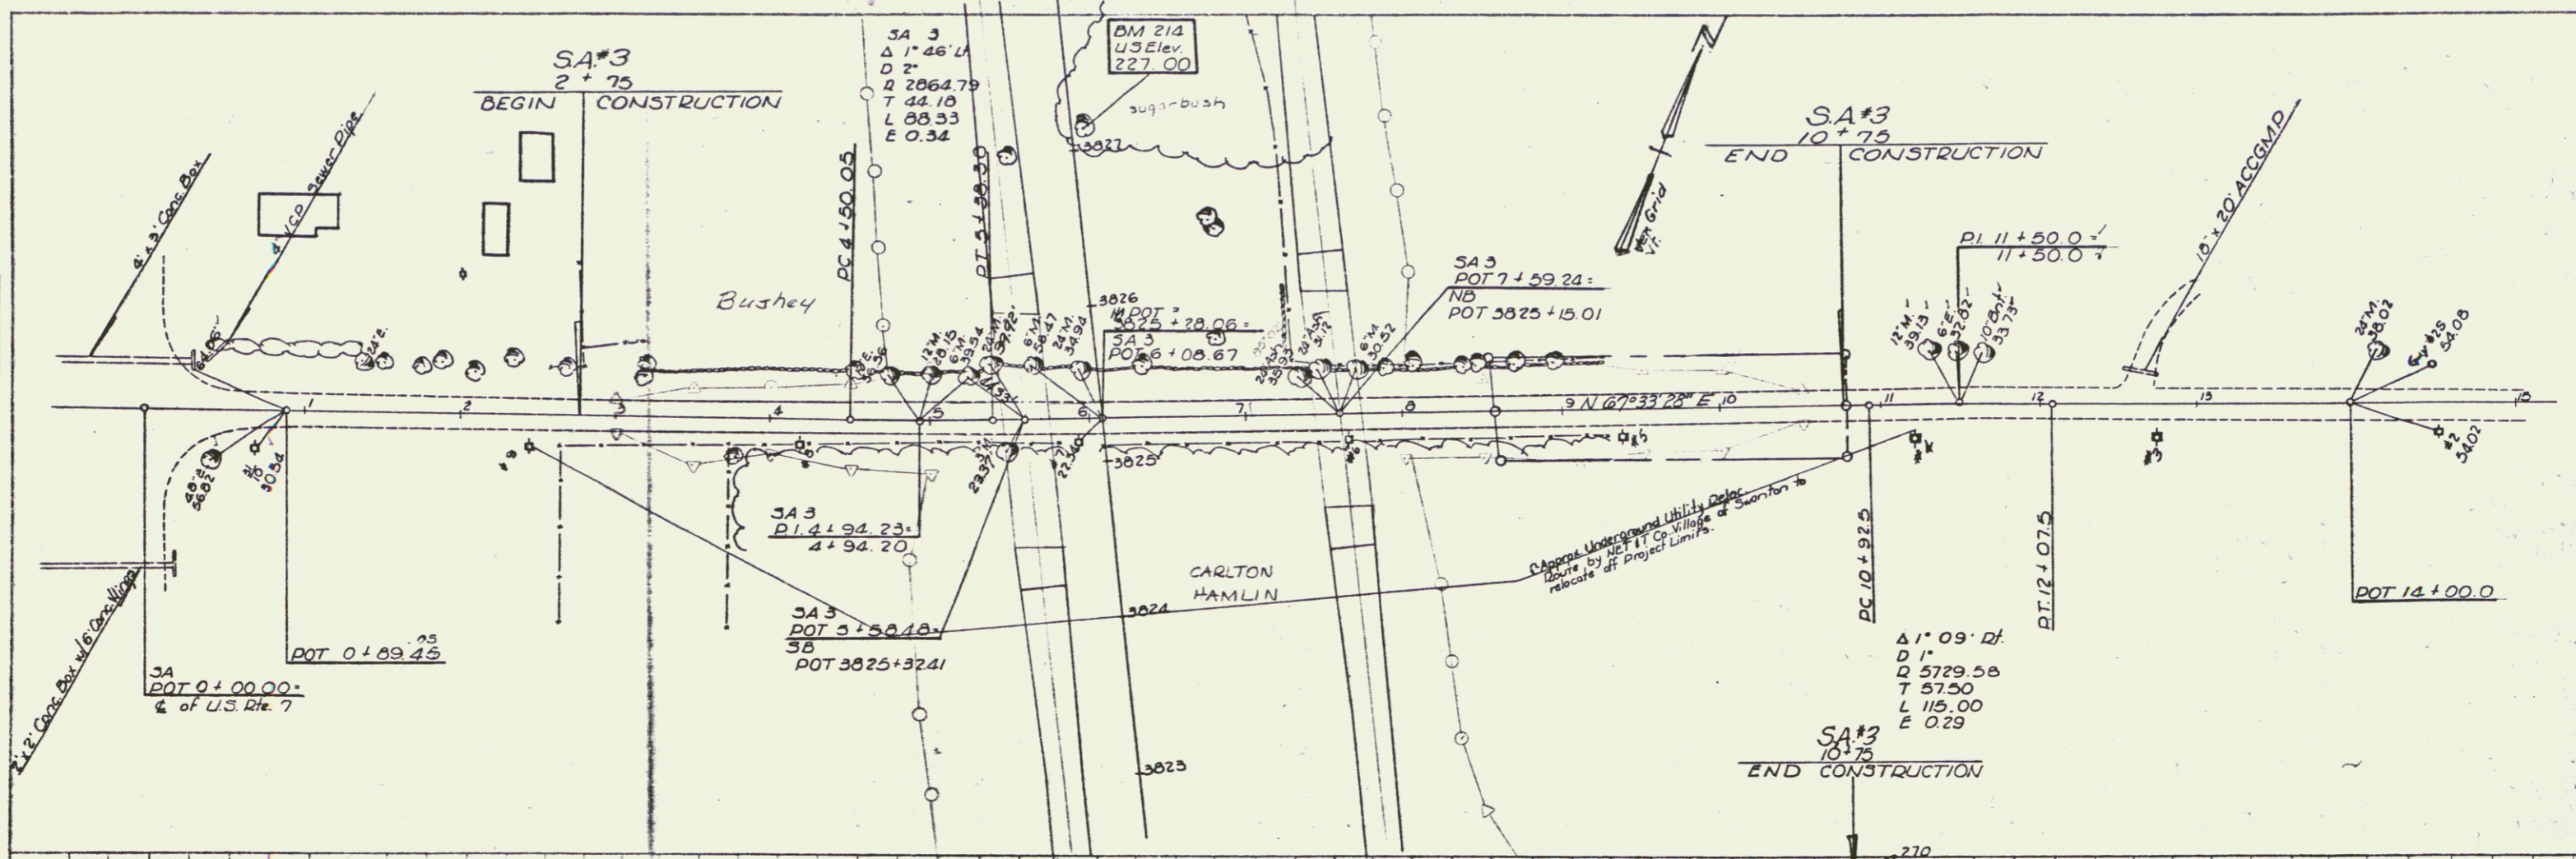

PROFILE
 DATE: _____
 DRAWN BY: _____
 CHECKED BY: _____
 IN CHARGE: _____

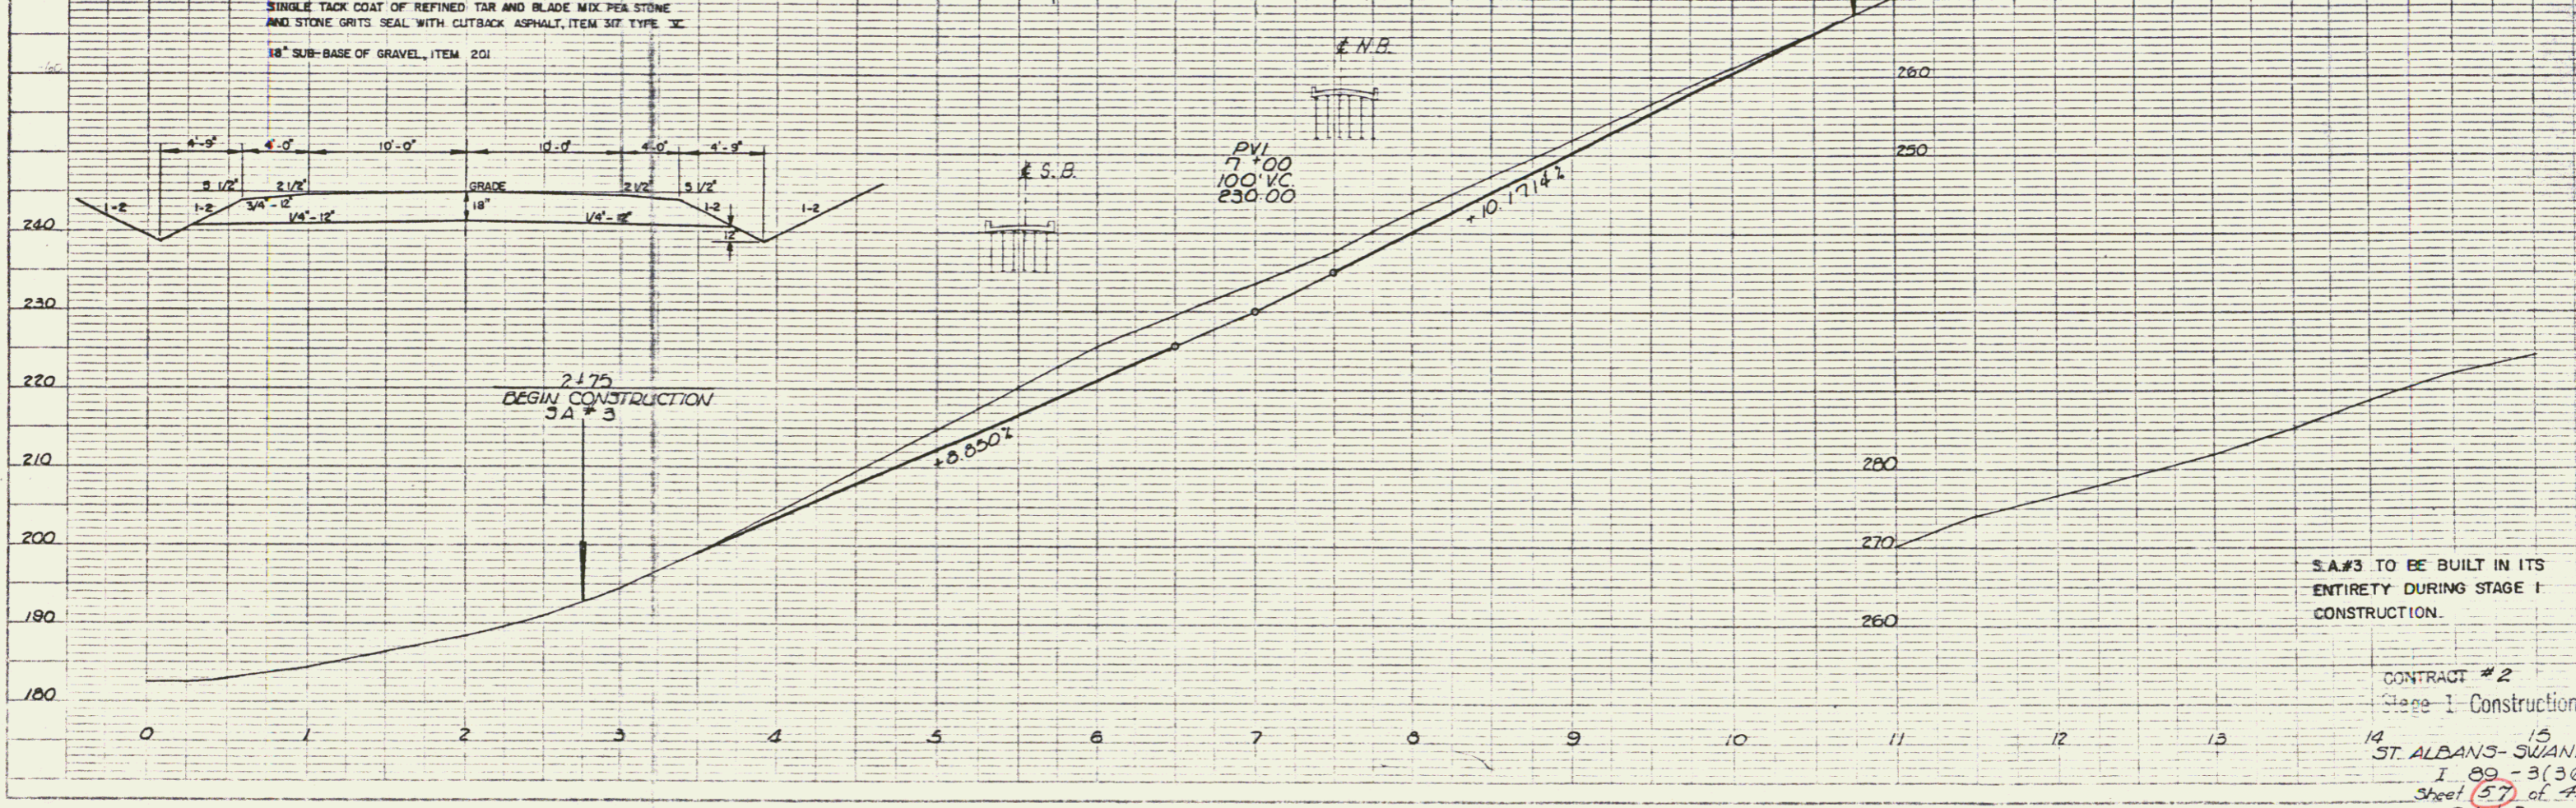

CONTRACT #2
 Stage 1 Construction
 14 ST. ALBANS-SWANTON 15
 I 89-3(36)
 Sheet 57 of 412
 S.A.#3