

INDEX OF SHEETS

SHEET NO.	1.	Title
	2-3.	Typical Roadway
	4.	Quantity and Drainage Sheet
	5.	Earthwork Sheet
	6.	AGW Detail Sheets
	7-11.	Layouts & Profile Sheets
	12.	Utility Layout (OS 77)
DESIGN STANDARDS		
	13.	B-1 Banking Tables
	14.	B-5 Typical Slope Grading
	15.	B-6 Muck Excavation
	16.	B-10 Embankment on a Slope
	17.	B-13 Drive Intersection
	18.	B-15 Entrance and Exit Terminals
	19.	B-16 Divisional Island Design
	20.	C-1 & C-1a Curbs
	21.	D-2 CRN & Headwalls
	22.	D-3 Treated Gutters
	23.	D-8 RCDD'S
	24.	D-11 Details of Grates & Cover for RCDD's
	25.	E-1 Barricades, Signs and Lights (For Roadway)
	26.	E-11 Interstate Route Markers
	27.	E-12 US Route Markers
	28.	E-14 & E-15 Regulatory signs
	29.	E-16 Warning Signs
	30.	E-17 & E-18 Guide Signs
	31.	E-19 Standard Sign Placement
	32.	E-20 Delineators, Hazard Markers & Mileposts
	33.	E-21 Ground Mounted Sign Supports
	34.	E-21 Federal Aid Construction Ident. Sign
	35.	F-1 Property Line Fence
	36.	G-1 Standard Steel Beam Guard Rail
	37.	J-1 Project Markers & Boundary Markers
	38.	Traffic Sign-Summary Sheet
	39.	Traffic Sign-Details & Design
	40.	Traffic Sign-Location & Delineators
	41-55.	Cross Sections
	2	Earthwork Final Sheets
	65-72	Cross Sections for Spur

STATE OF VERMONT
DEPARTMENT OF HIGHWAYS

PROPOSED IMPROVEMENT

SECONDARY PROJECT

TOWNS OF SWANTON-ST. ALBANS

COUNTY OF FRANKLIN

S.A. #4

HIGHGATE-ST. ALBANS ROAD



BEGINNING AT A POINT 0.60 MILE NORTHERLY OF THE SWANTON-ST. ALBANS TOWN LINE AND EXTENDING SOUTH-WESTERLY 0.468 MILE

LENGTH OF ROADWAY 2,470 FEET = 0.468 MILE

LENGTH OF PROJECT 2,470 FEET = 0.468 MILE

	SO. OF I 89	NO. OF I 89
1986	ADT 6230	1450
	DHV 920	230
	D 60%	63%
	T 7%	9%
	V	50 M.P.H.

PROJECT NAME & NO.	TYPE	AREA
SWANTON - ST. ALBANS S 0297 (2)	BIT. CONC.	
RECORD PLANS		
MATERIALS		
SUBBASE OF GRAVEL - CIVITTE PIT, FAIRFAX, VT. & YATES PIT, FAIRFIELD, VT.		
RELEASE OF SAND - DONALDSON PIT, SWANTON, VT.		
STONE GRITS - SWANTON LIME WORKS, SWANTON, VT.		
BIT. CONC. PAVEMENT - L.M. PIKE CO., SWANTON, VT.		
CUTBACK ASPHALT - MOBIL OIL CO., ALBANY, N.Y.		
CONC. CLASS 'B' - A. G. ANDERSON, SWANTON, VT.		
REINFORCING STEEL - VT. STRUCTURAL STEEL, BURLINGTON, VT.		
ALUMINUM ALL OF UNDERDRAIN - KAISER ALUMINUM & CHEMICAL SALES, INC., SCHENECTADY, N.Y.		
METAL PIPES, ELBOWS, ANGLES, FORM 'H', & C.I. COVERS - N.E. METAL CULVERT CO., WHITE RIVER JCT., VT.		
RCP, D.I. TYPE II, GUARD RAIL ITEMS, SIGNS & DELINEATORS - S.T. GREENWOLD & CO., INC., ESSEX JCT., VT.		
GRANITE SLOPE EDGING - NATIONAL FENCE & GRANITE CO., EXETER, N.H.		
C.I. GRATES & FRAMES - E. L. LEBARUM FOUNDRY CO., BROCKTON, MASS.		
4" GATE VALVE & 4" CEMENT LINED C.I. JOINT PIPE - CARPENTER SUPPLY CO., ESSEX JCT., VT.		
CONTRACTOR - CALEDONIA SAND & GRAVEL, & BECK & BELLUCCI, ST. JOHNSBURY, VT.	CONTRACT	DATED - APRIL 25, 1966
RESIDENT ENGINEER - W. F. MURPHY	INSPECTORS - A. WALL MOUNTY, D. LATHROP, A. NEWTON, W. FLANDERS, R. HAYES	BEGUN - APRIL 27, 1966
RECORD PLANS - P. WU		COMPLETED - SE. 9, 1967
		ACCEPTED - SE. 12, 1967

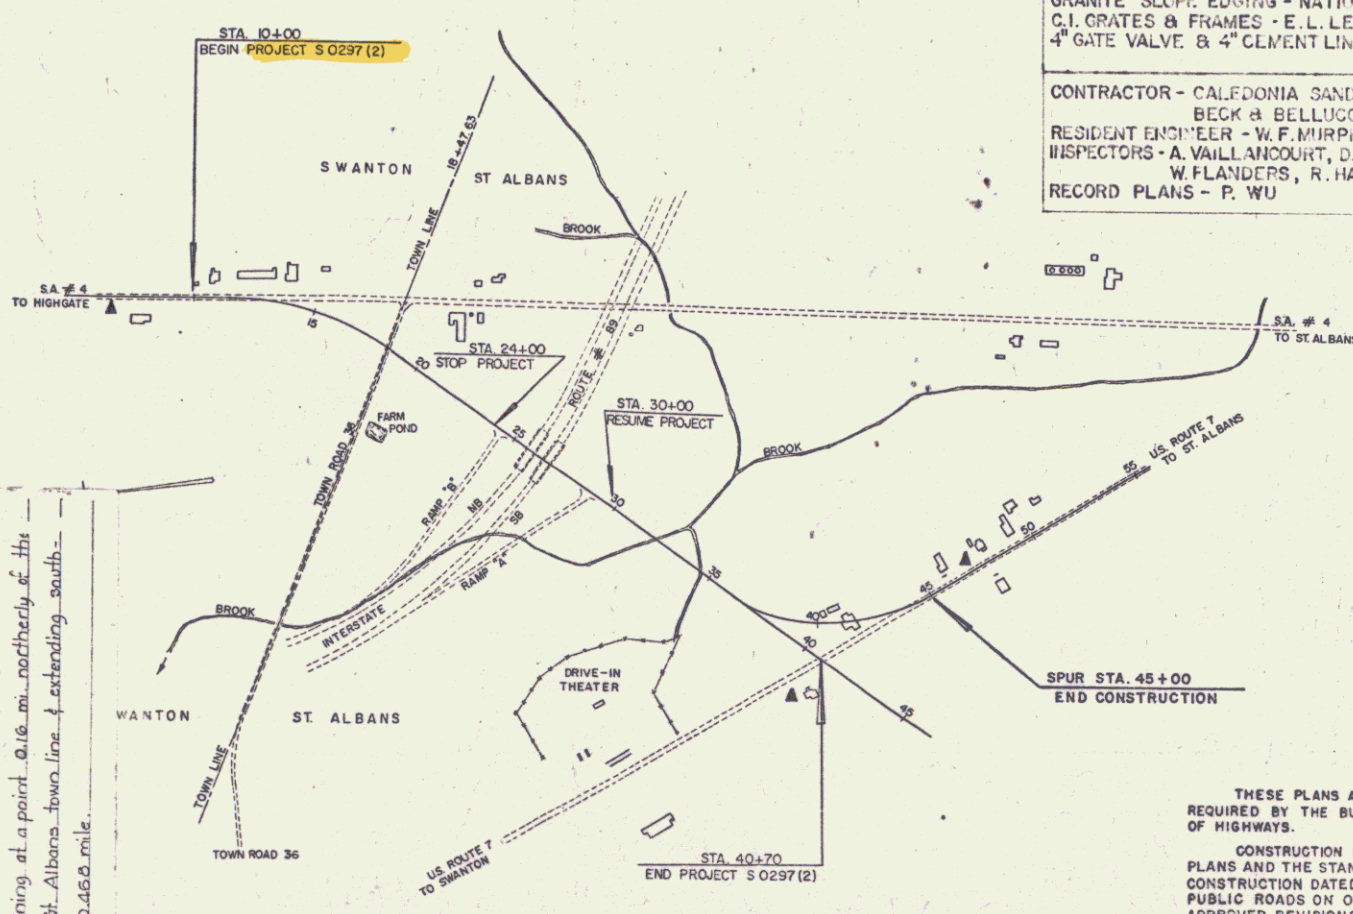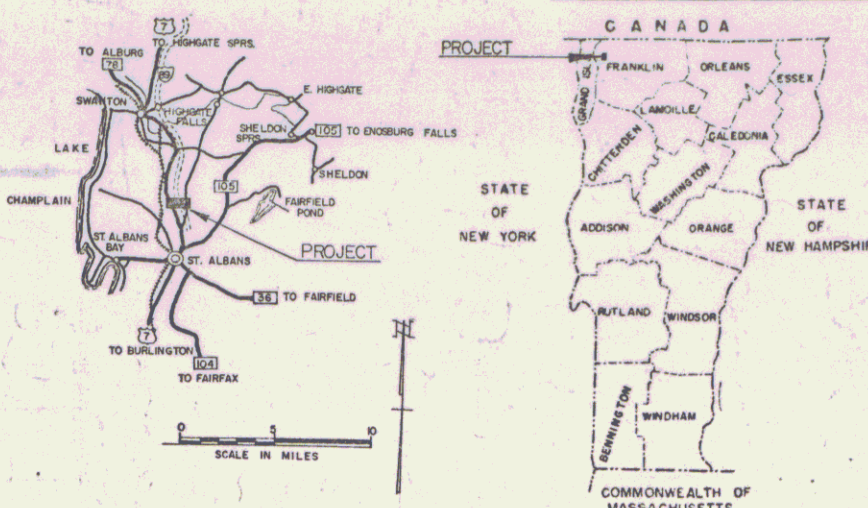

FOR R.O.W. DETAILS, SEE R.O.W. PLANS FOR THIS PROJECT

CONVENTIONAL SIGNS	SLOPE RIGHTS
R.O.W. LINE	
COUNTY LINE	
TOWN LINE	
FENCE LINE	
STONE WALL	
UNFENCED PROPERTY	
GUARD RAIL	
TRAVELED WAY	
RAILROAD	
RETAINING WALL	
CENTER LINE	
SURVEY LINE	
CULVERT	
DROP INLET	
TROLLEY POLE	
POWER POLE	
TELEPHONE POLE	
TREES	
HEDGE	

PROJECT SWANTON - ST. ALBANS
NUMBER S 0297 (2)
TYPE BITUMINOUS CONCRETE PAVEMENT
CONTRACTOR CALEDONIA SAND & GRAVEL CO. & BECK & BELLUCCI, ST. JOHNSBURY, VT.
RESIDENT ENGINEER W. F. MURPHY
LOCATION Beginning at a point 0.60 mile northerly of the Swanton-St. Albans town line & extending south-westerly 0.468 mile.

RIGHT-OF-WAY DIVISION
TOWN FILE
PERPETUAL
Route 4
Town of St. Albans State Hwy (North)
(To Be Returned To R.O.W. Division) V-207
Construction Plans

THESE PLANS ARE SUBJECT TO SUCH REVISIONS AS MAY BE REQUIRED BY THE BUREAU OF PUBLIC ROADS OR THE COMMISSIONER OF HIGHWAYS.
CONSTRUCTION IS TO BE CARRIED ON IN ACCORDANCE WITH THESE PLANS AND THE STANDARD SPECIFICATIONS FOR HIGHWAY AND BRIDGE CONSTRUCTION DATED APRIL, 1964, AS APPROVED BY THE BUREAU OF PUBLIC ROADS ON OCTOBER 12, 1964, INCLUDING ALL SUBSEQUENT APPROVED REVISIONS AND SUCH REVISED SPECIFICATIONS AND SPECIAL PROVISIONS AS ARE INCORPORATED IN THESE PLANS.

DEPARTMENT OF TRANSPORTATION BUREAU OF PUBLIC ROADS	
APPROVED	DATE
DIVISION ENGINEER	DATE
PROJECT S NO 0297 (2)	
SHEET 14 OF 55 SHEETS	

APPROVED [Signature] ASSIST. CHIEF ENGINEER DATE 7/27/64	APPROVED [Signature] CHIEF ENGINEER DATE 7/23/64	APPROVED [Signature] BRIDGE ENGINEER DATE	APPROVED [Signature] DISTRICT ENGINEER DATE 7/21/64	APPROVED [Signature] CHIEF ENGINEER DATE 7/22/64	APPROVED [Signature] CHIEF ENGINEER DATE 7/27/64
--	--	---	---	--	--