
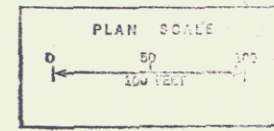


Property Line Fence with  
Steel Posts from 523 ft  
11 16'00" 20'00" 10'15" 25'00"

CONSTRUCT DRIVES  
SA # 4  
10+57 LH  
11+60 LH  
13+15 LH  
14+30 LH  
16+10 LH

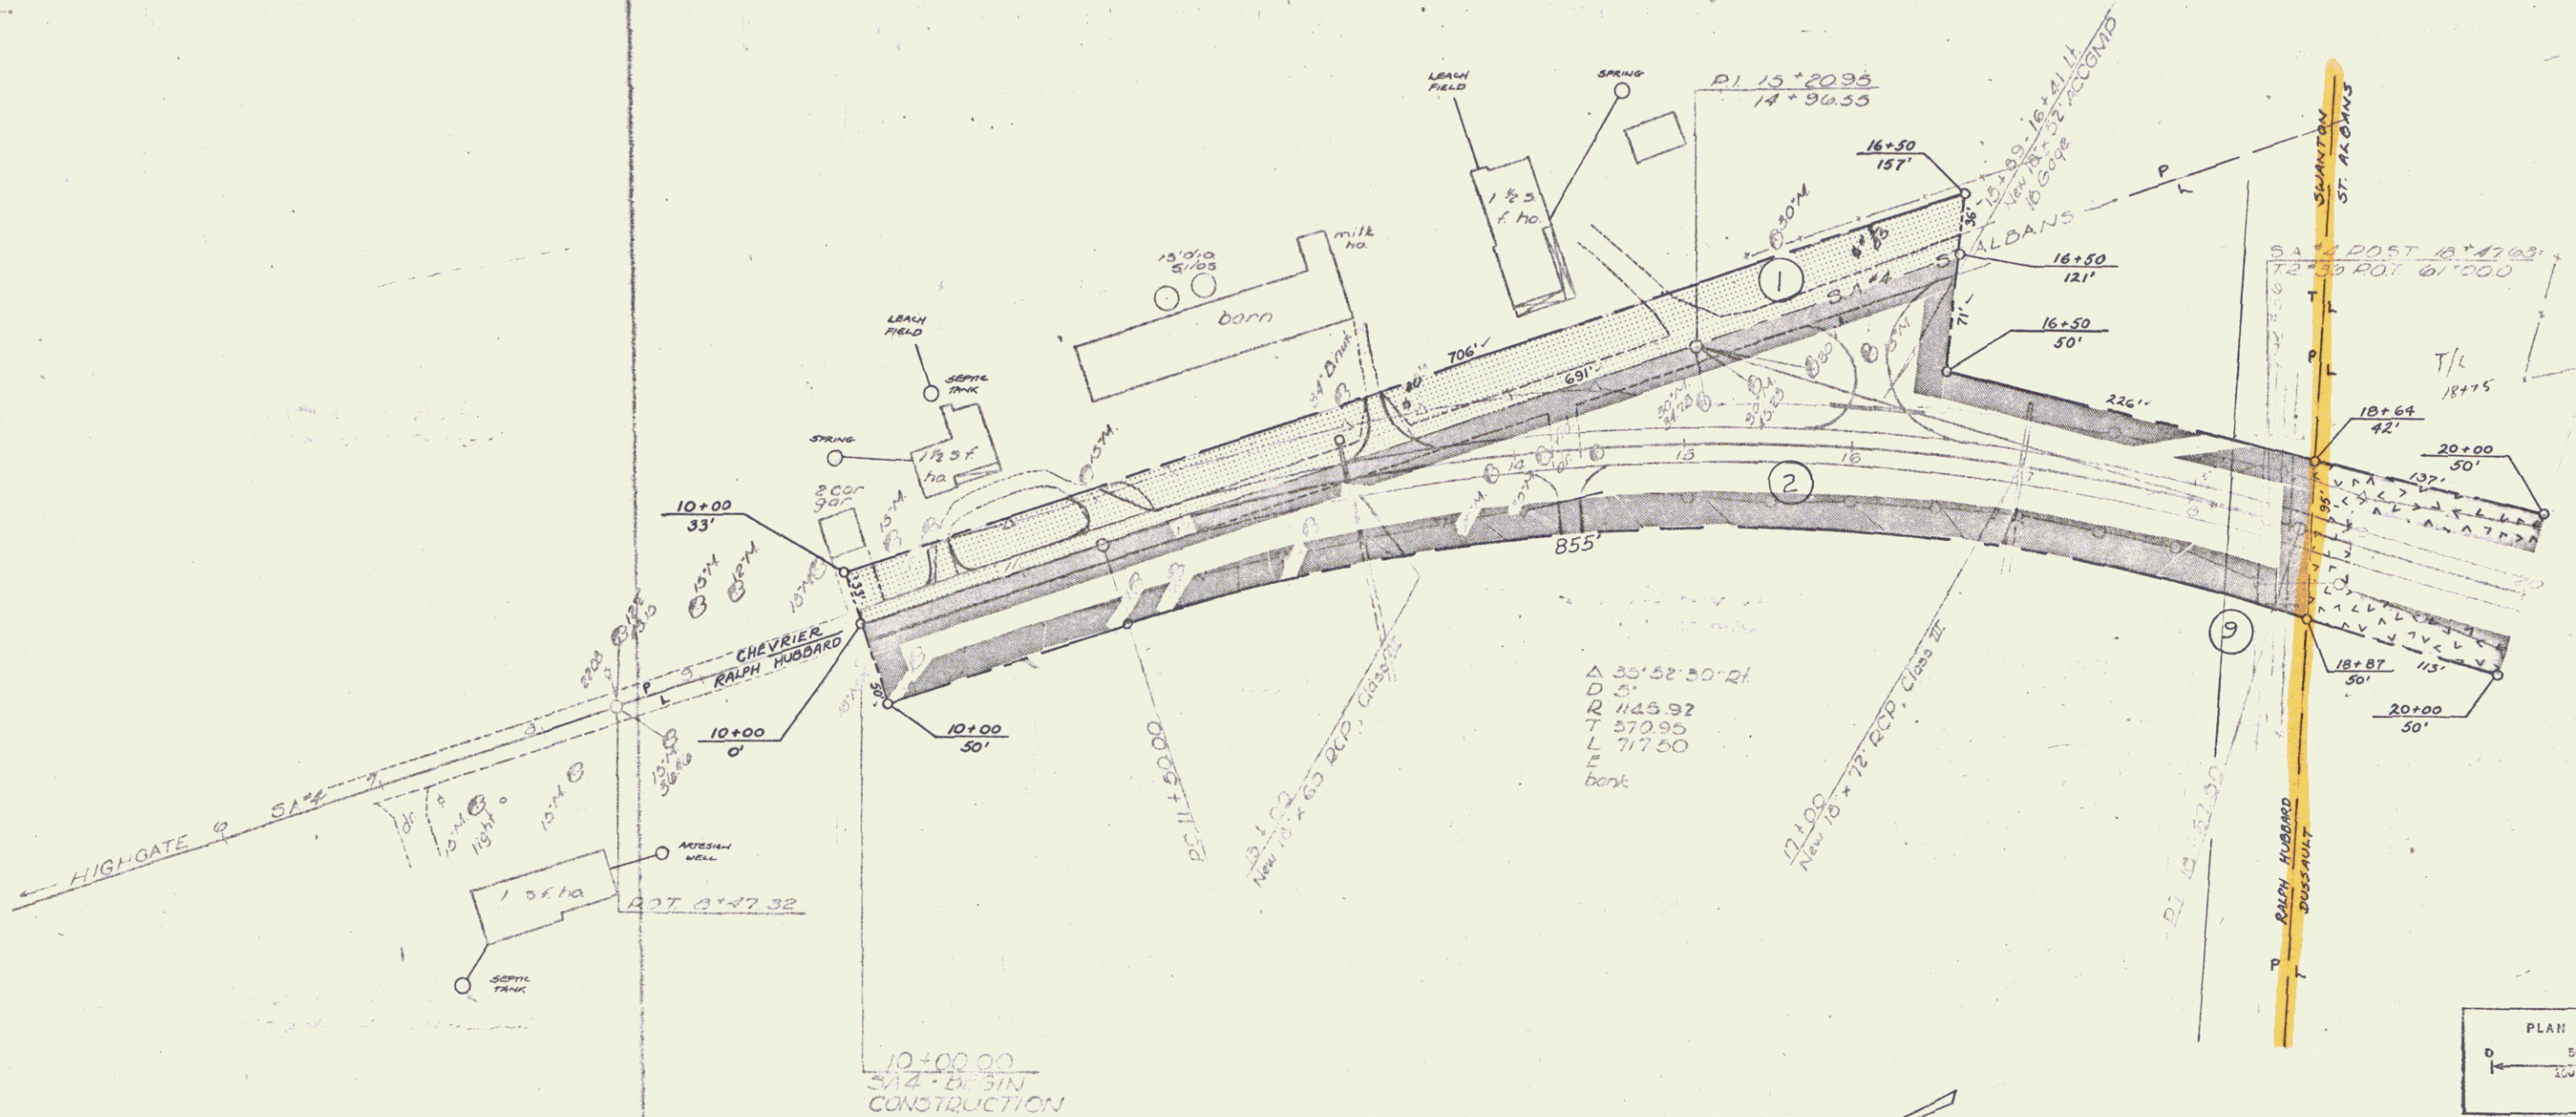

VERMONT DEPARTMENT OF HIGHWAYS  
RIGHT-OF-WAY PLANS  
PROJECT: SWANTON-ST ALBANS  
No. 50297(2)  
SHEET 4 OF 10