


BEGIN RELINQUISHMENT NO. I
S.A. 4 10+00 (875')

BEGIN MAINT. AGREE. AREA NO. 1 (ST. ALBANS)
S.A. 4 18+75 (525')

END RELINQUISHMENT NO. I (SWANTON)
S.A. 4 18+75 (525')

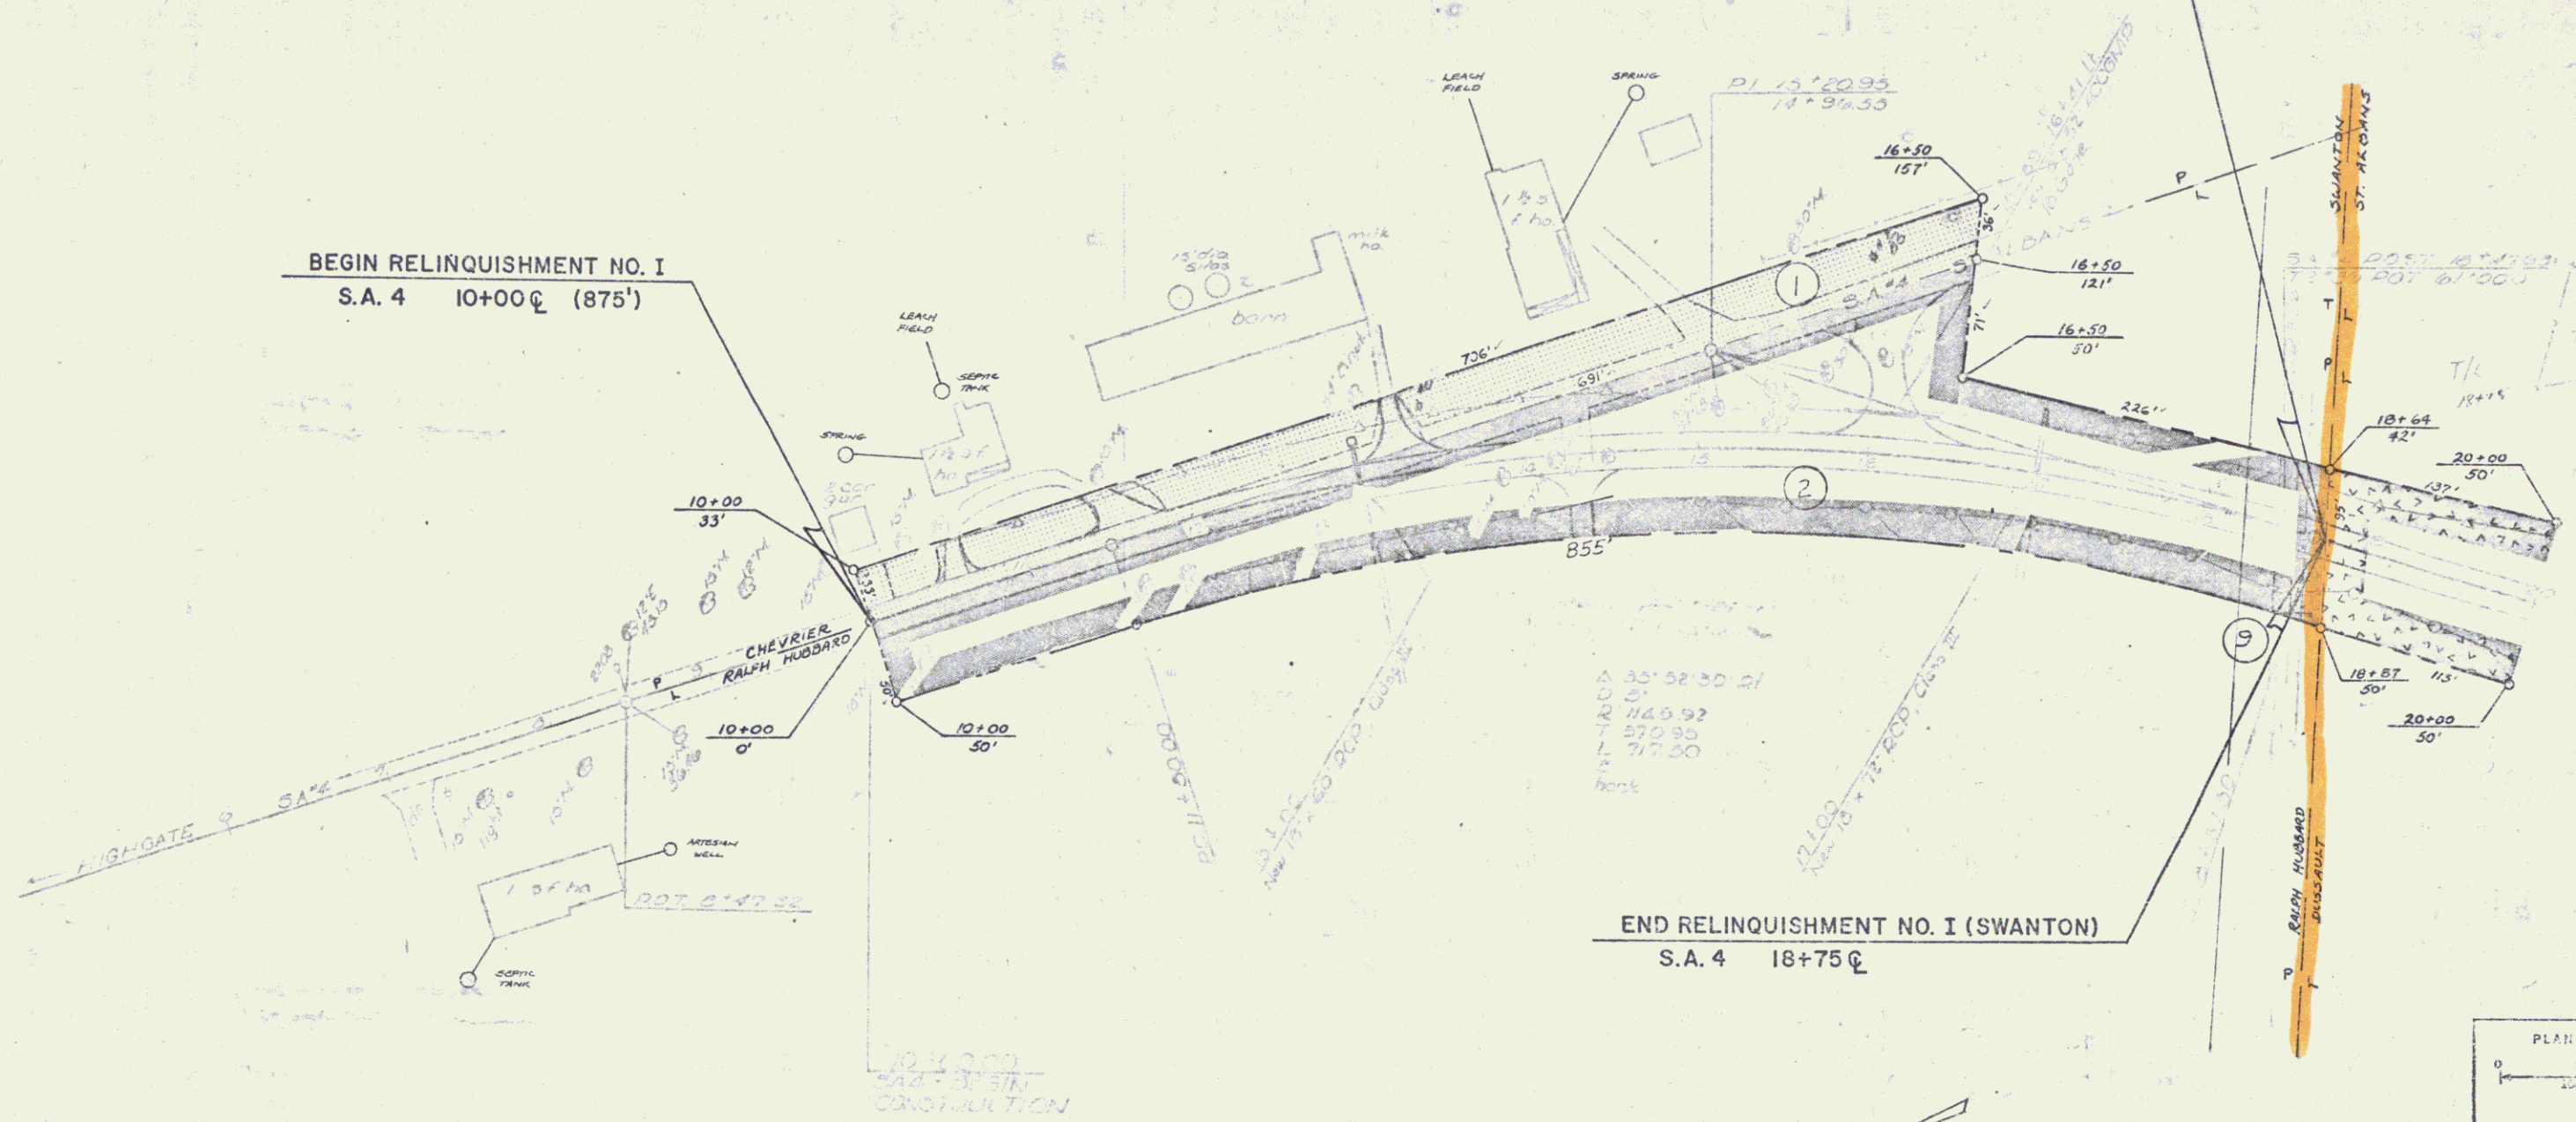

VERMONT DEPARTMENT OF HIGHWAYS
RIGHT-OF-WAY PLANS
PROJECT: SWANTON-ST. ALBANS
No. 50297(2)
SHEET: 7A OF 10

JUL 10 1980