
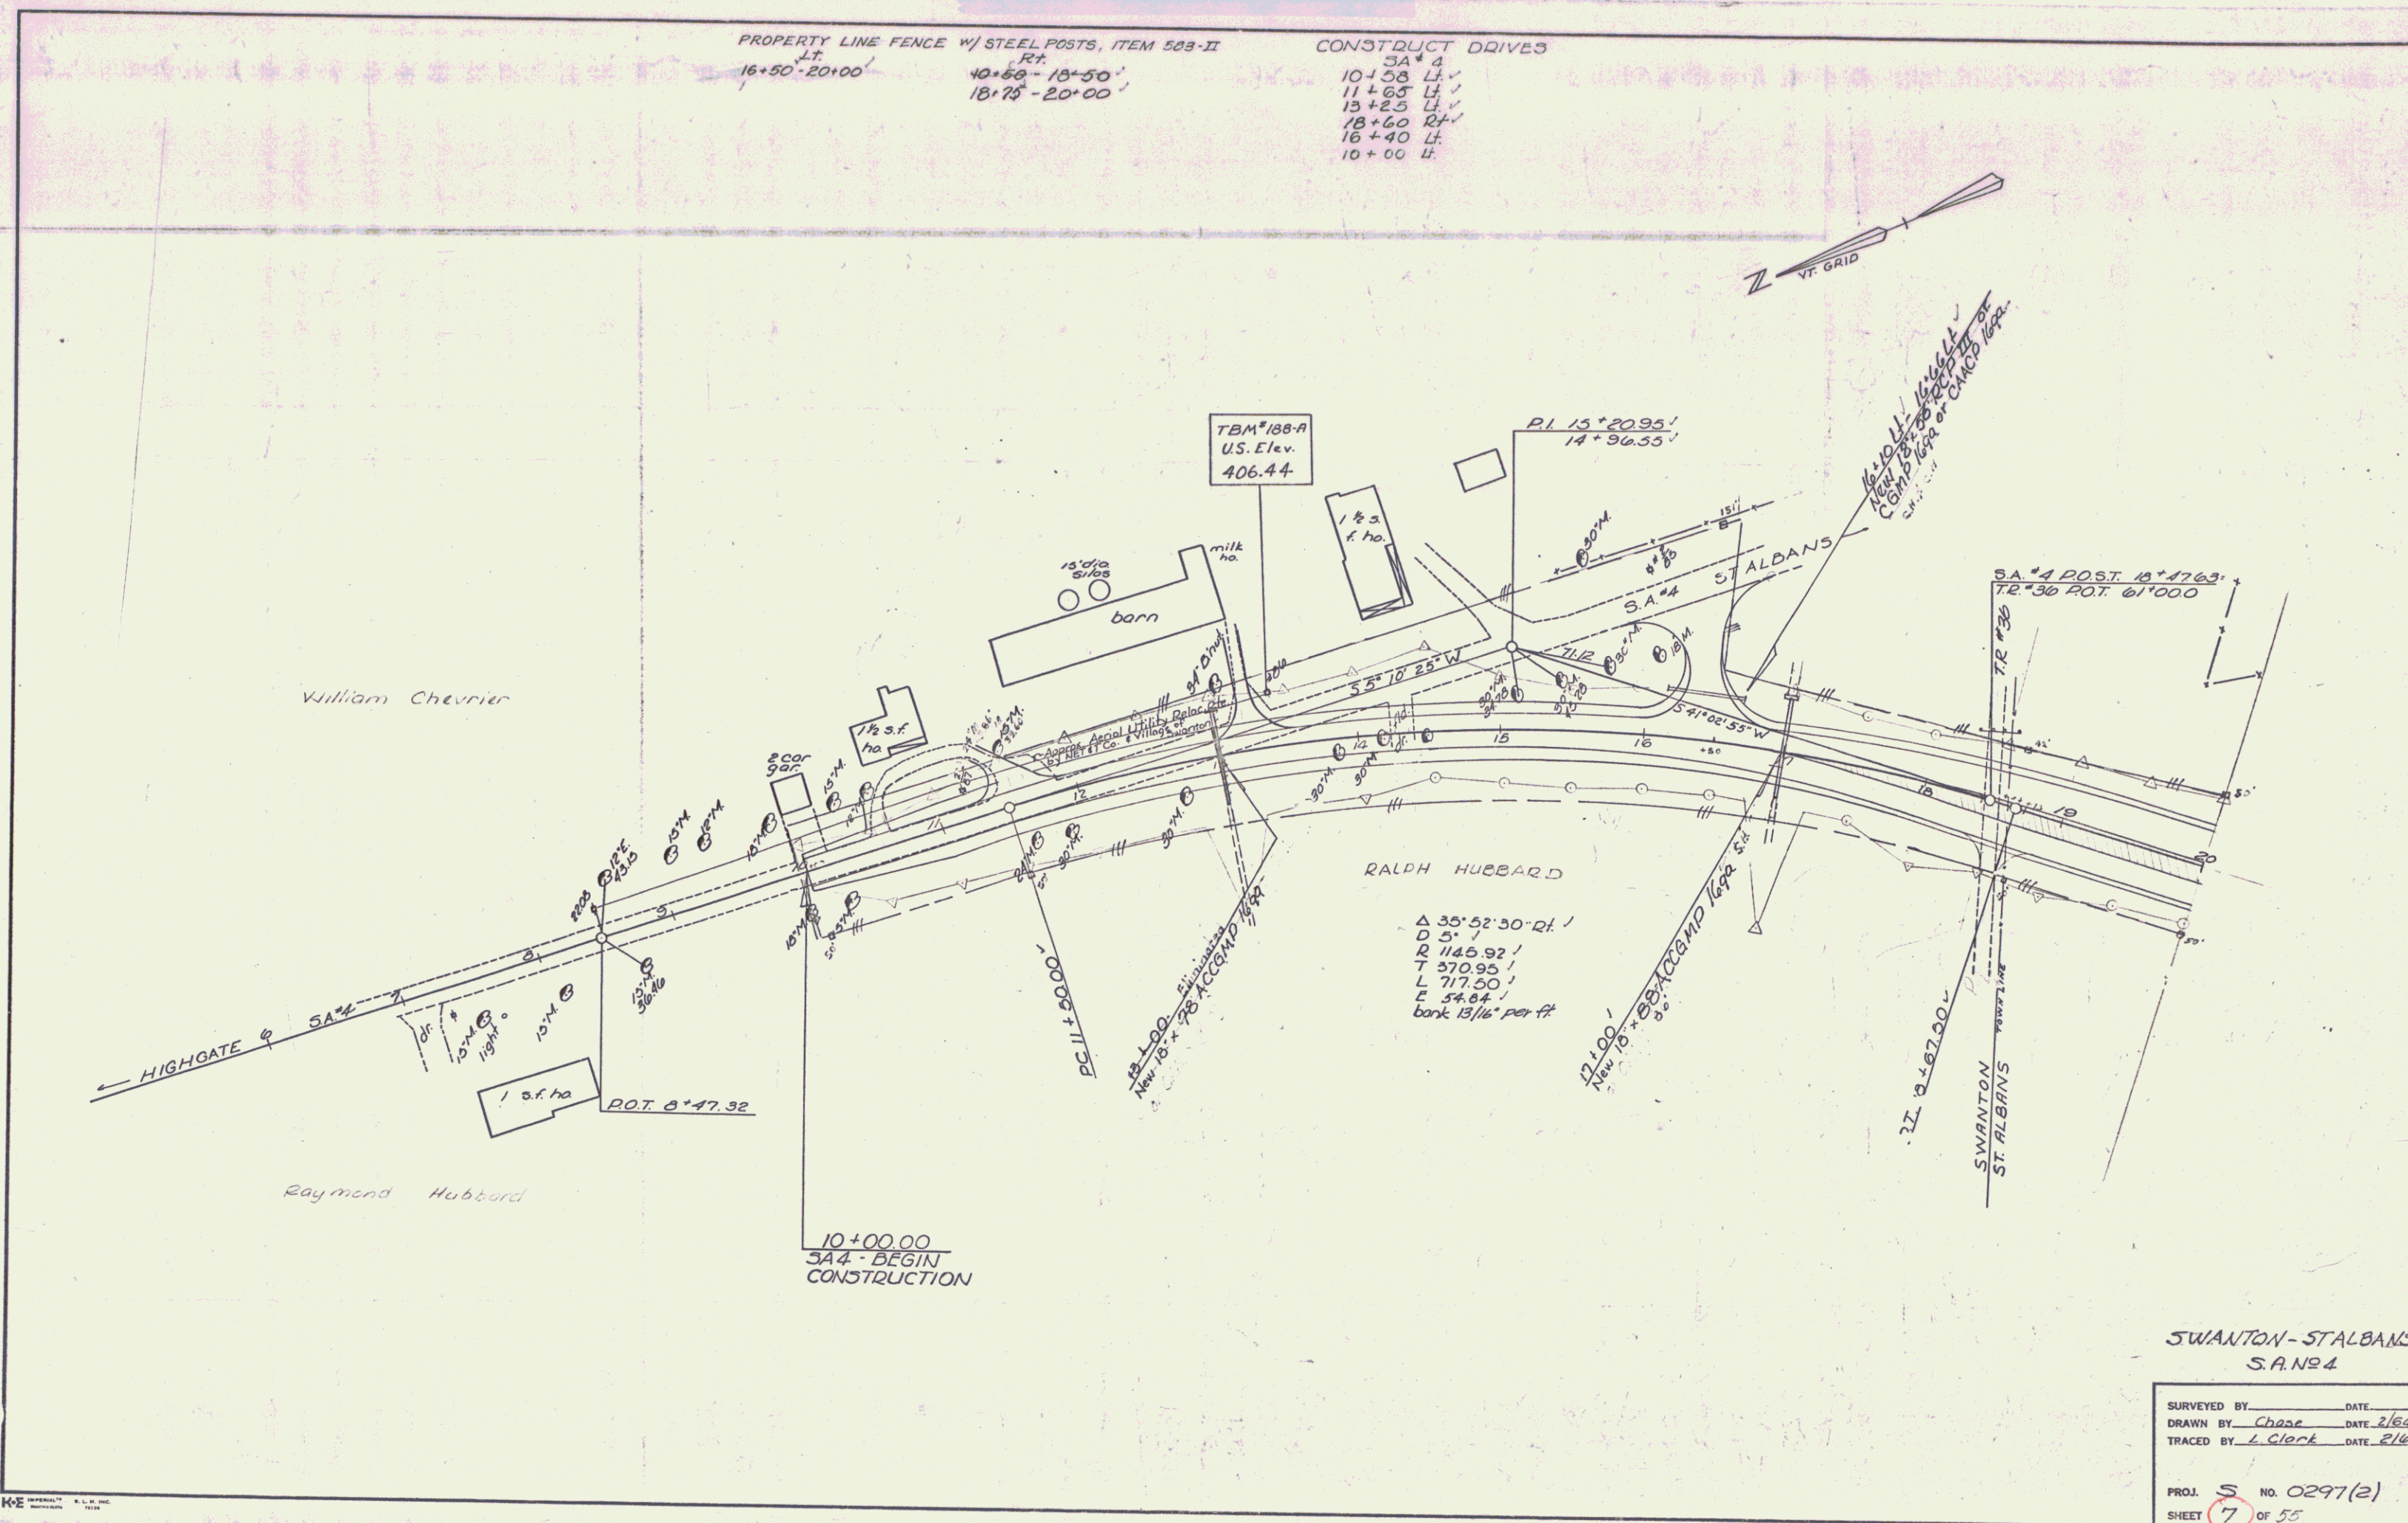


PROPERTY LINE FENCE w/ STEEL POSTS, ITEM 503-II
 Lt. 16+50-20+00
 Rt. 40+50-18+50
 18+75-20+00

CONSTRUCT DRIVES
 SA#4
 10+08 Lt. ✓
 11+65 Lt. ✓
 13+25 Lt. ✓
 18+60 Rt. ✓
 16+40 Lt.
 10+00 Lt.

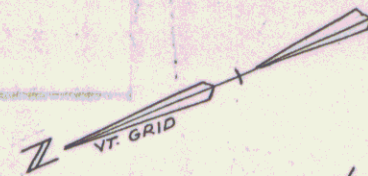

TBM#188-A
 U.S. Elev.
 406.44

PI 15+20.95'
 14+36.55'

RALPH HUBBARD

Δ 35°52'30" Rt.
 D 50.7
 R 1145.92'
 T 1145.92'
 L 717.50'
 E 54.84'
 bank 13 1/4" per ft.

SWANTON-STALBANS
 S.A. #4

SURVEYED BY _____ DATE _____
 DRAWN BY Chase DATE 2/64
 TRACED BY L. Clark DATE 2/64

PROJ. S NO. 0297(2)
 SHEET 7 OF 55

7