
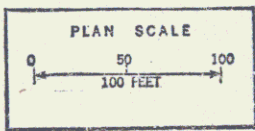
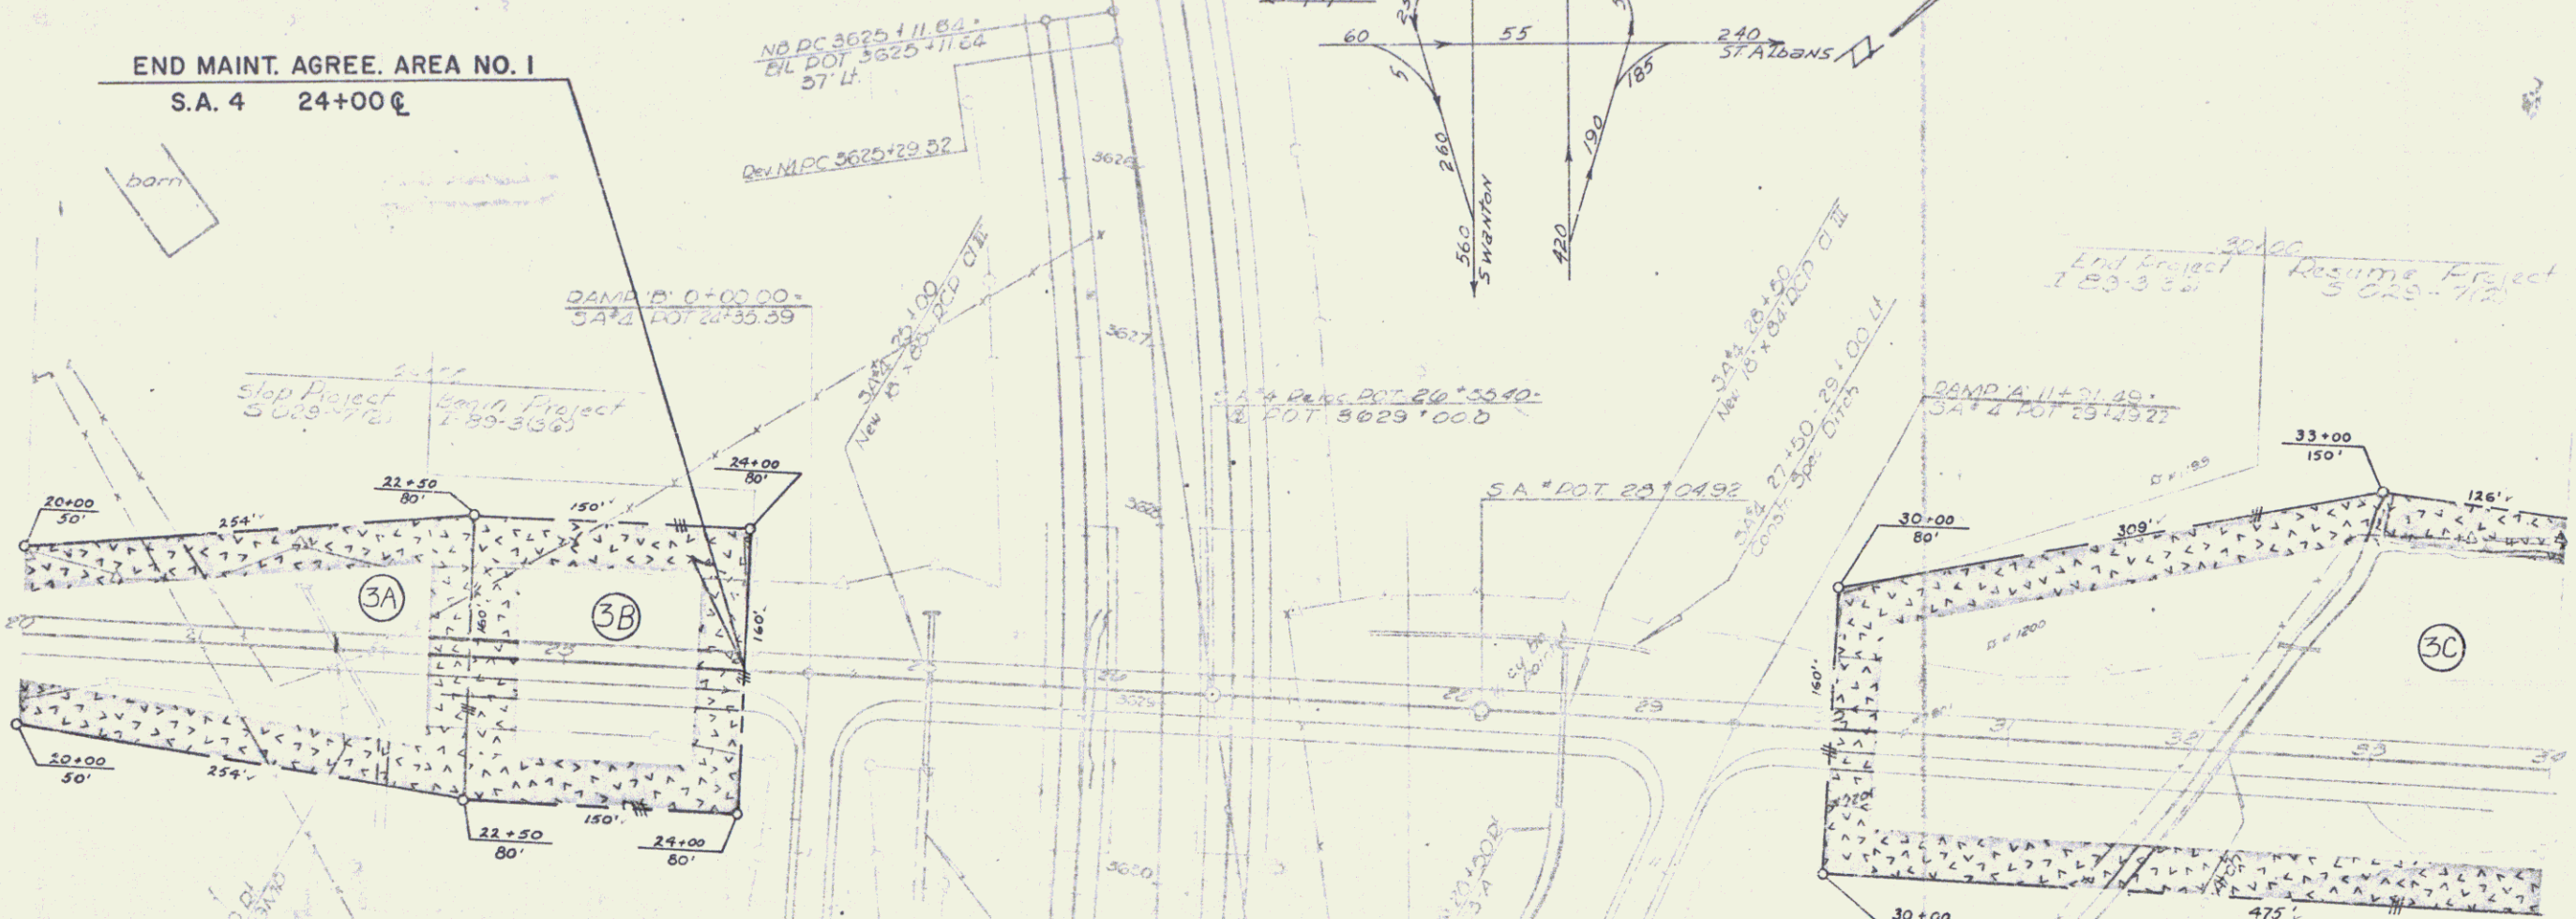


3000-3400
3000-3400

RIP RAP FCD BANK PROTECTION
ITEM 35
3A#4 31-82-14
3A#4 31-57-21

END MAINT. AGREE. AREA NO. 1
S.A. 4 24+00

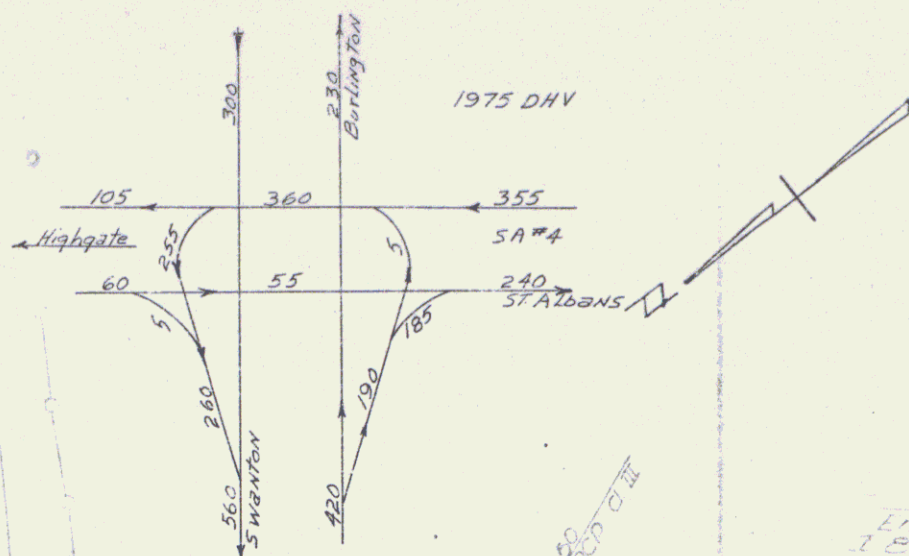

VERMONT DEPARTMENT OF HIGHWAYS
RIGHT-OF-WAY PLANS
PROJECT: SWAYTON - ST ALBANS
No. S.D. 97 (2)
SHEET 7A OF 10
Revised 10-6-64

JUL 9 1964