



PROPERTY LINE FENCE w/ STEEL POSTS  
 MOD ITEM 083-II  
 20'00" - 24'00" Lt.  
 30'00" - 34'00" Lt.  
 20'00" - 24'00" Lt.  
 30'00" - 34'00" Lt.

STONE FILL FOD BANK PROTECTION  
 ITEM 512  
 SA # 4 31'67.81 - 31'97.01  
 SA 4 32'17.14 - 32'47.14

STANDARD STEEL BEAM GUARD  
 RAIL w/ STEEL POSTS ITEM 545-A  
 31'14.01 - 32'17.81 Lt.  
 32'28.14 - 32'47.14 Lt.  
 33' + 46 Lt.

GRANITE SLOPE EDGING ITEM 556-A  
 22'00" - 24'00" Island Curbing  
 30'00" - 34'00" Island Curbing

Bit. Conc. Surface for Gutters  
 & Traffic Islands  
 Sta 30+00 - 34+00

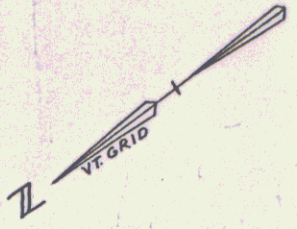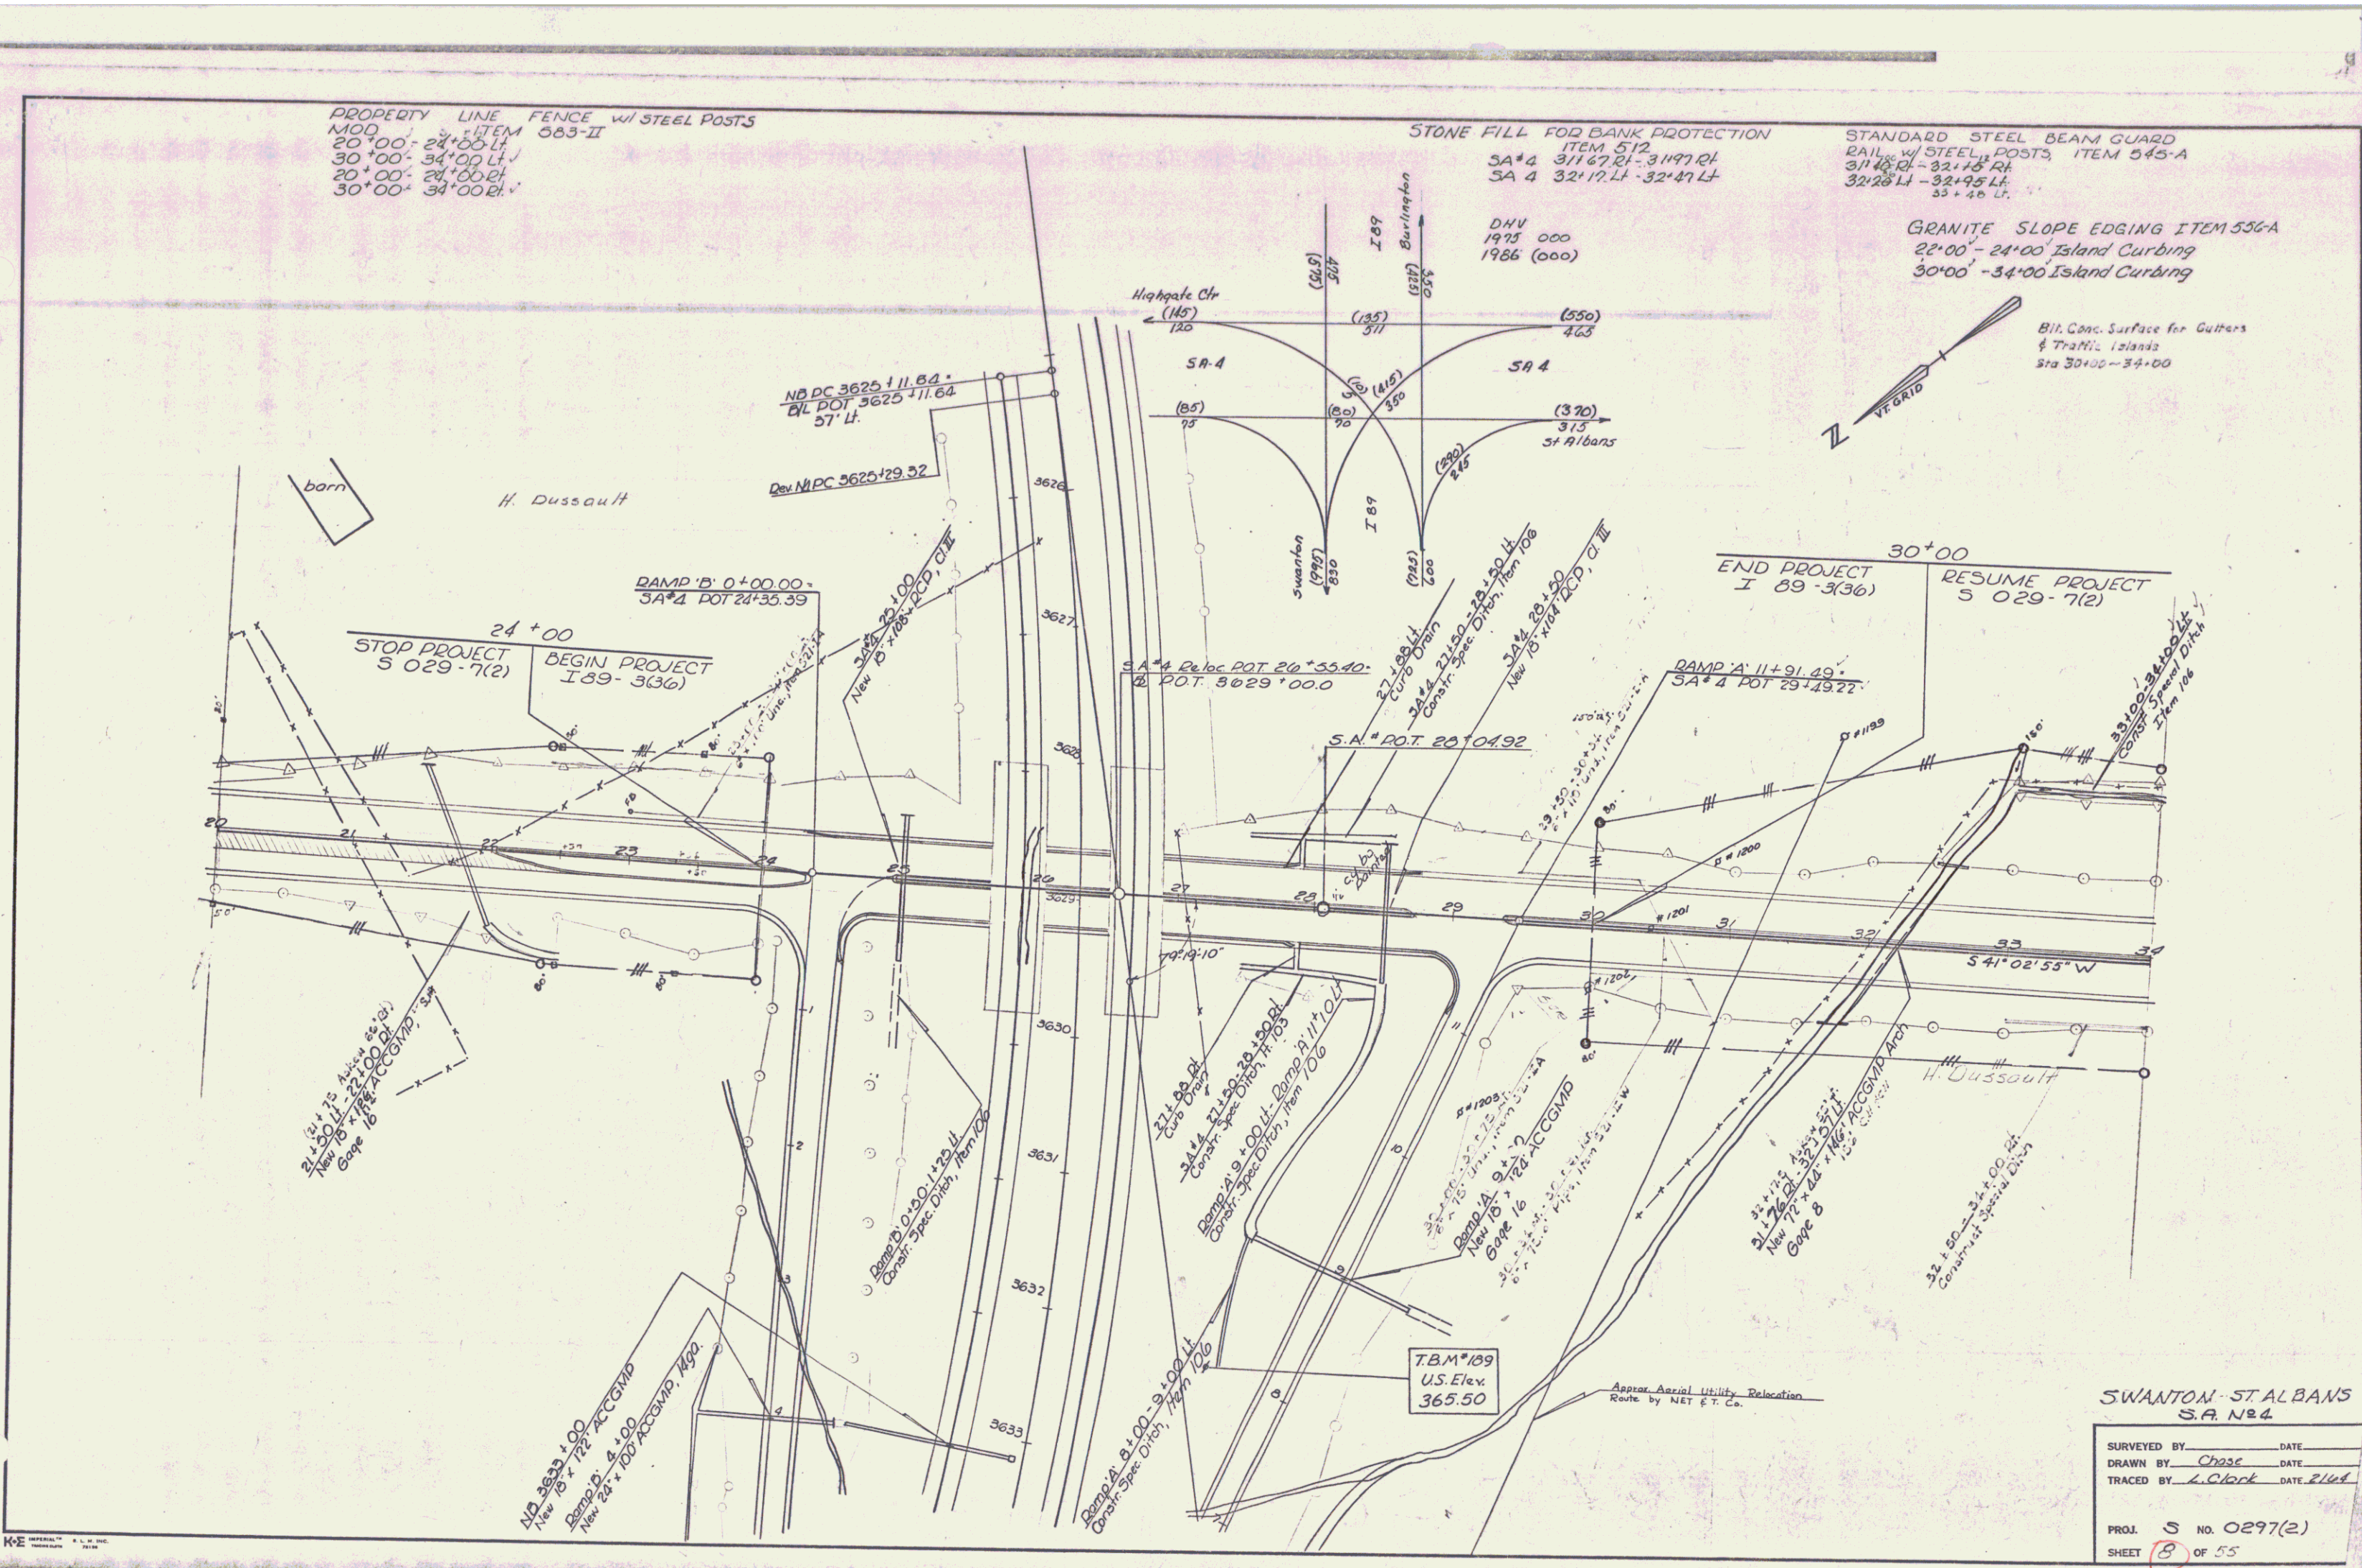

SWANTON - ST ALBANS  
 S.A. N#4

SURVEYED BY	DATE
DRAWN BY Chase	DATE
TRACED BY L. Clark	DATE 2/14
PROJ. S No. 0297(2)	
SHEET 8 OF 55	