
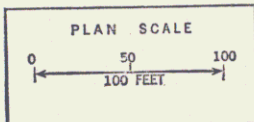


Property Line Fence with  
Steel Posts Item 583-B  
RT  
34+00-Spur 45+00 34+00-40+50

Sour Curve Data  
A 68° 05' 20" LT  
D 71° 30'  
R 763.94  
T 495.76  
L 881.19  
E Bank 15/16 per ft (10.75)

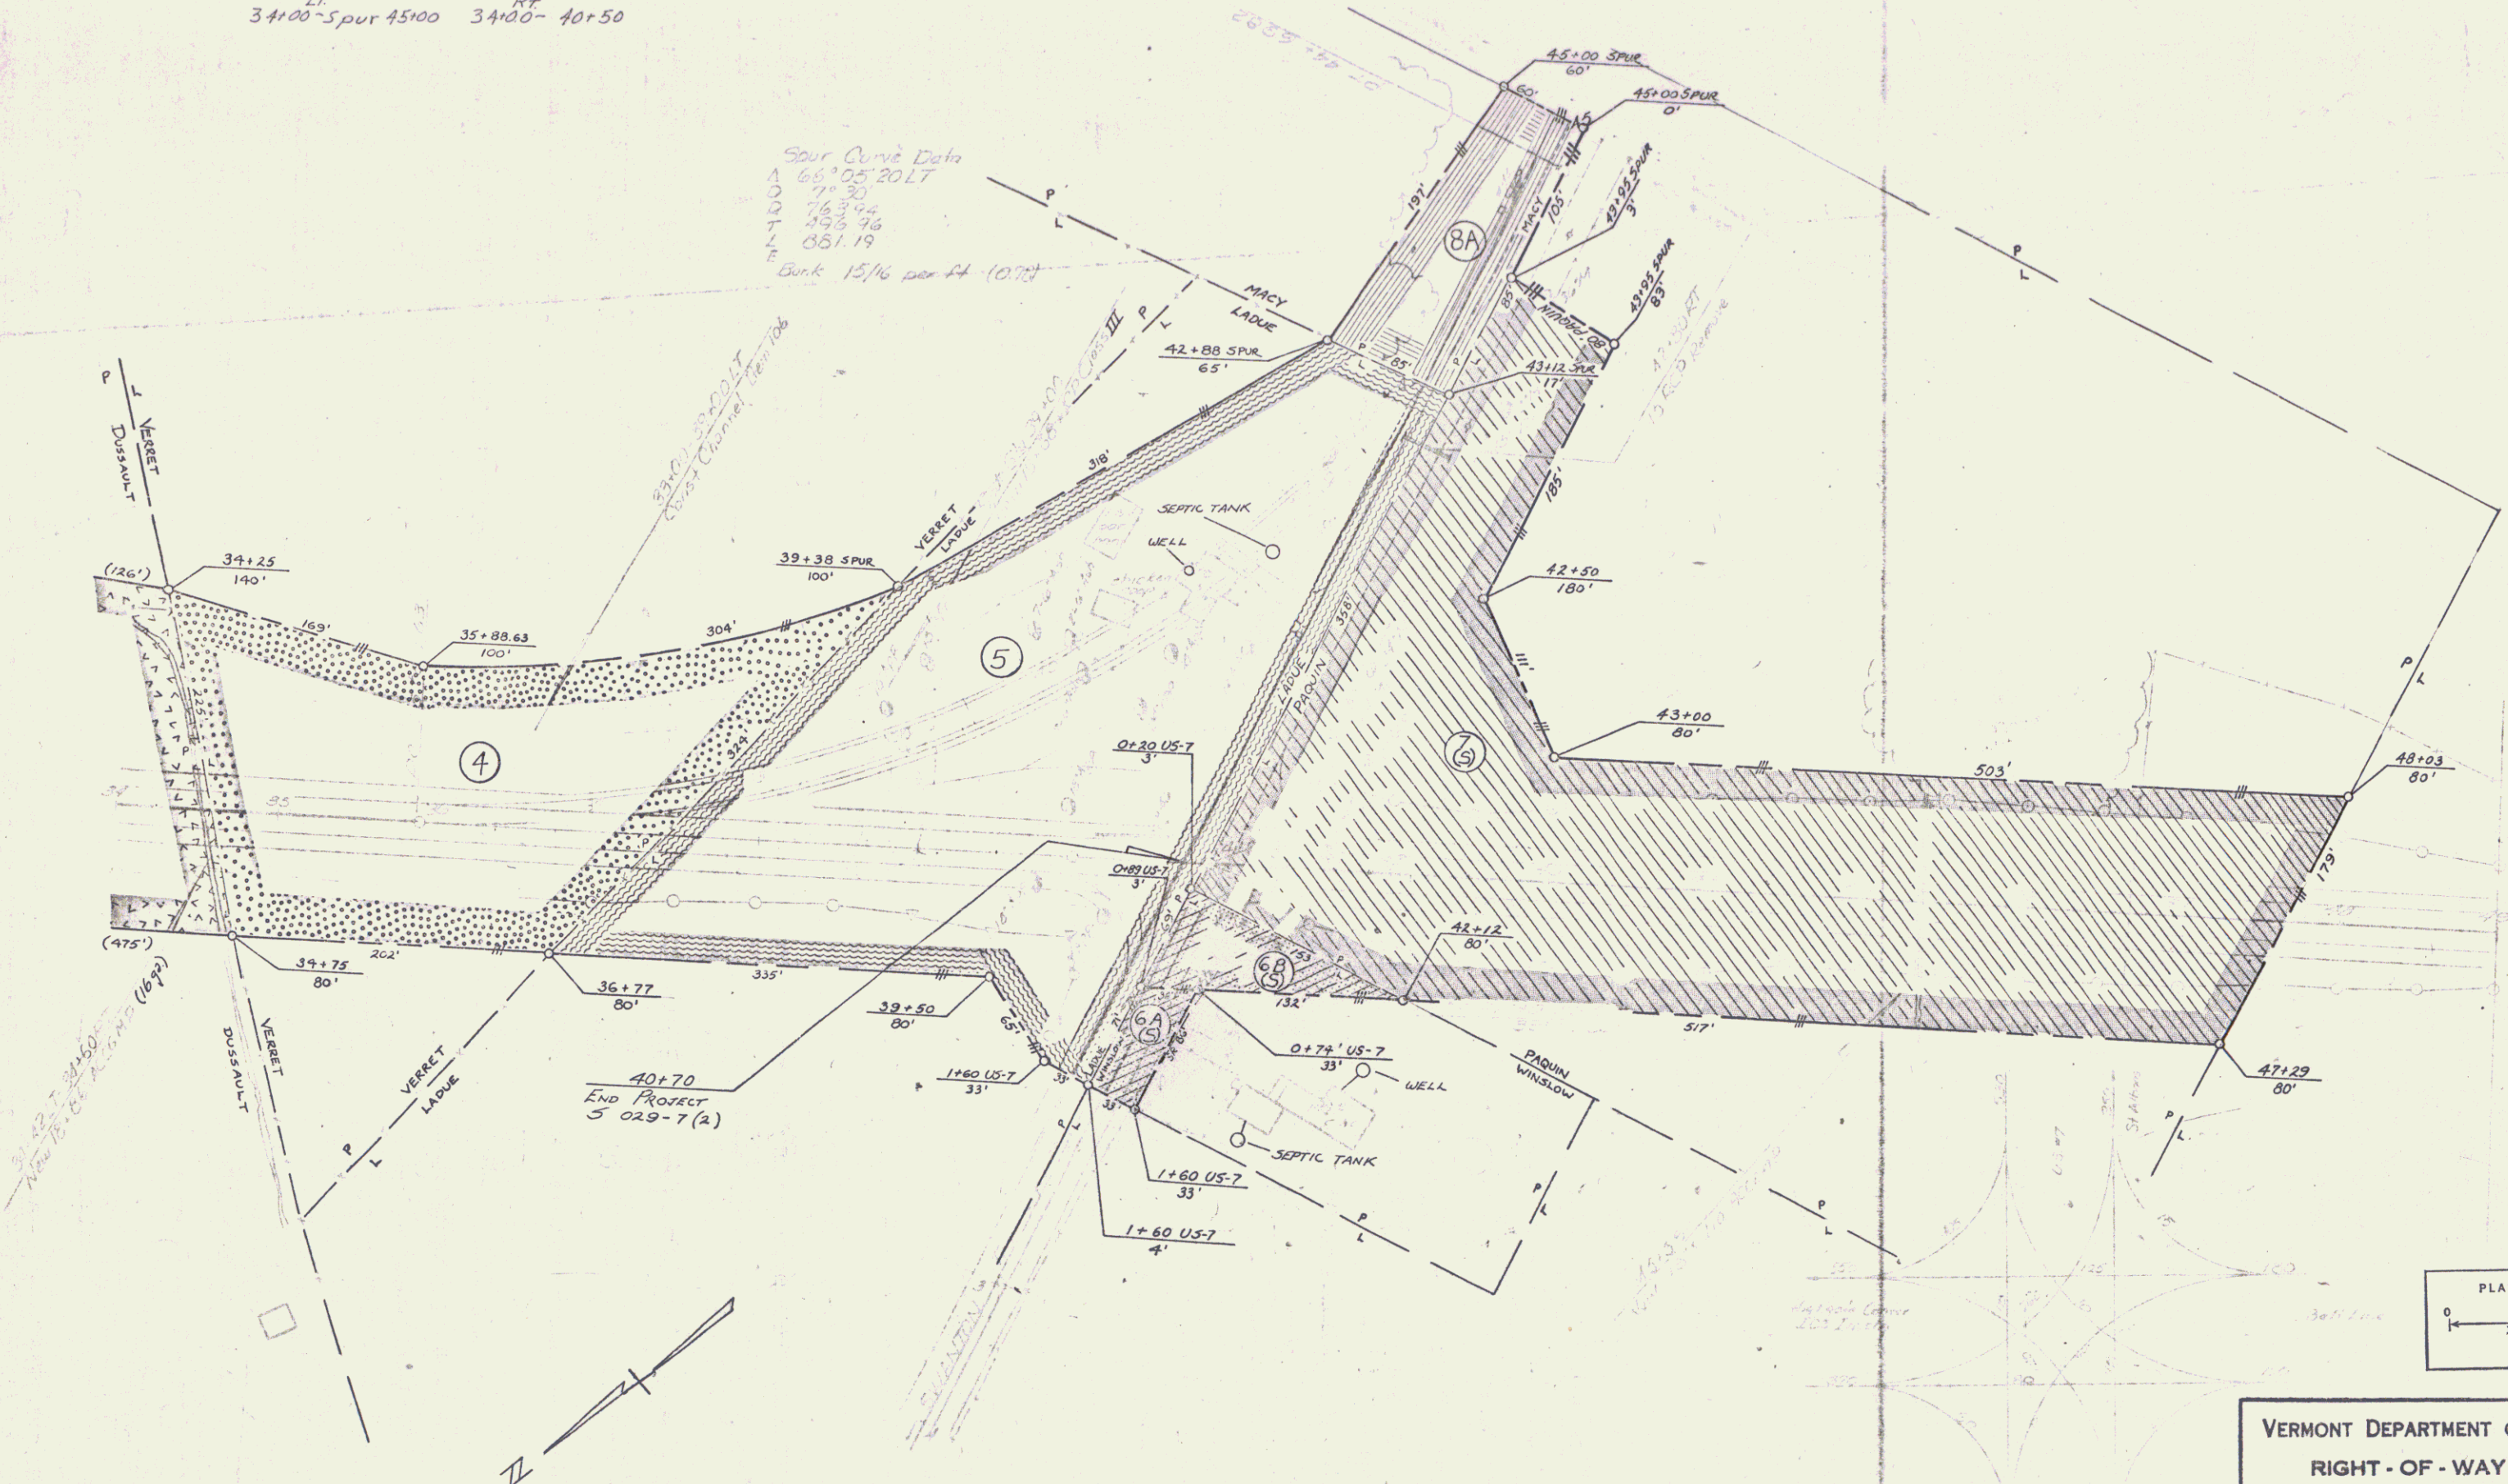

VERMONT DEPARTMENT OF HIGHWAYS  
RIGHT-OF-WAY PLANS  
PROJECT: SWANTON-ST. ALBANS  
NO. 50297(2)  
SHEET 6 OF 10  
Revised 10-6-67