

PROPERTY LINE FENCE
 MOD ITEM 583-II
 34' 00" Lt. Spur 43' 00" Lt.
 34' 00" Rt. 40' 30" Rt.


Revised Curve Data
 Δ 66°05' 20" Lt.
 D 8°00'
 R 716.20'
 L 465.90'
 E 226.11'
 T 135.20'
 Bank 7/8" per ft.

Spur Curve Data
 Δ 66°05' 20" Lt.
 D 7°30'
 R 765.94'
 L 496.96'
 E 281.19'
 T 103.19'

DEMOLITION + DISPOSAL of BUILDING
 @ 40+60 Lt. (Spur)
 @ 48+90 Lt. (Spur)
 @ 41+25 Rt. (Spur)

Spur 40+00
 End Construction
 Proj. 5 0297(2)

Bit Conc. Surface for Gutters
 + Traffic Islands
 Sta. 34+00 - 36+87

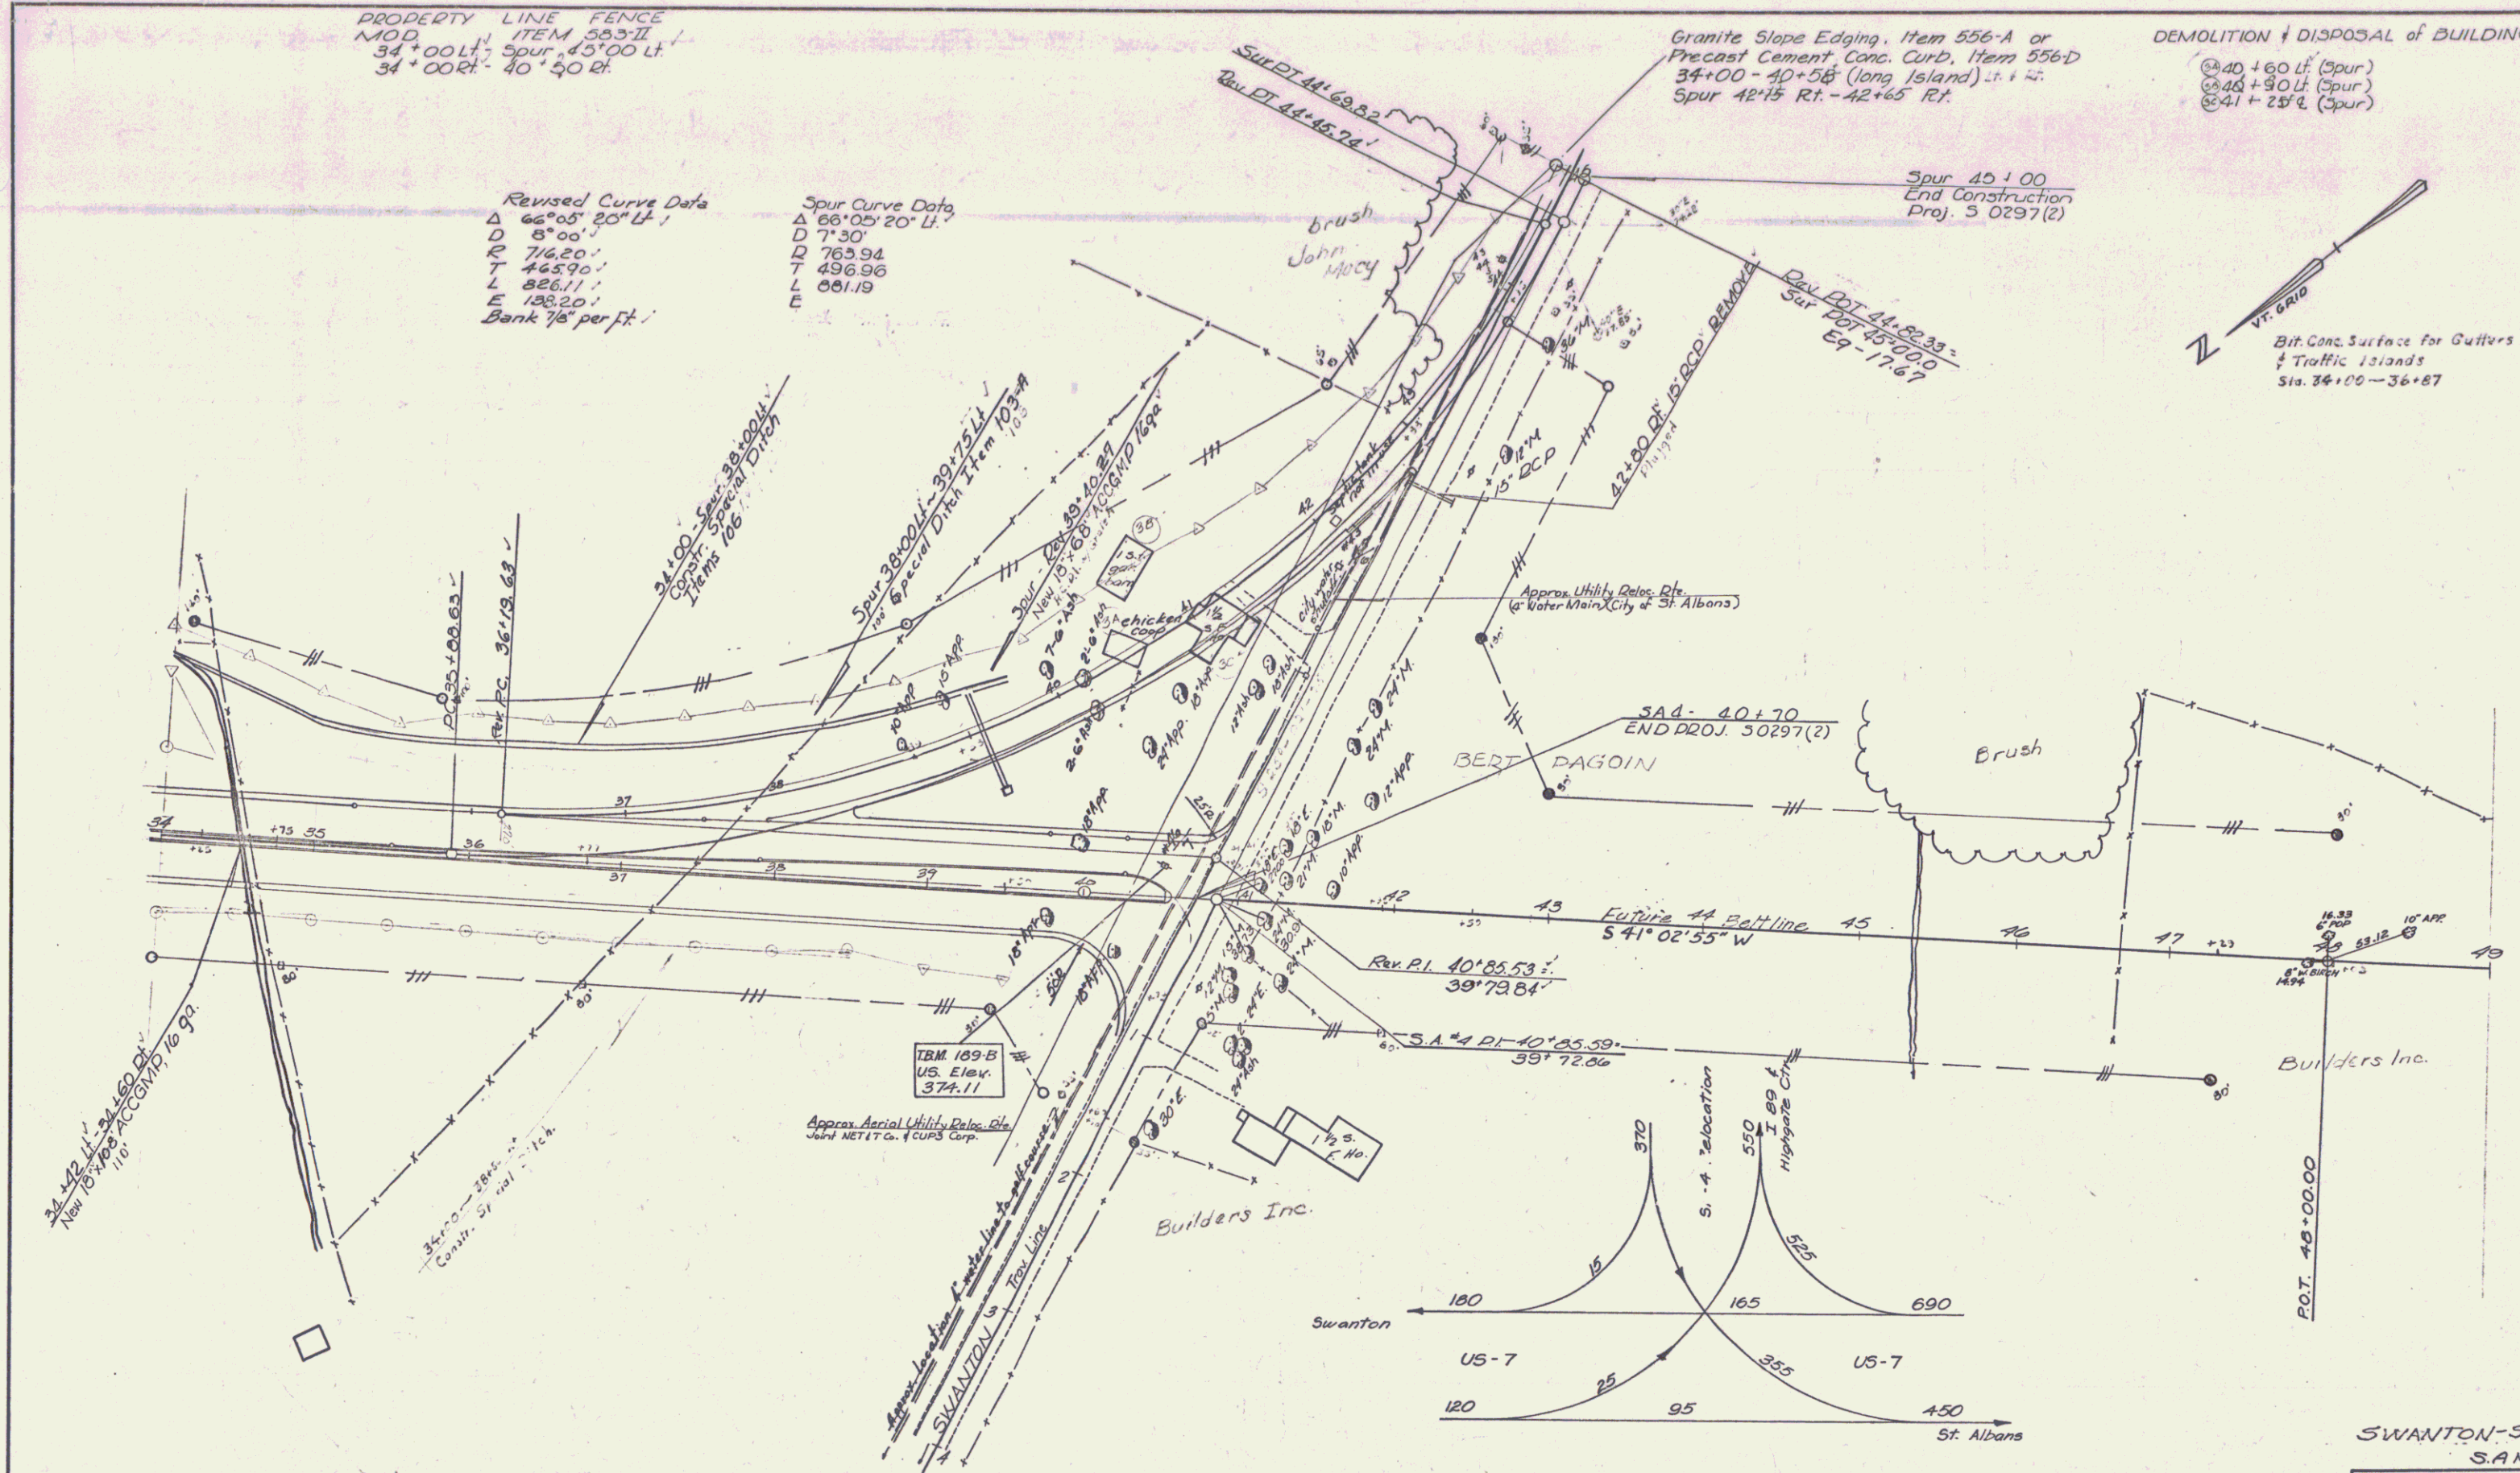

SWANTON-STALBANS
 S.A. No. 4

SURVEYED BY: _____ DATE: _____
 DRAWN BY: Chase DATE: _____
 TRACED BY: L. Clark DATE: 2/04

PROJ. S NO. 0297(2)
 SHEET 9 OF 55