


WORK TO BE DONE BY OTHERS

STATION	POS
RTE 78	LT
3 + 12	RT
3 + 34	RT

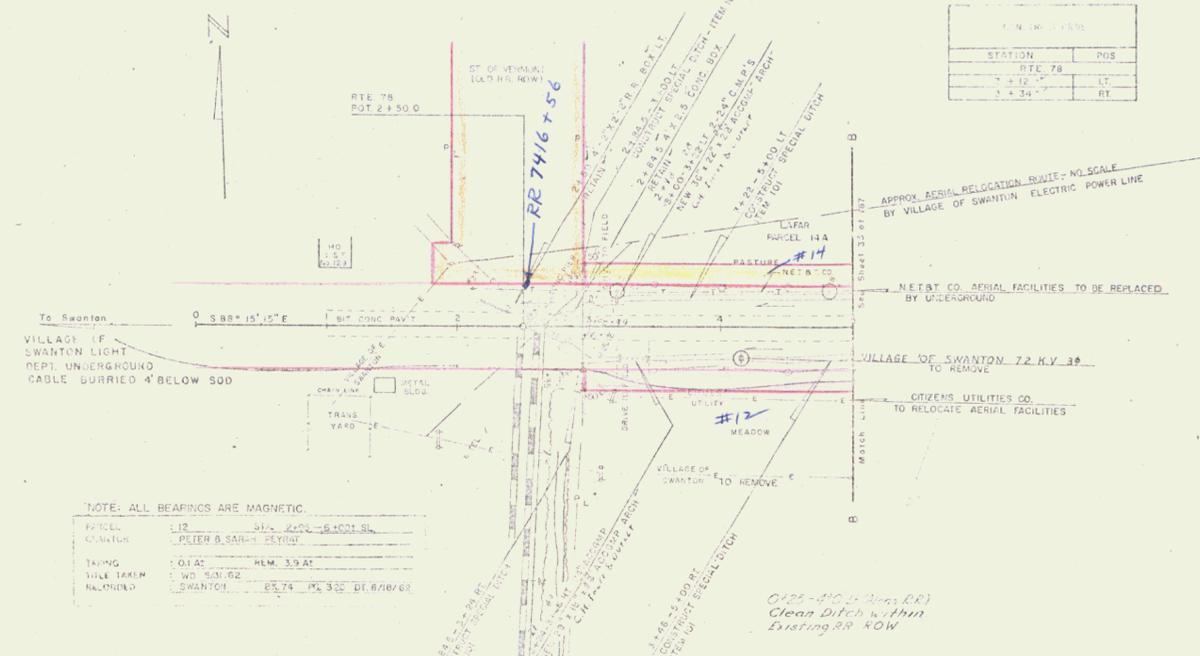

NOTE: ALL BEARINGS ARE MAGNETIC.

PROJECT	LIR	DATE	2/20/68
DESIGNER	PETER D. SANCHEZ	SCALE	AS SHOWN
DRAWN	J. O. JAC	HLM	3/9/67
CHECKED	SWANTON	DATE	05/24/68

PLAN	DATE	SCALE
SECTION		
DETAIL		
AS SHOWN		

DATE	SCALE
2/20/68	AS SHOWN



9
const Row