


CONTRACT NO. 1 DEMOLITION & REMOVAL OF BRUSH & WOODS			CONTRACT NO. 1 CONSTRUCT DECELERATION LANE (INCLUDE 250' TAPER)			CONTRACT NO. 1 CONSTRUCT ACCELERATION LANE			CONTRACT NO. 2 CONSTRUCT ACCELERATION LANE (INCLUDE 250' TAPER)			CONTRACT NO. 2 SOD REMOVAL ITEM 101			CONTRACT NO. 1 PROPERTY LINE FENCE WITH 5' x 1' PICKETS ITEM 2			CONTRACT NO. 2 MUCK EXCAVATION ITEM 116 (MUCK)			CONTRACT NO. 2 FOR SPACING & LOCATION OF DELINEATORS ALONG ACCELERATION LANE LT. LANE 620+00 - 622+89.3 RT SEE STANDARD SHEET E-8		
NO.	STATION	POS.	STATION	STATION	POS.	STATION	STATION	POS.	STATION	STATION	POS.	STATION	STATION	POS.	STATION	STATION	POS.	STATION	STATION	POS.	STATION	STATION	POS.
3	618+55	RT	617+00	616+50.2	LT	617+00	617+00		617+00	617+00		617+00	617+00		615+00	617+00	RT-RAMP B-RT-LANE	615+00	615+50	615+50	615+00	615+00	
																	LT-RAMP B-LT						

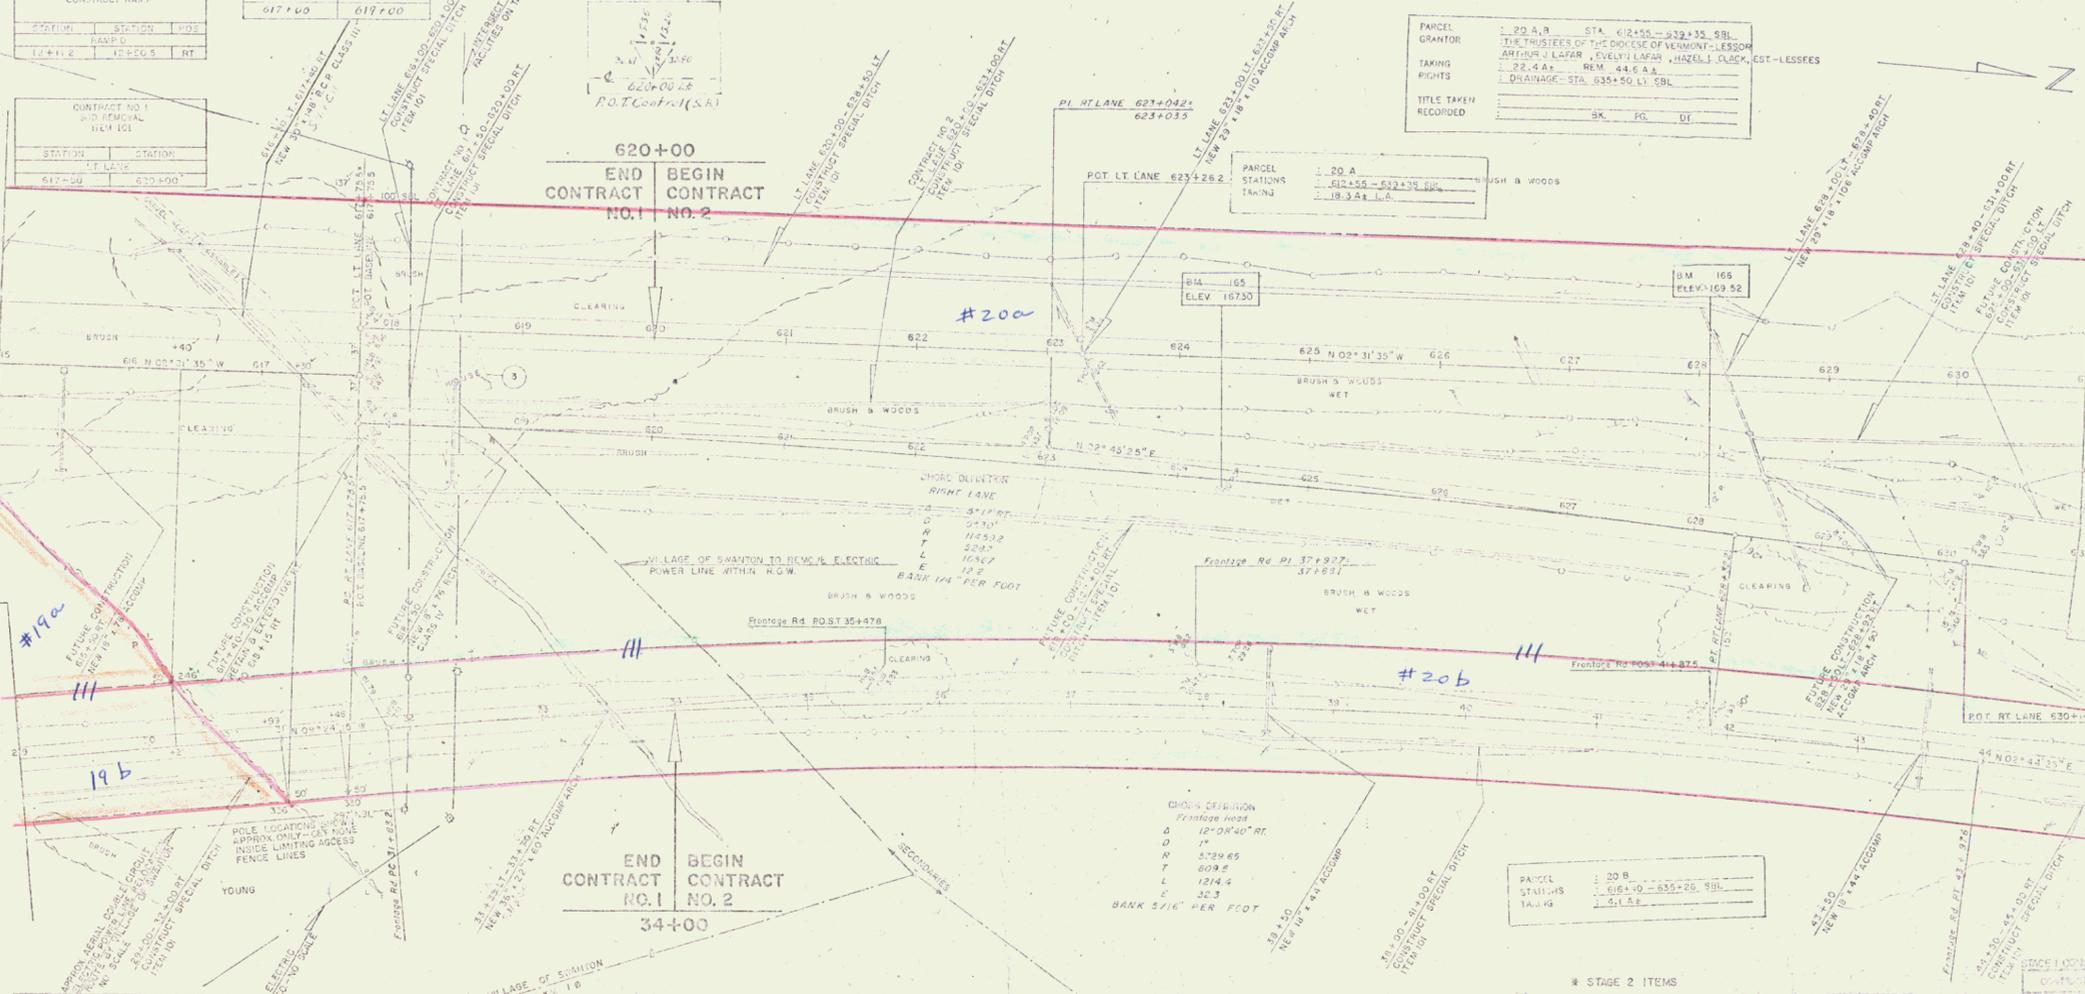

FOR PAVEMENT ELEVATIONS AT RAMP INTERSECTION SEE SHEET 19 OF 157		FUTURE CONSTRUCTION		FUTURE CONSTRUCTION		FUTURE CONSTRUCTION		FUTURE CONSTRUCTION		NOTE: ALL BEARING ARE MAGNETIC	
STATION	POS.	STATION	POS.	STATION	POS.	STATION	POS.	STATION	POS.		
616+478	RT	618+20	RT	618+20	RT	618+20	RT	618+20	RT		

* STAGE 2 ITEMS
CONTROL OF ACCESS IS COMPLETE ON THIS SHEET. STAGE 2 CONSTRUCTION
1 39-3(30)
SHEET 36 OF 222
SWANTON-HIGHWAY
PLAN
STA 615+00 TO 631+00

(21)
CONTR
12 ROW