


MUCK EXCAVATION ITEM 116 (MOD)	
STATION	STATION
FRONTAGE ROAD 57+50	58+30

SOD REMOVAL ITEM 101	
STATION	STATION
FRONTAGE ROAD 57+50	60+00

WOOD CULE POINT ITEM 102	
STATION	STATION
FRONTAGE ROAD 57+50	58+00

RR  
745+4 59.3

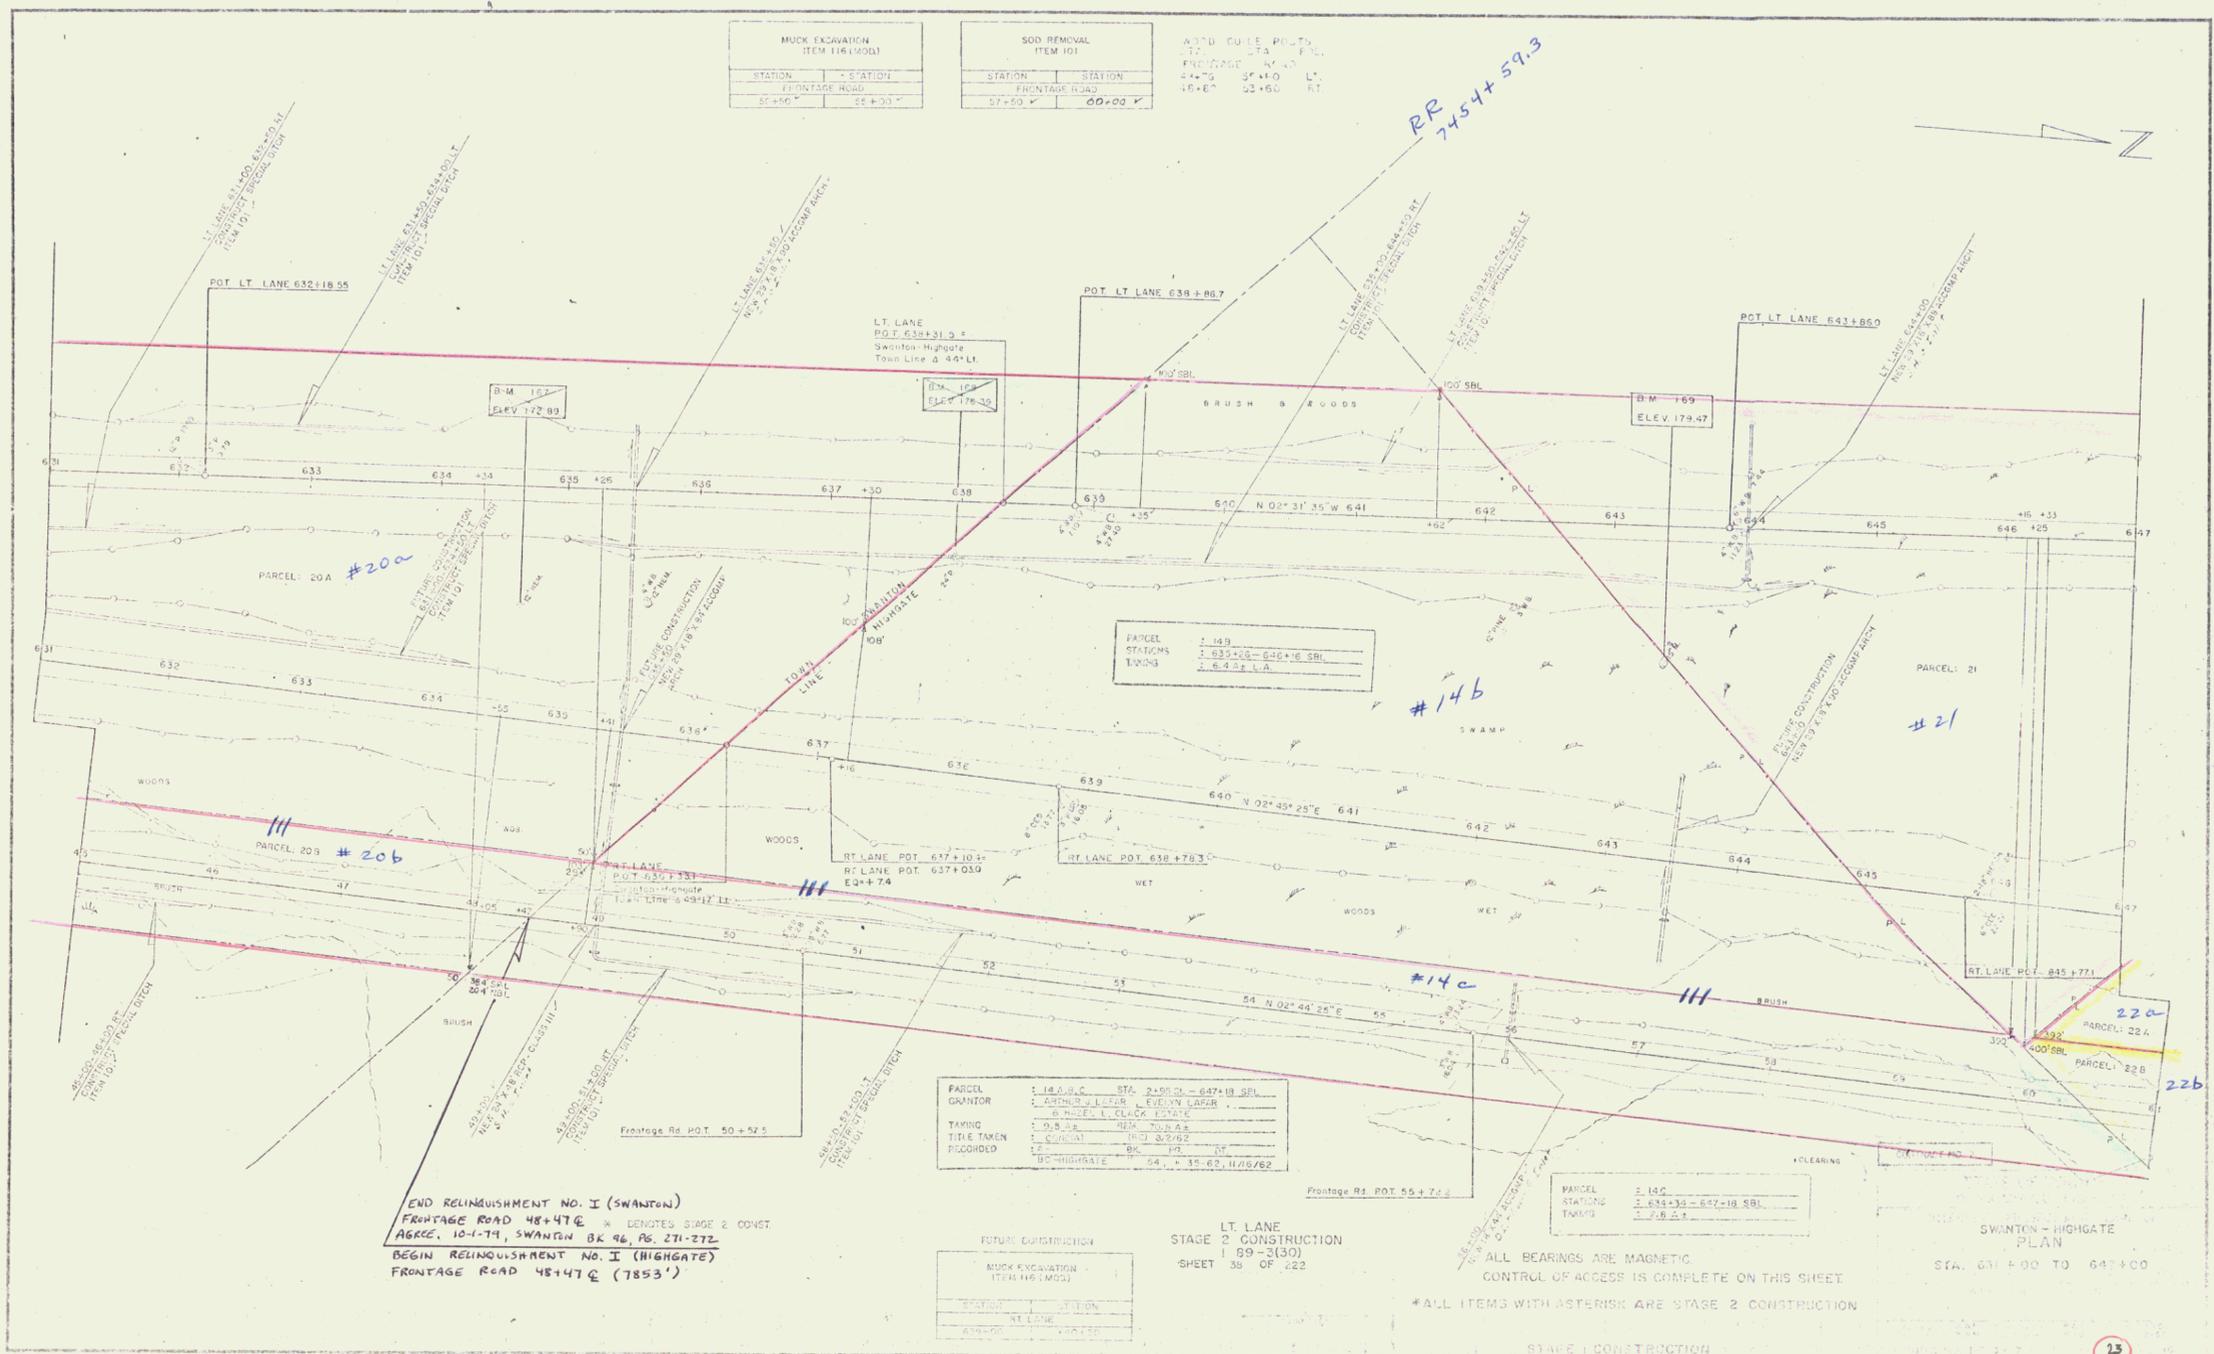

END RELINQUISHMENT NO. I (SWANTON)  
FRONTAGE ROAD 48+47E \* DENOTES STAGE 2 CONST.  
AGREE, 10-1-79, SWANTON BK 96, PG. 271-272  
BEGIN RELINQUISHMENT NO. I (HIGHGATE)  
FRONTAGE ROAD 48+47E (7853')

PARCEL	142.0.0	STA	2490.0 - 647+18 SBL
OWNER	ARCHER & LARSEN & EVELYN LARSEN		
TAKING	1-9-83	HEM	70-2-A-B
TITLE TAKEN	1-10-83	REC'D	2/262
RECORDED	1-10-83	BK	112
		PG	57
		DC	HIGHGATE
		54	1-35-82, H/16/62

FUTURE CONSTRUCTION	
STATION	STATION
FRONTAGE ROAD	FRONTAGE ROAD
57+50	60+00

LT LANE  
STAGE 2 CONSTRUCTION  
1 59-3(30)  
SHEET 35 OF 222

PARCEL	142.0.0
STATIONS	1 642+38 - 647+18 SBL
TAKING	1-9-83

ALL BEARINGS ARE MAGNETIC  
CONTROL OF ACCESS IS COMPLETE ON THIS SHEET  
\*ALL ITEMS WITH ASTERISK ARE STAGE 2 CONSTRUCTION

SWANTON - HIGHGATE  
PLAN  
STA. 631+00 TO 647+00

25

3(7)  
13  
Rocw