


CONSTRUCT APPROACH	
STATION	POS.
FRONTAGE ROAD	RT
91+50	RT

PLANK GUARD RAIL WITH PRESERVATIVE TREATMENT ITEM 541A (BARRICADE)	
STATION	POS.
LT LANE	LT
FRONTAGE ROAD	LT
93+98	LT

500 FEET WIDE ITEM 506	
STATION	POS.
FRONTAGE ROAD	RT
103+50	RT
104+50	RT

PROPERTY LINE FENCE WITH STEEL POSTS ITEM 583 (WOOD)		
STATION	POS.	POS.
LT LANE	RT	LT LANE
688+50	RT	691+35
691+35	RT	694+00
694+00	RT	697+00

WOOD GUIDE POSTS STA. TA. POS.	
FRONTAGE ROAD	POS.
FRONTAGE ROAD	RT

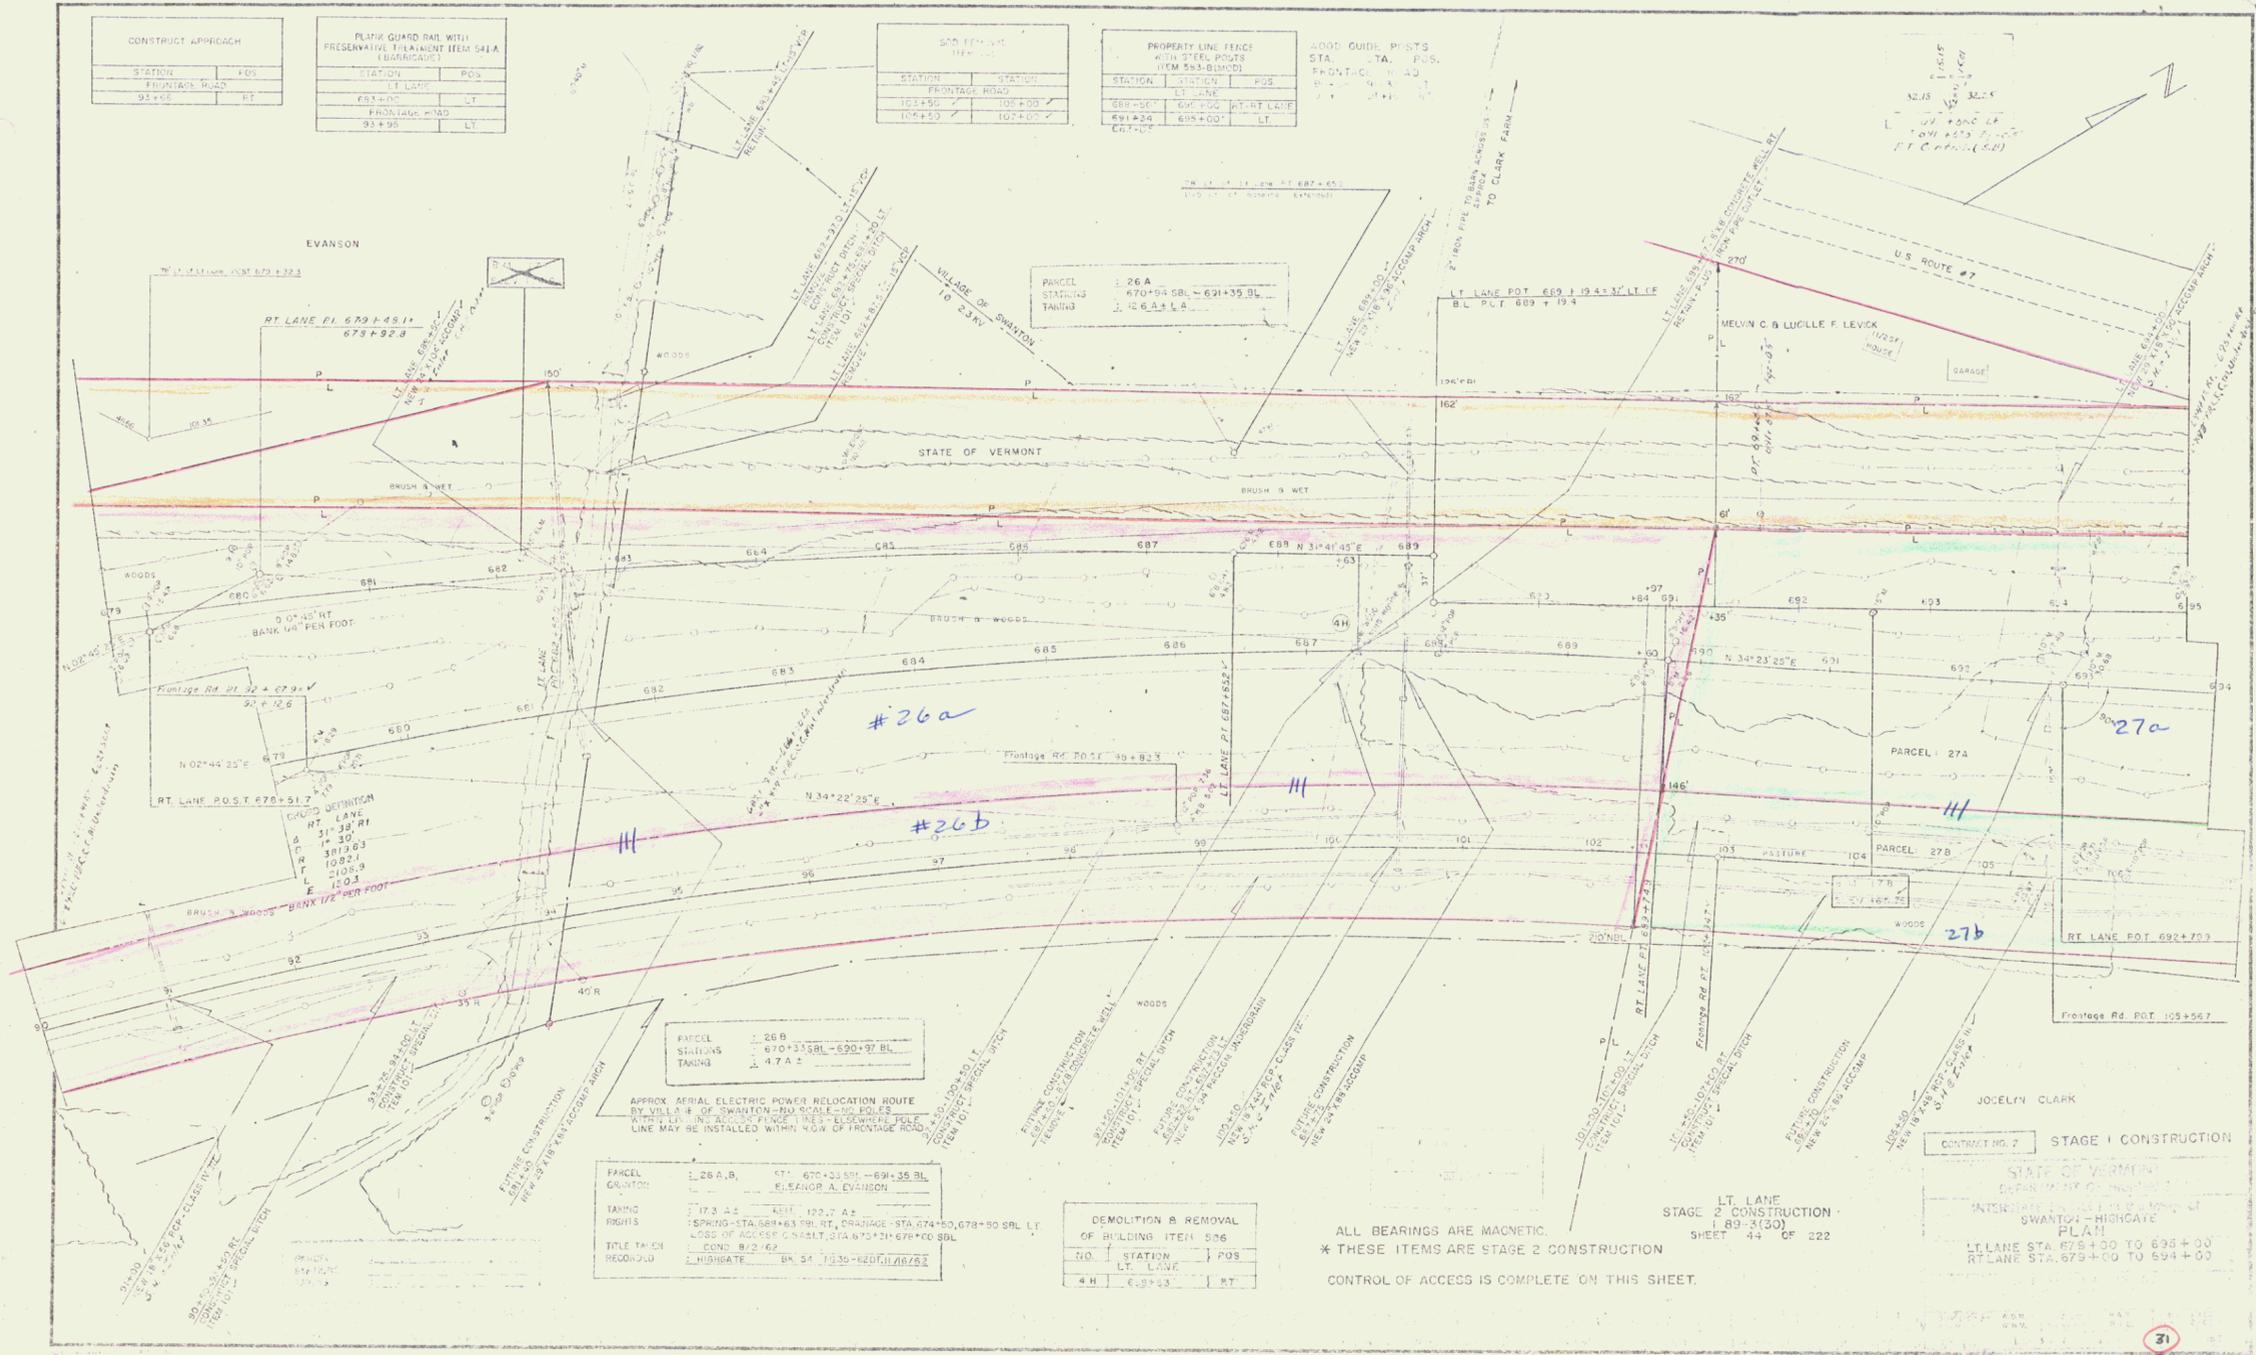

PARCEL 26B	
STATIONS	POS.
FRONTAGE ROAD	RT
103+50	RT
104+50	RT

PARCEL 26A, B	
STATIONS	POS.
FRONTAGE ROAD	RT
103+50	RT
104+50	RT

DEMOLITION & REMOVAL OF BUILDING ITEM 506	
NO.	POS.
4H	68+63

ALL BEARINGS ARE MAGNETIC.  
\* THESE ITEMS ARE STAGE 2 CONSTRUCTION  
CONTROL OF ACCESS IS COMPLETE ON THIS SHEET.

CONTRACT NO. 7 STAGE 1 CONSTRUCTION  
STATE OF VERMONT  
DEPARTMENT OF TRANSPORTATION  
INTERSTATE 93 RAMP FROM SWANTON-HIGHGATE  
PLAN  
LT LANE STA. 675+00 TO 699+00  
RT LANE STA. 679+00 TO 694+00

31  
RCC

17