


STATION	STATION	FOR
123+00	125+20	LT

STATION	STATION
123+50	125+50

STATION	POS
716+75	RT
717+50	LT

STATION	STATION	POS
711+00	727+00	RT-LT LANE
711+00	727+00	LT

STATION	STATION
715+50	717+15
717+50	727+00

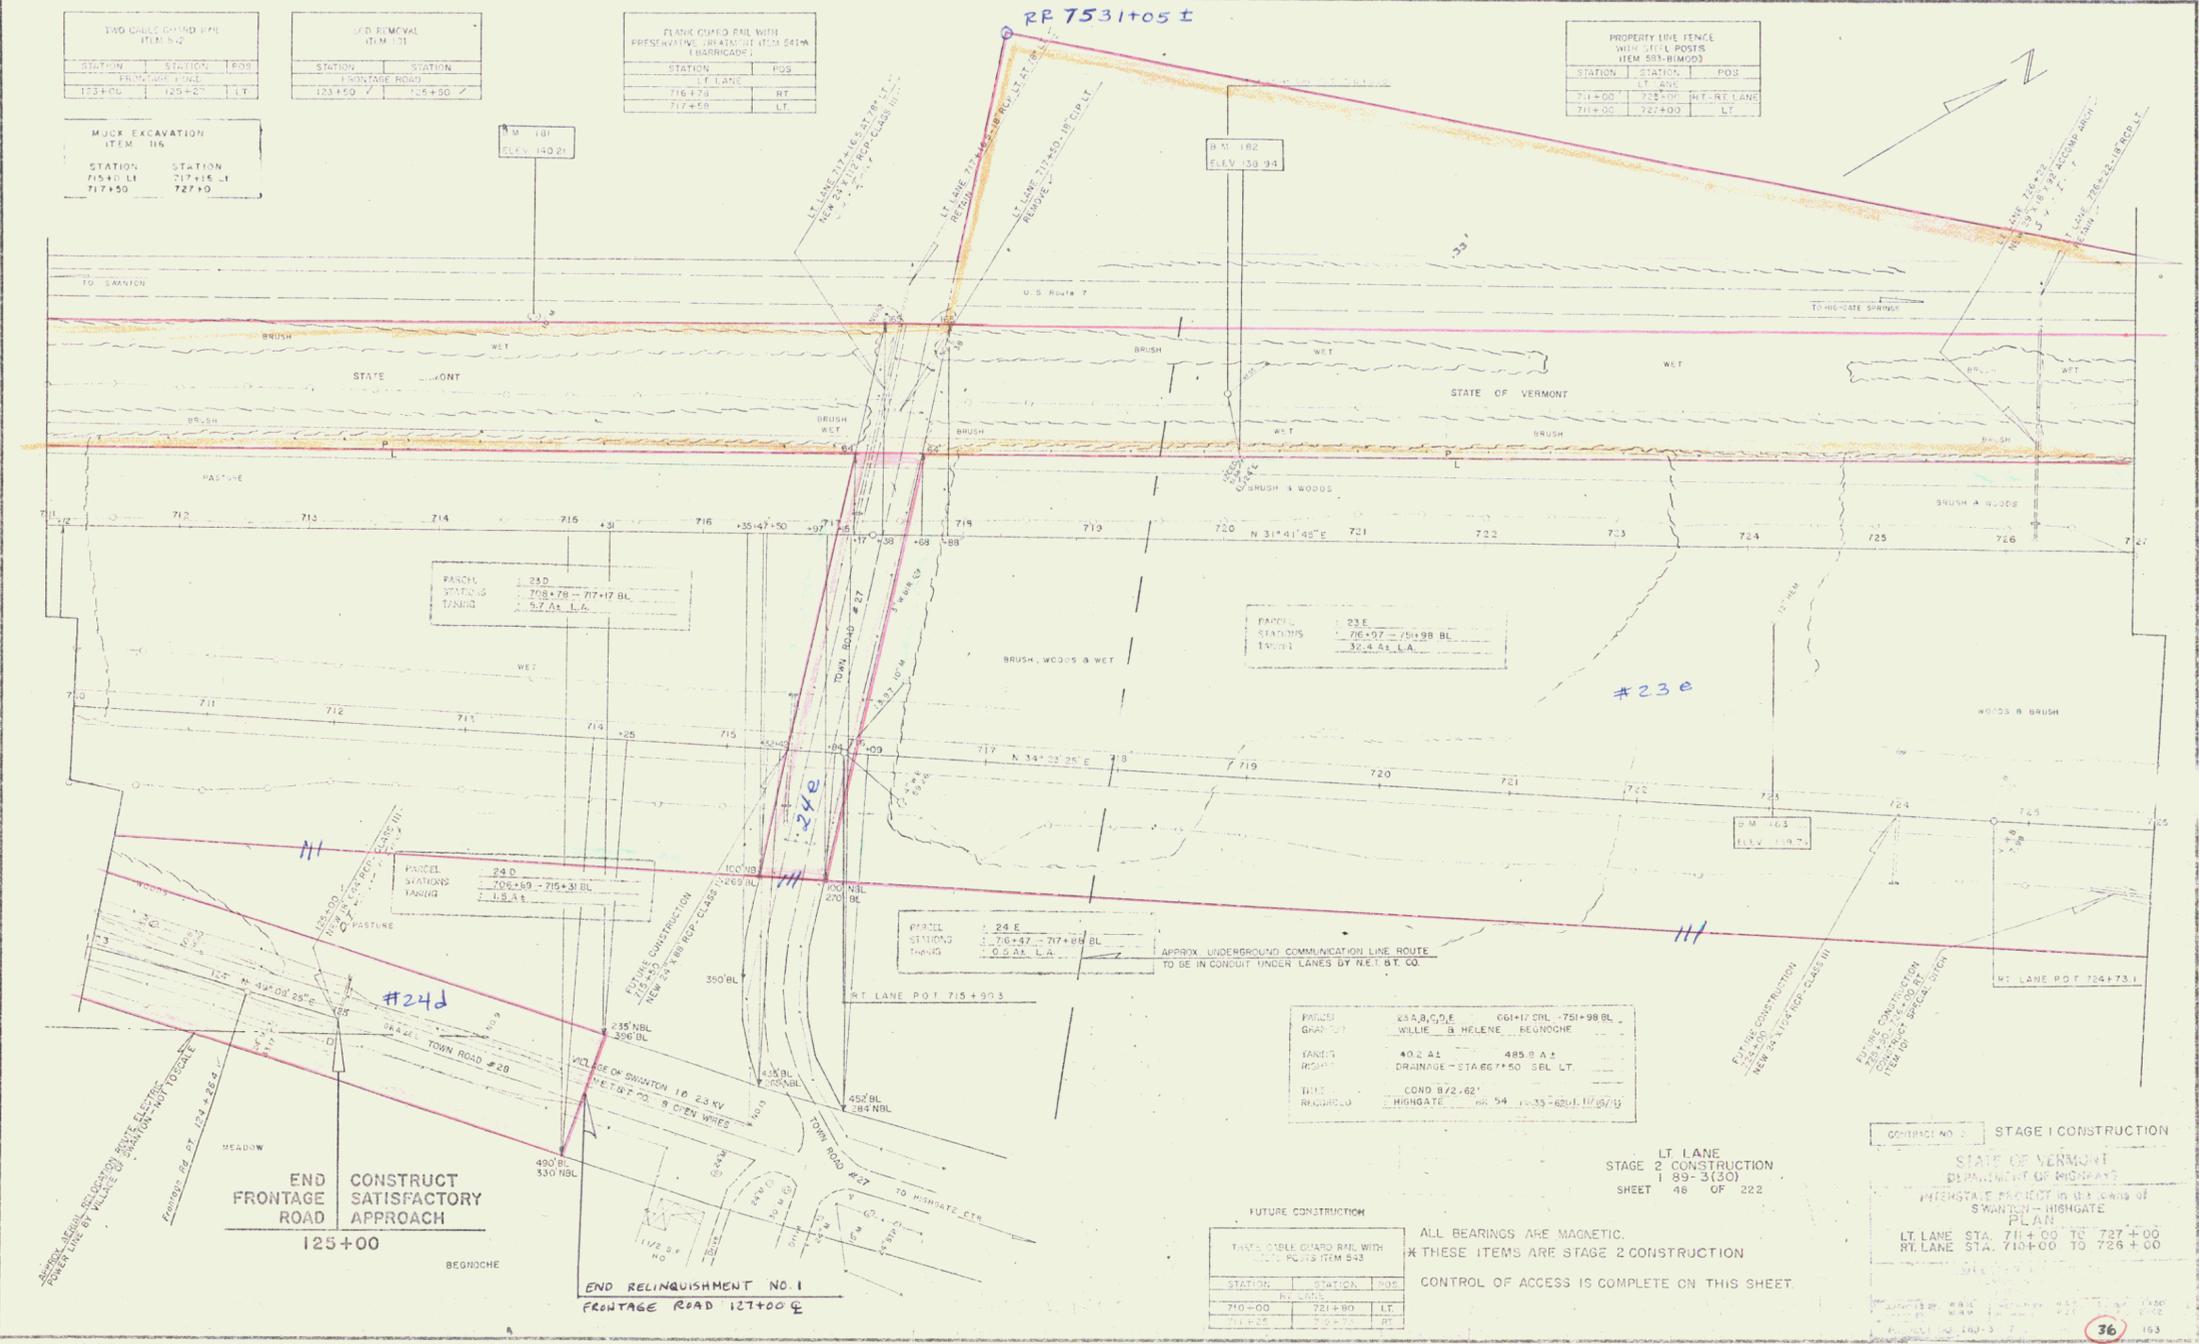

END FRONTAGE ROAD
CONSTRUCT SATISFACTORY APPROACH
125+00

END RELINQUISHMENT NO. 1
FRONTAGE ROAD 127+00

STATION	STATION	POS
710+00	721+90	LT
711+00	727+00	RT

ALL BEARINGS ARE MAGNETIC.
* THESE ITEMS ARE STAGE 2 CONSTRUCTION
CONTROL OF ACCESS IS COMPLETE ON THIS SHEET

LT LANE
STAGE 2 CONSTRUCTION
189-3(30)
SHEET 46 OF 222

STAGE I CONSTRUCTION
STATE OF VERMONT
DEPARTMENT OF HIGHWAYS
INTERSTATE PROJECT IN THE STATE OF VERMONT - HIGHGATE
PLAN
LT LANE STA. 711+00 TO 727+00
RT LANE STA. 710+00 TO 726+00

36
ROW
+
19 Const