


PROPERTY LINE FENCE WITH STEEL POSTS ITEM 593.8(MOD)		
STATION	STATION	POST
758+00	772+00	LT LANE
758+00	772+00	RT LANE
772+00	772+00	

500 BUSHES ITEM 101	
STATION	STATION
766+00	766+00
766+00	767+00

MUCK DEPOSITION ITEM 110 (MOD)	
STATION	STATION
778+50	775+00

FOR SUMMARY OF LANDSCAPE MATERIALS SEE SHEET 6 OF 163

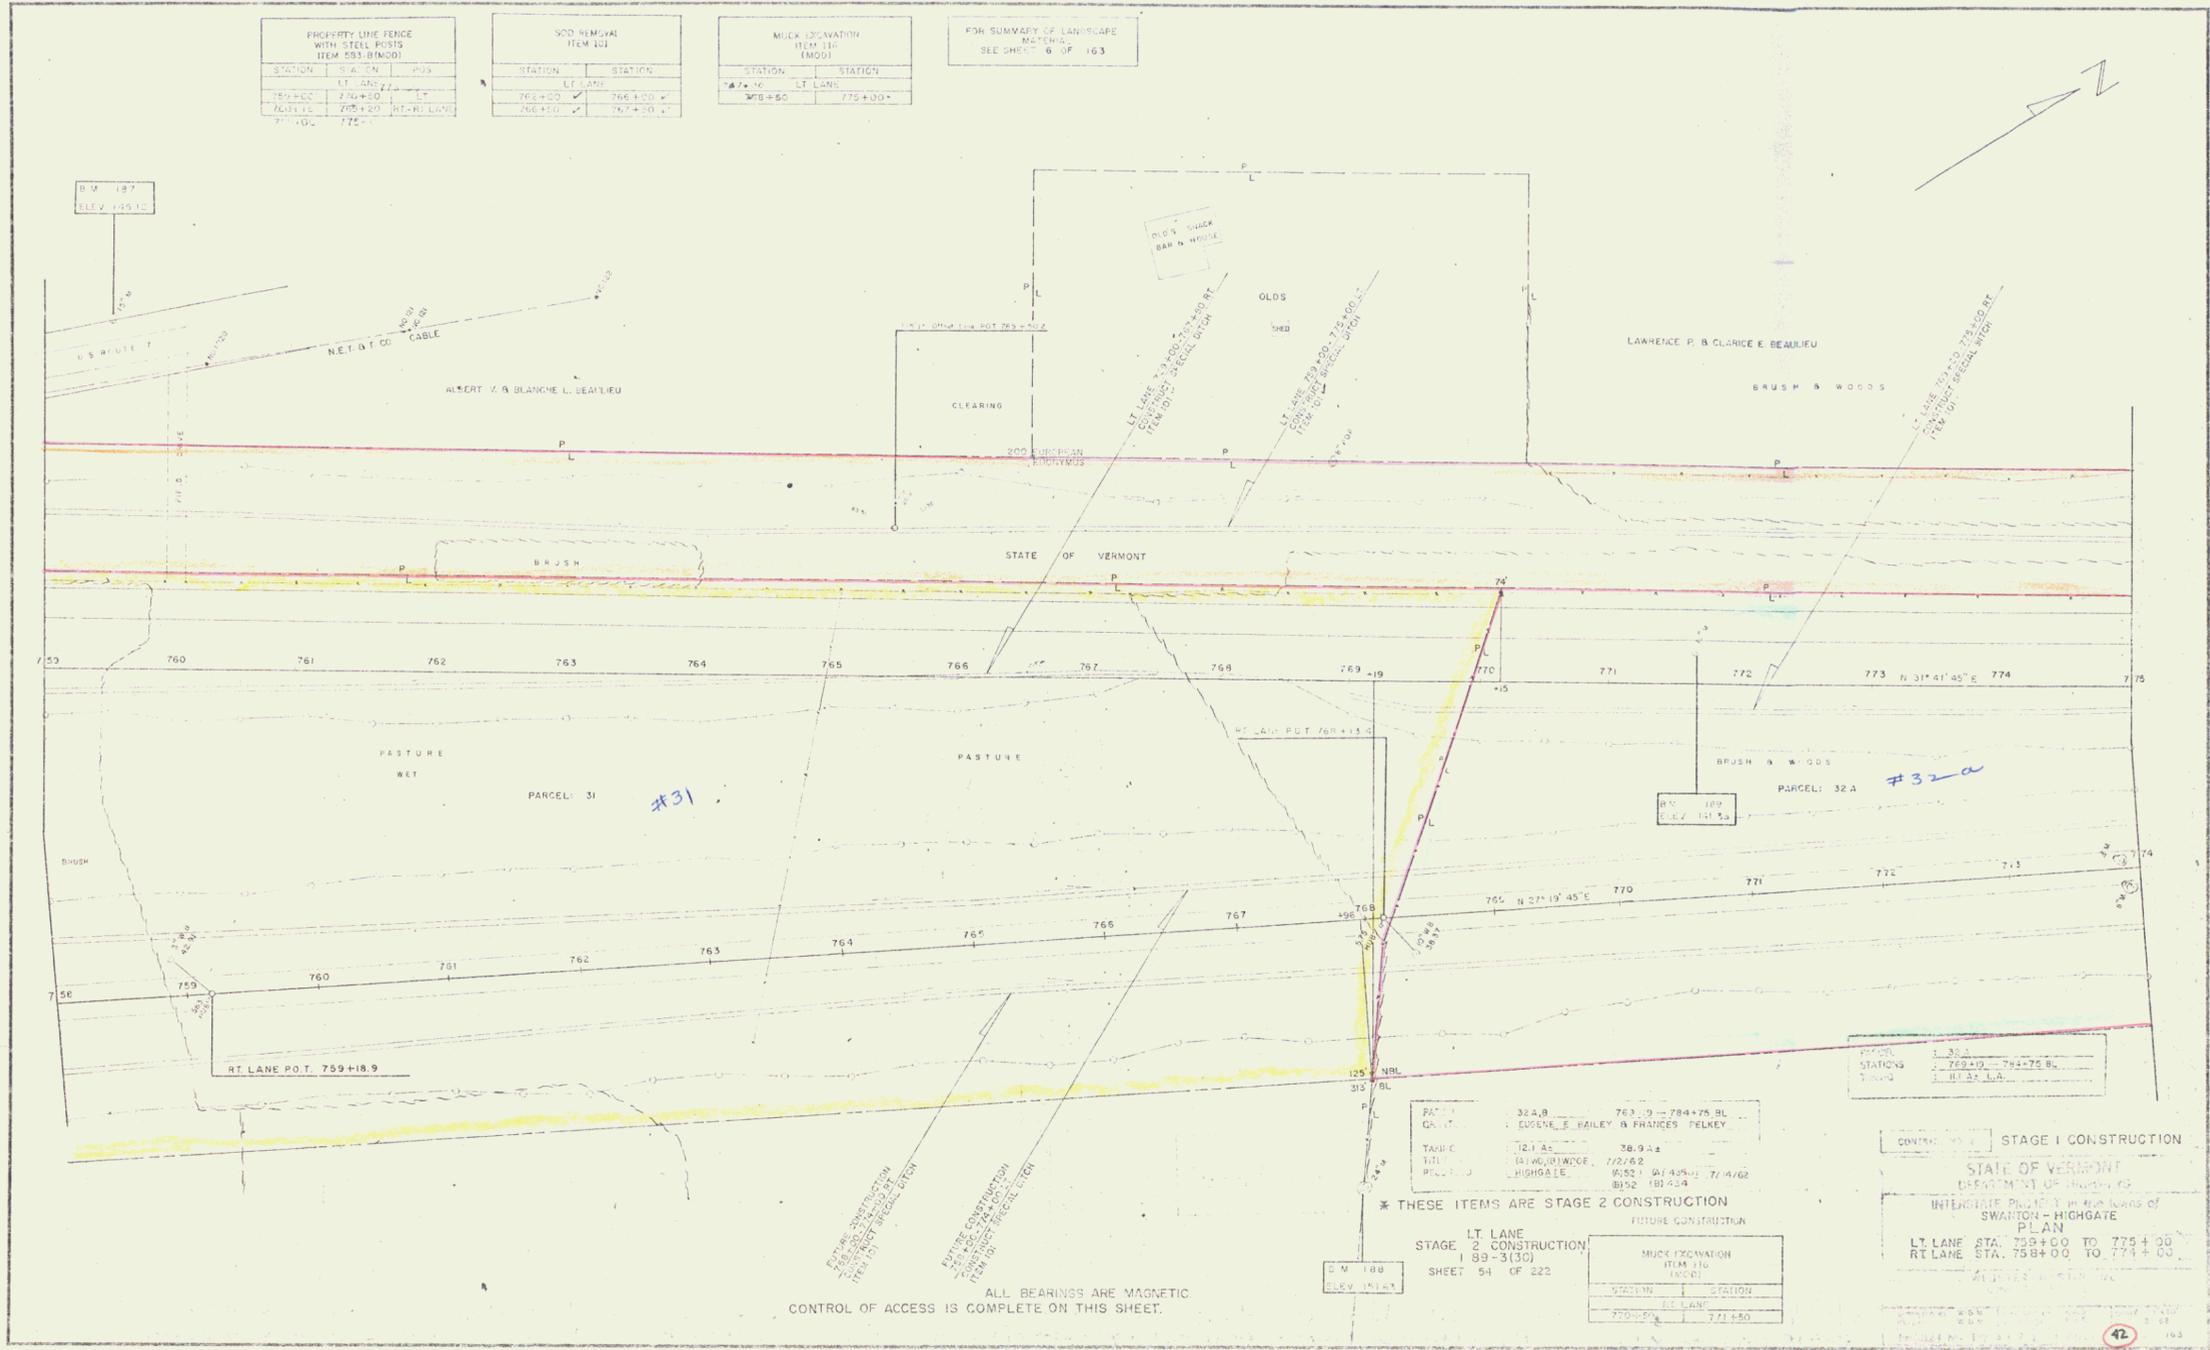

B.M. 187
ELEV. 155.12

759 760 761 762 763 764 765 766 767 768 769+10 770 771 772 773 N. 31° 41' 45" E 774 775

758 759 760 761 762 763 764 765 766 767 768 769 N. 27° 19' 45" E 770 771 772 773

RT LANE P.O.T. 759+18.9

#31

#32a

PARCEL	32A,B	763.9 - 784+75 BL
OWNER	EUGENE S. BAILEY & FRANCES PELKEY	
TAXID	12.1 A	76.9 A
TITLE	(A) W. B. WINDO 7/2/82	
RECORD	HIGHGATE	8581 (RT 450) 7/4/82
		8192 (RT 534)

* THESE ITEMS ARE STAGE 2 CONSTRUCTION

LT LANE	
STAGE 2 CONSTRUCTION	
1 89-3(30)	
SHEET 54 OF 222	
B.M. 188	ELEV. 151.67
MUCK DEPOSITION	
ITEM 110	
STATION	STATION
770+50	771+50

CONTRACT NO. 2 STAGE I CONSTRUCTION

STATE OF VERMONT
DEPARTMENT OF TRANSPORTATION
INTERSTATE ROUTE 5 IN BUSINESS OF
SWANTON - HIGHGATE
PLAN
LT LANE STA. 758+00 TO 775+00
RT LANE STA. 758+00 TO 771+00

ALL BEARINGS ARE MAGNETIC
CONTROL OF ACCESS IS COMPLETE ON THIS SHEET.

CONST
ROW 22