

CONTRACT 2 PROPERTY LINE FENCE WITH STEEL POSTS (ITEM 822-BIMOD)			
STATION	STATION	POS	
778+30	785+17	LT	
782+10	784+40	RT-RT LANE	
785+54	790+00	LT	
784+80	790+00	RT-RT LANE	

CONTRACT 2 TWO CARLE GARD RAIL (ITEM 542)			
STATION	STATION	POS	
35+95	39+55	RT	
36+66	39+46	LT	
41+27	42+63	LT	
41+37	42+57	RT	

CONTRACT 2 DIMENSION & REMOVAL OF BUILDING ITEM 5			
NO	STATION	POS	
6A	787+05	RT	
6B	787+80	RT	
6C	788+80	RT	

CONTRACT 2 MUCK EXCAVATION ITEM 115 (MOD)			
STATION	STATION		
775+00	777+00		
788+82	790+00		

CONTRACT 3 PROPERTY LINE FENCE WITH STEEL POSTS (ITEM 822-BIMOD)			
STATION	STATION	POS	
790+00	791+00	LT	
790+00	791+00	RT-RT LANE	


CONTRACT 3 MUCK EXCAVATION ITEM 116 (MOD)			
STATION	STATION		
790+00	791+00		

CONTRACT 3 EXCAVATION & REMOVAL OF ROAD SURFACE OR ROADWAYS ITEM 111-A			
STATION	STATION	POS	
790+80	791+00	RT	

CONTRACT 2 FILL TO BE MADE OF GRANULAR MATERIALS (ITEM 10)			
STATION	STATION		
43+50	45+00		

CONTRACT 2 FILLS TO BE MADE OF GRANULAR MATERIALS (ITEM 10)			
STATION	STATION		
37+17	42+45		

CONTRACT 2 FOR SUMMARY OF LANDSCAPE MATERIAL SEE SHEET 6 OF 163			
--	--	--	--

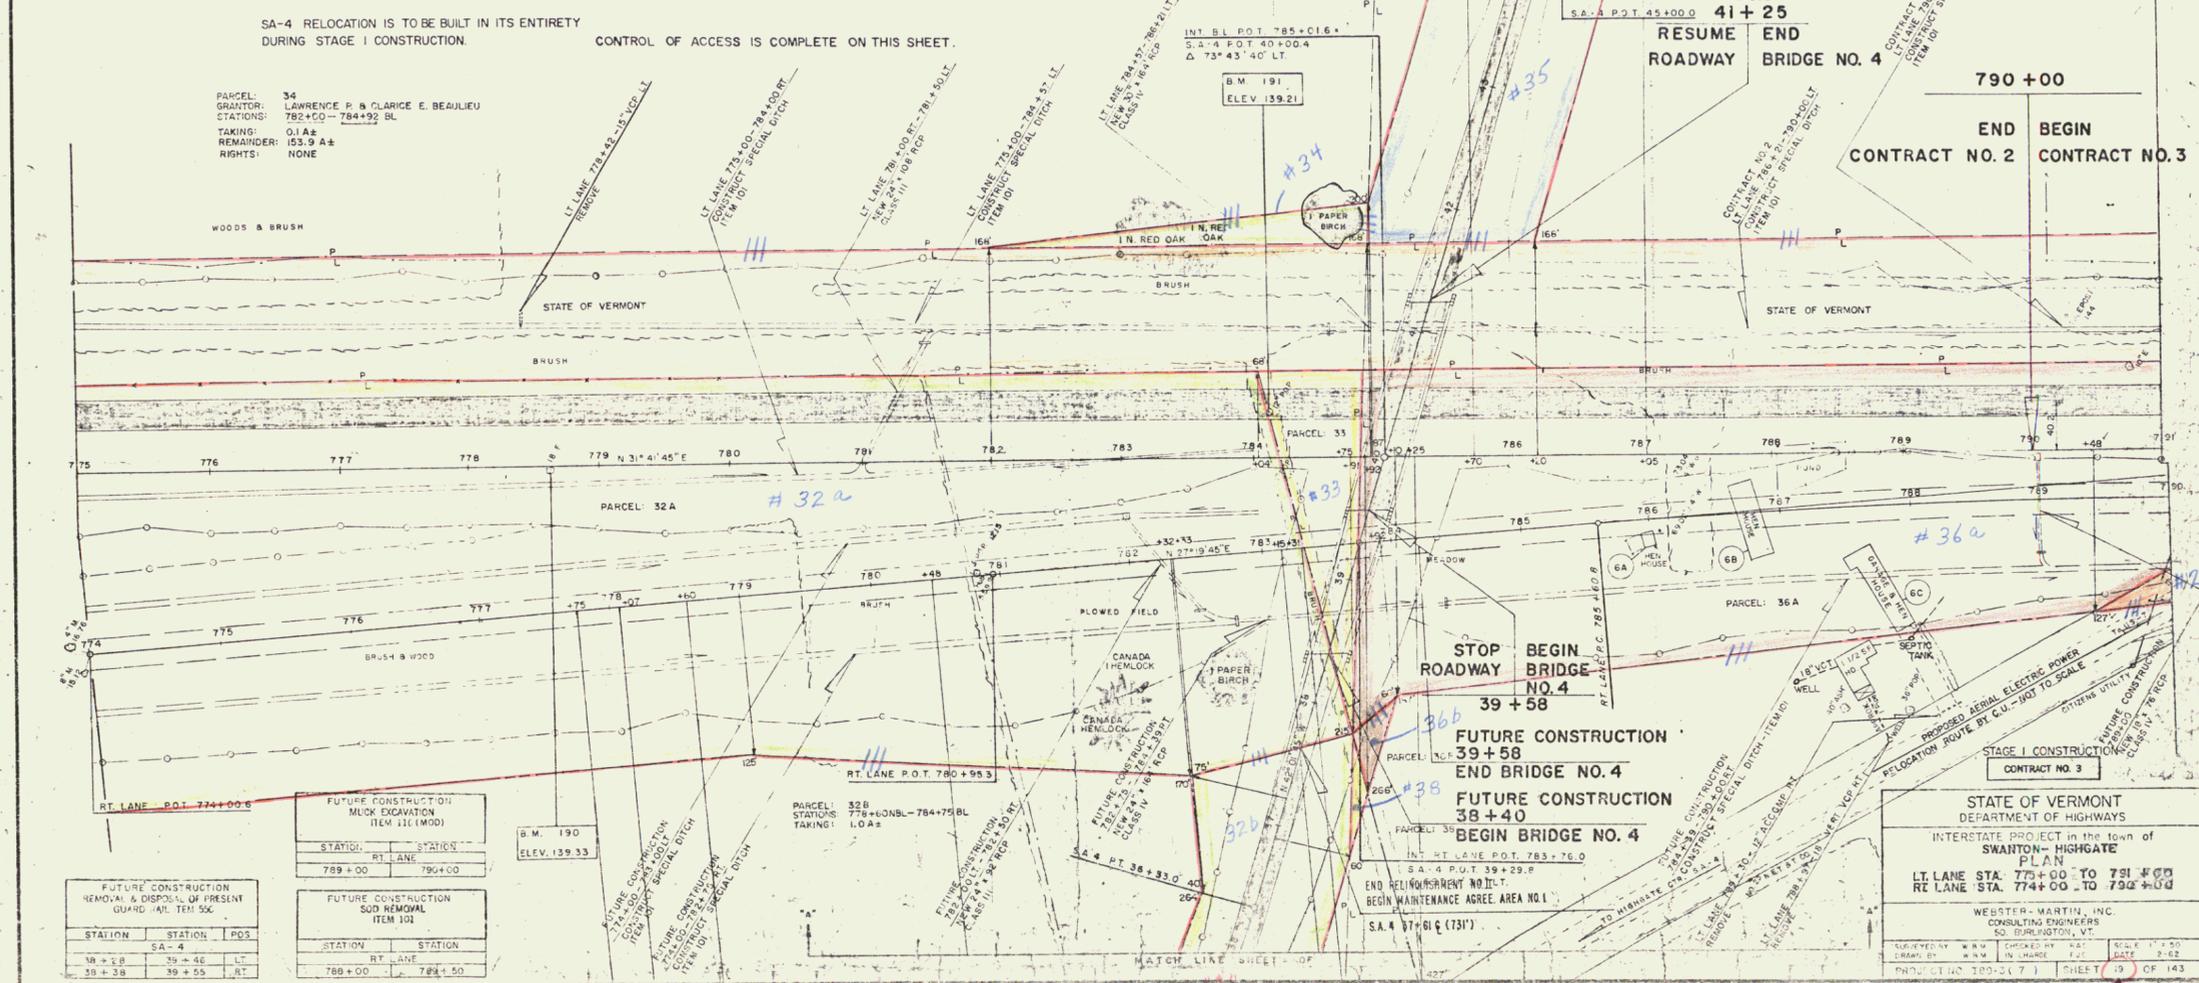

Const JAN 21 1980 23