


7+41
 0.000
 0.000
 0.000

PARCEL 38
 GRANTOR THE TRUSTEES OF THE DIOCESE OF VERMONT, LESSOR
 EUGENE E. BAILEY & FRANCES PELKY, LESSEE
 620 SQ. FT. ± REM. 0.15 ±
 COND 8/2/62
 HIGHGATE BK 54 PG 35-62 DT 11/16/62

PARCEL 36 A, B STA 784+75 - 793+86 BL ±
 GRANTOR THE TRUSTEES OF THE DIOCESE OF VERMONT, LESSOR
 OTIS A. & LORETTA H. LACEY, LESSEE
 3.7 A ± REM. 1.6 A ±
 RIGHTS NONE
 TITLE TAKEN COND 8/2/62
 RECORDED HIGHGATE BK 54 PG 35-62 DT 11/16/62


PARCEL 36 A
 STA 784+75 - 793+86 BL ±
 3.7 A ± REM. 1.6 A ±

PARCEL 36 B
 STA 784+75 - 785+10 BL ±
 1000 SQ. FT. ±

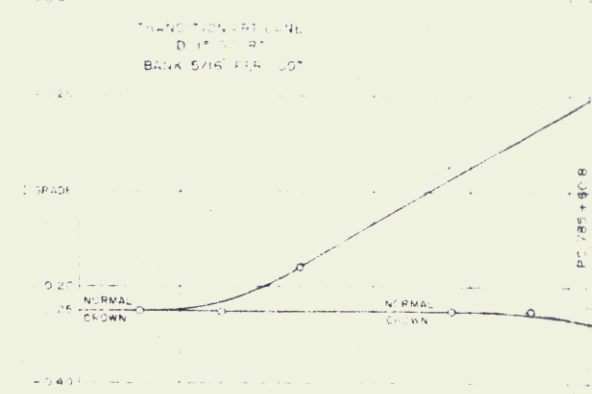

STAGE 2 FINISHED GRADES SHOWN
 STAGE 1 SUBGRADE ELEVATION 2.67 FEET (2 FT 9 IN) BELOW
 ACCESS ROAD IS TO BE BUILT IN ITS ENTIRETY DURING STAGE 1 CONSTRUCTION (LT. LANE)

RT. LANE
 790+00
 END BEGIN
 PROJECT 189-3(32) PROJECT 189-3(33)
 (LT. LANE STAGE 1 CONST.)
 790+20 (RT. LANE)
 CONSTRUCT BEGIN
 SATISFACTORY APPROACH ACCESS ROAD

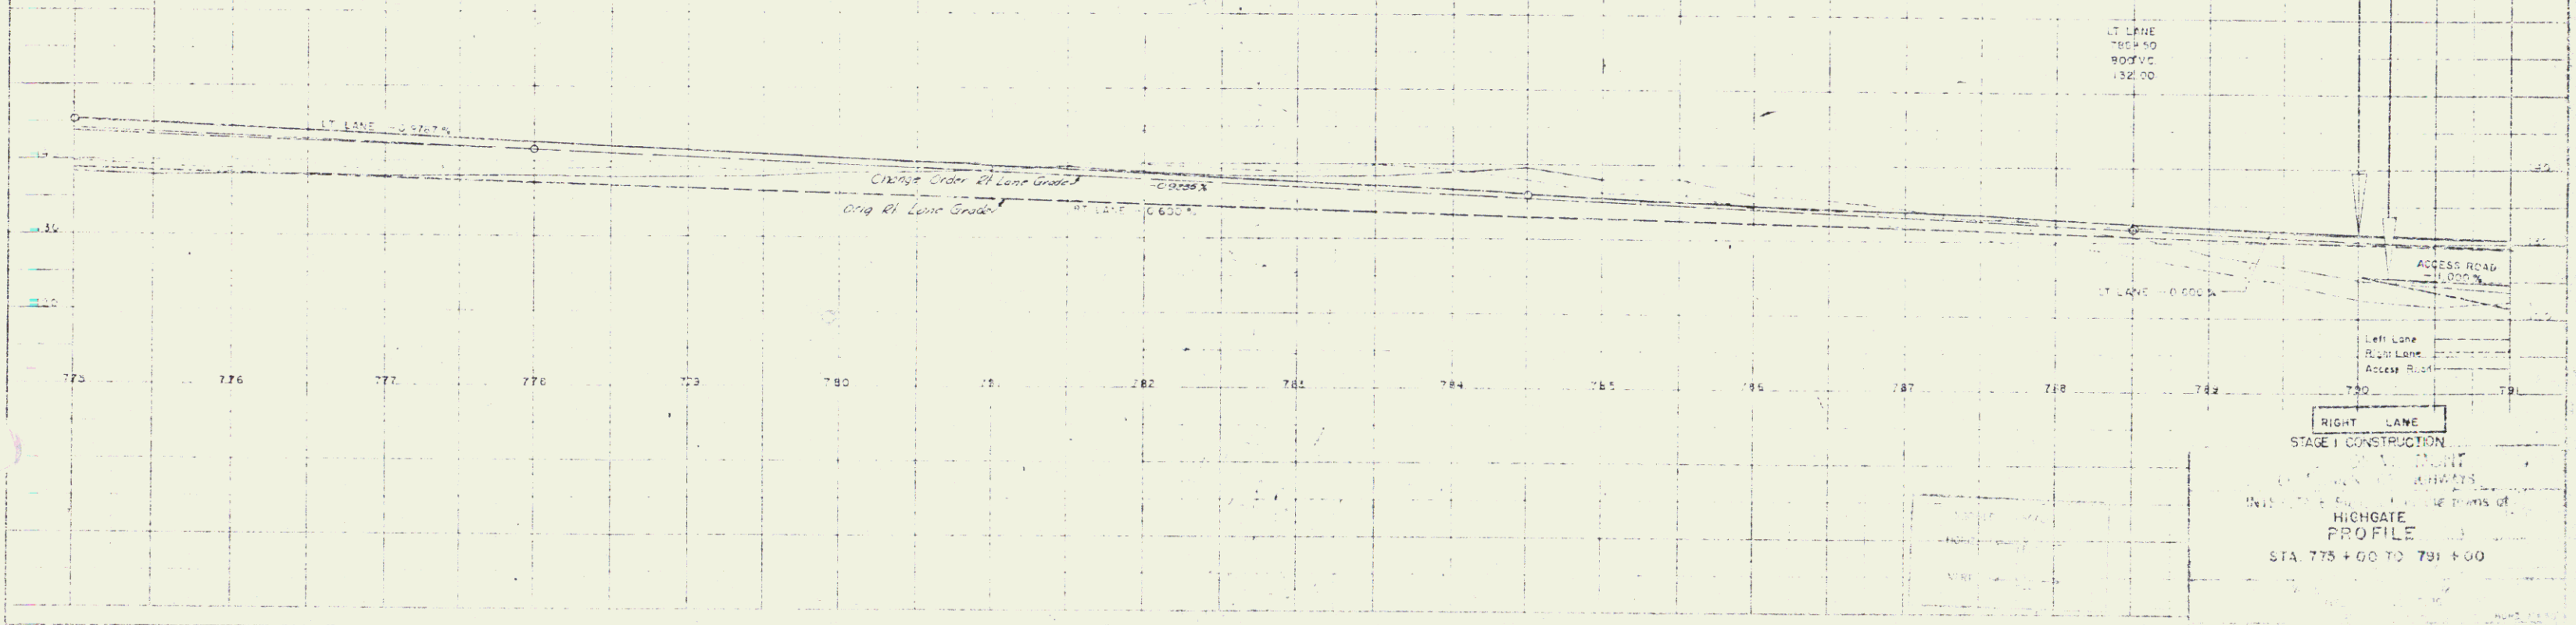

189-3(33) ROW 26