

**INDEX OF SHEETS**


1-1	TITLE SHEET	75	D-1	CUTTERS & JOIST LAYING
2-4	ALIGNMENT DATA SHEETS	76	D-4	ELLIPSE & FLUSHING BASINS
3-3	TYPICAL SECTIONS (MAINLINE)	77	BLANK	
4-7	TYPICAL SECTIONS (RAMP & FRONTAGE RD.)	78	D-8	DROP INLETS
5-3	QUANTITY SHEETS (ITEM)	79	D-10	DROP INLET TOWNS
10-11	DRAINAGE SHEETS	80	U-11	DETAILS OF GATES & COVER
12-15	GRADE SHEETS	81	D-15	CORR. D.I. GATES
16-22	EARTHWORK SHEETS	82	E-1	RAMP, GATES, SIGNS & LIGHTS
23	BLANK	83	BLANK	
24-26	BLANK	84	BLANK	
27-45	PLAN AND PROFILE SHEETS	85	D-31	CONSTRUCTION IDENTIFICATION SIGNS
46	BLANK	86	F-1	PROPERTY LINE FENCE
47	BLANK	87	SLANK	
53-51	DETAIL OF ENTRANCE AND EXIT TERMINALS, INTERSECTIONS	88	J-1	PROJECT & BOUNDARY MARKERS
52	BLANK	89	BLANK	
53	A-61	90	BLANK	
54	D-1	91	SCB-80-82	
55	R-1	92 A-1	SCB-D1	FRONT 09-82 (9 SHEETS)
56	R-5	93 A-2	SCWQ-30-62	SHEETS 1, 4
57	R-6	94 A-3	SB-50-62	SHEETS 1, 2
58	BLANK	95	BLANK	
59	BLANK	96	BLANK	
60	BLANK	97	BLANK	
70	BLANK	98	BR 100	SERIES (1 SHEET)
71	R-15	99	BR 200	SERIES (1 SHEET)
72	FLANK	100-102A	BR 300	SERIES (4 SHEETS)
73	B-17	101-103	CROSS SECTIONS	MAINLINE
74	C-2	104-105	CROSS SECTIONS	RAMP
75	C-2	106-107	CROSS SECTIONS	FRONTAGE ROAD

**STATE OF VERMONT  
DEPARTMENT OF HIGHWAYS**

**Proposed Improvement**

INTERSTATE PROJECT

**TOWN OF HIGHGATE  
COUNTY OF FRANKLIN  
INTERSTATE ROUTE 89  
ST. ALBANS, VT. - PHILIPSBURG, QUE. ROAD  
RT. LANE CONSTRUCTION**

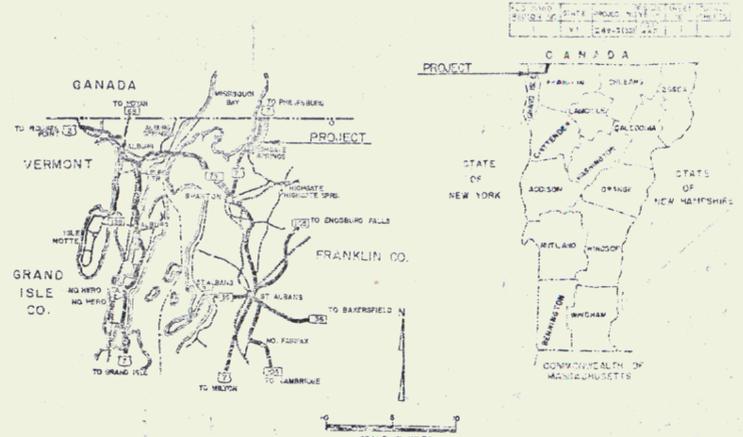

BEGINNING AT A POINT 2.912 MILES NORTHERLY OF THE SWANTON-HIGHGATE TOWN LINE AND EXTENDING NORTHERLY 2.971 MILES


LENGTH OF ROADWAY 15,391.88 FEET = 2.915 MI.  
LENGTH OF BRIDGE 294.12 FEET = 0.055 MI.  
LENGTH OF PROJECT 15,686.00 FEET = 2.971 MI.

**PROJECT NAME & NUMBER STAGE I  
HIGHGATE 189-3(33) GRADING & DRAINAGE  
RECORD PLANS  
MATERIALS**

SUBBASE OF SAND - CALEDONIA PIT NO 2 - SWANTON, VT.  
SUBBASE OF CRUSHED ROCK - LAFRANCE QUARRY - HIGHGATE, VT.  
CONCRETE CLASS 3000 - A.G. ANDERSON - SWANTON, VT. & ST. CRISWOLD - ST. ALBANS, VT.  
REINFORCING STEEL - BETHLEHEM STEEL CORP. - CAMBRIDGE, MASS.  
STRUCTURAL STEEL, BRIDGE RAILING & STEEL PILING - VT. STRUCTURAL STEEL CO. - BURLINGTON, VT.  
METAL CULVERT PIPES & COVERS FOR P.S. - NEW ENGLAND MET. CULV. CO. - WHITE RIVER JCT., VT.  
REINFORCING CONCRETE CURB, GUARD RAIL ITEMS & PROPERTY LINE FENCE & EROSION CONTROL ITEMS - S. T. CRISWOLD & CO., INC. - WILLISTON, VT.  
BRIDGE PAINT - MASTER BRONZE POWDER CO. - CHICAGO HEIGHTS, ILL.  
RUBBER JOINT MATERIAL - PRODUCTS RESEARCH & CHEMICAL CO. - CLUSTER CITY, N. J.  
ASPHALTIC ASBESTOS COATING - A.H. HARRIS & SONS, INC. - HYDE PARK, MASS.

CONTRACTORS - CALEDONIA SAND & GRAVEL CO., INC. & BECK & BELLUCCI - ST. JOHNSBURY, VT.  
RESIDENT ENGINEER - HERBERT V. WAGNER.  
INSPECTOR - WILLIAM DOYLE.  
RECORD PLANS - ALEXANDER G. SPIDLE.

CONTRACT DATED - MAY 4, 1964.  
STARTED - MAY 9, 1964.  
COMPLETED - OCTOBER 14, 1966.  
ACCEPTED - OCTOBER 14, 1966.

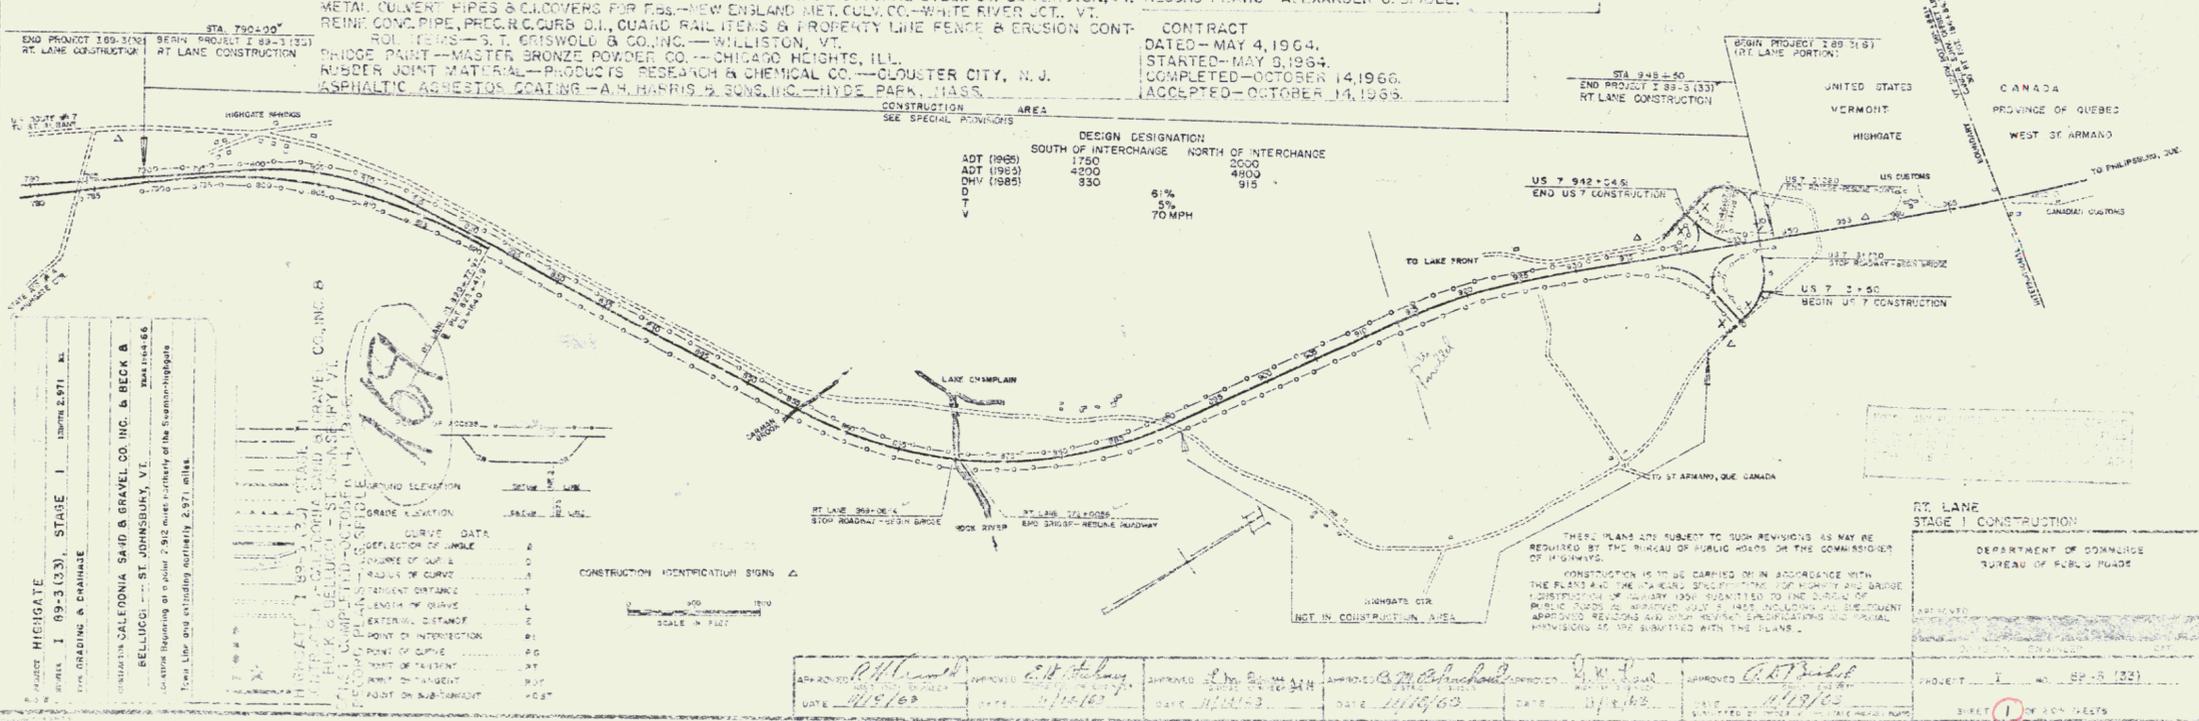

APPROVED [Signature] DATE 4/19/68

APPROVED [Signature] DATE 4/14/68

APPROVED [Signature] DATE 4/14/68

APPROVED [Signature] DATE 4/14/68

APPROVED [Signature] DATE 4/14/68

APPROVED [Signature] DATE 4/19/68

Construction/row Plans 29