

SOD REMOVAL ITEM 101	
STATION	STATION
814 + 00	817 + 00
815 + 50	812 + 00

THREE CABLE GUARD RAIL WITH STEEL POSTS ITEM 543		
STATION	STATION	POS.
823 + 00	830 + 00	LT LANE
+24 + 00	834 + 00	RT LANE


THREE CABLE GUARD RAIL WITH STEEL POSTS ITEM 543		
STATION	STATION	POS.
823 + 00	830 + 00	LT LANE
+24 + 00	834 + 00	RT LANE

* THESE ITEMS ARE STAGE 2 CONSTRUCTION

PARCEL	45 A	STA	817+38L - 819+22
GRANTOR	THE TYLER PLACE, INC		
TRNSFR	817+38L - 819+22	RT	10' 9" 4"
RIGHT	SPRING - STA 807+90E		
FILE NUMBER	ROW - STA 807+10 - 808+10 RT		
RECORDED	BOOK 14	PAGE 16	DATE 07/27/62

3293
R.O.C. Control (5.0)

45 A	817+38L - 819+22
817+38L - 819+22	RT
817+38L - 819+22	RT

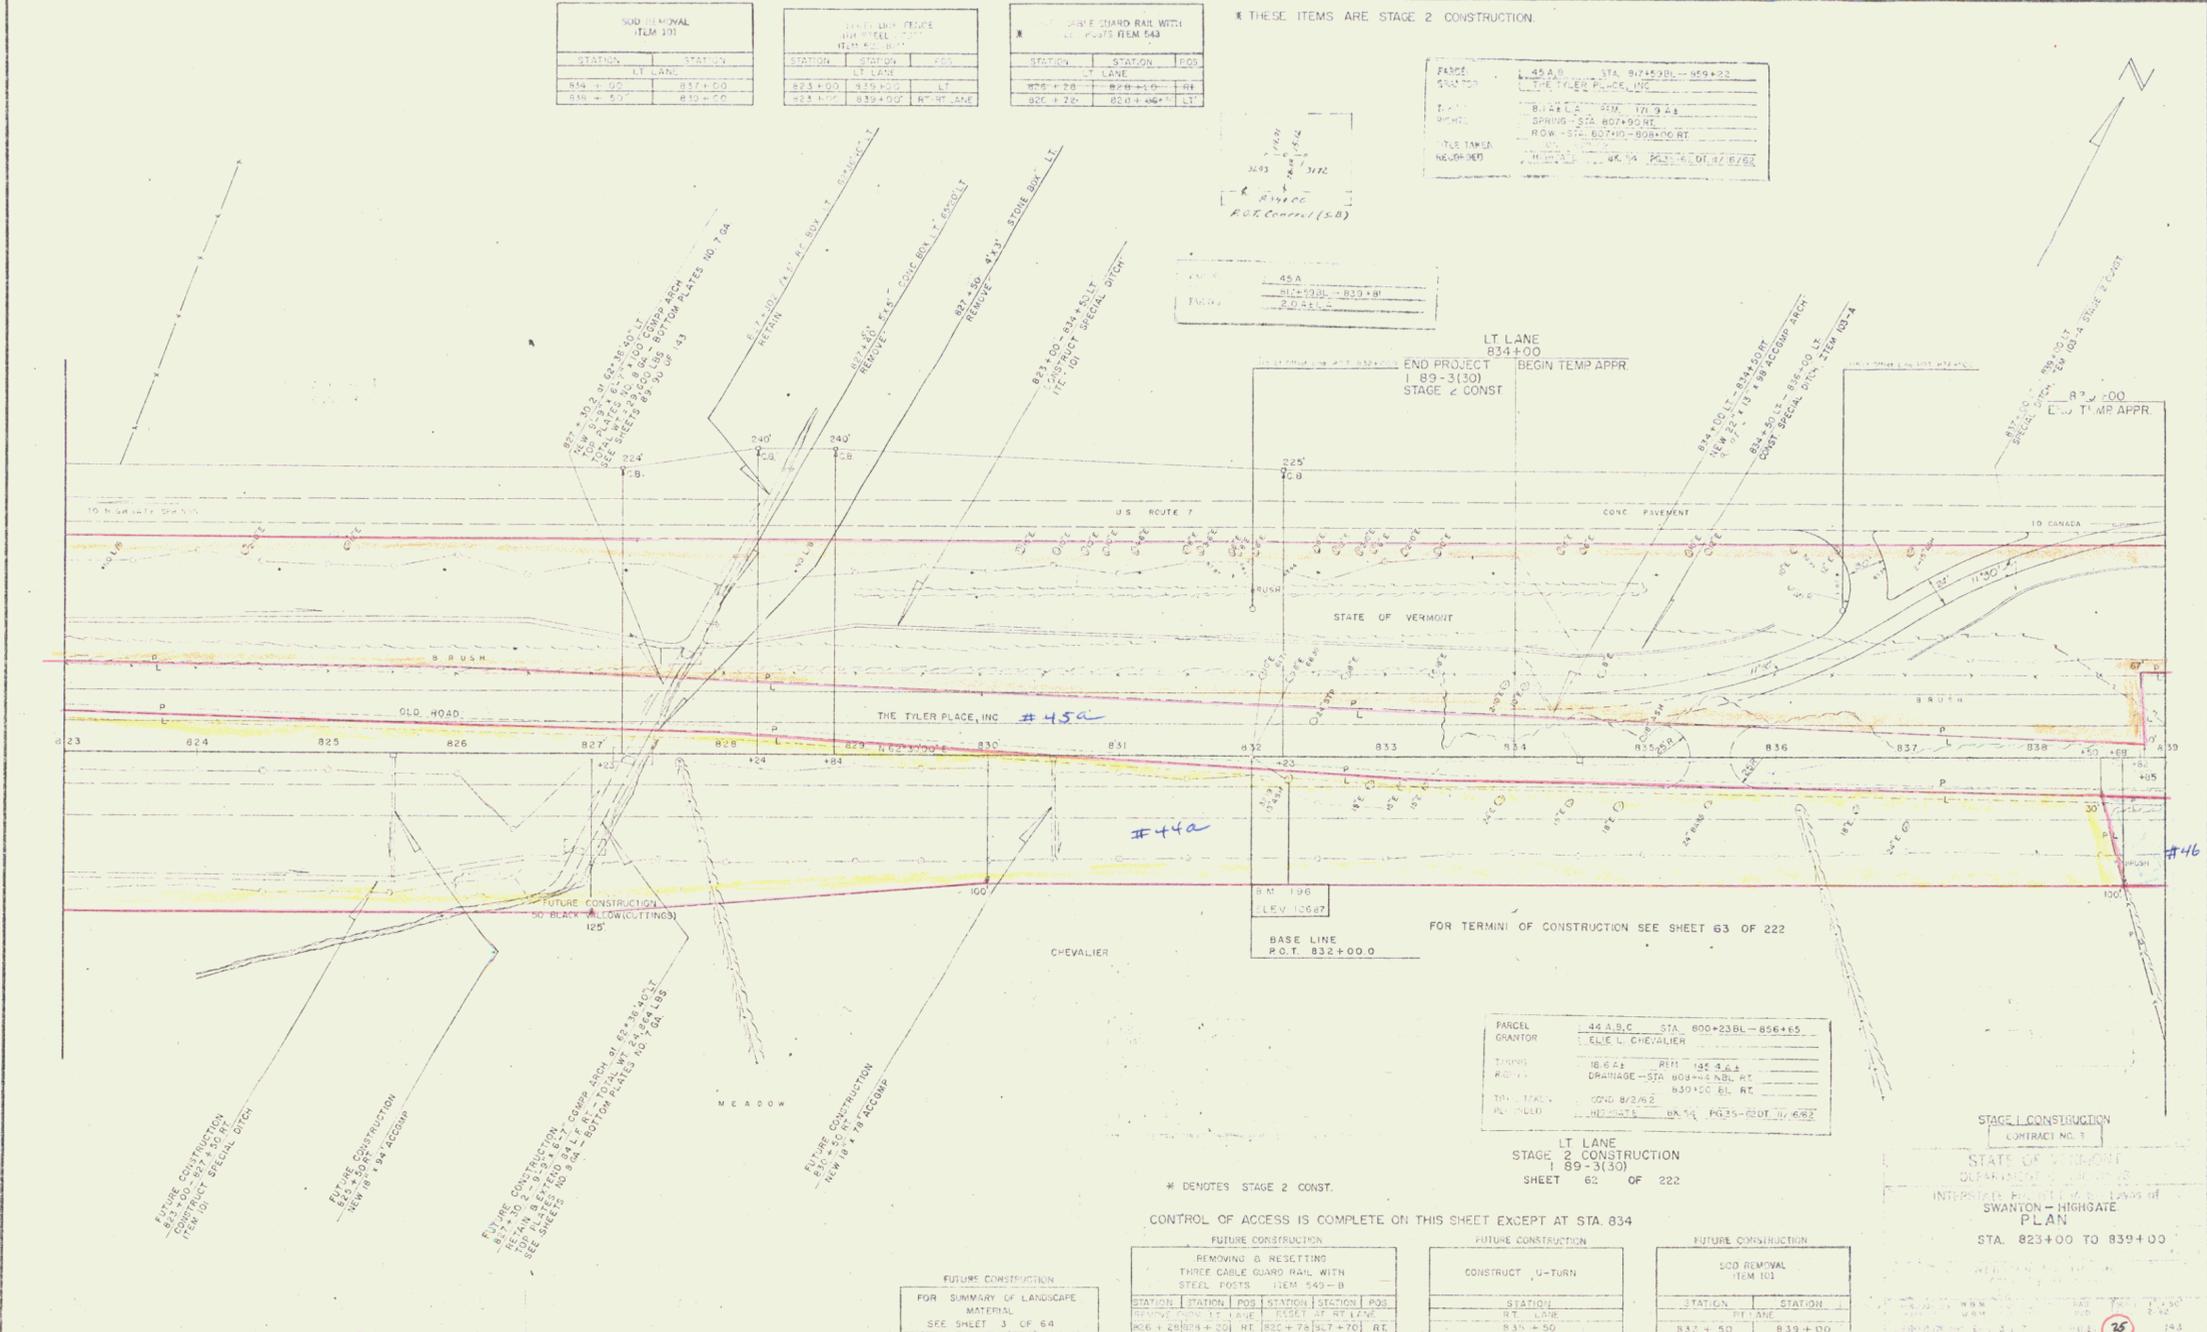

LT LANE
834+00
END PROJECT
1 89-3(30)
STAGE 2 CONST
BEGIN TEMP APPR

PARCEL	44 A,B,C	STA	800+23BL - 806+65
GRANTOR	ELLE L CHEVALIER		
TRNSFR	18.6 21	RT	134 4 1/4"
RIGHT	DRAINAGE - STA 808+45 ABL RT		
FILE NUMBER	ROW - STA 830+00 BL RT		
RECORDED	BOOK 14	PAGE 16	DATE 07/27/62

LT LANE
STAGE 2 CONSTRUCTION
1 89-3(30)
SHEET 62 OF 222

* DENOTES STAGE 2 CONST.

CONTROL OF ACCESS IS COMPLETE ON THIS SHEET EXCEPT AT STA. 834

FUTURE CONSTRUCTION			
FOR SUMMARY OF LANDSCAPE MATERIAL SEE SHEET 3 OF 64			

FUTURE CONSTRUCTION			
REMOVING & RESETTING THREE CABLE GUARD RAIL WITH STEEL POSTS ITEM 543-B			
STATION	STATION	STATION	POS.
823+00	830+00	834+00	RT LANE
823+00	830+00	834+00	RT

FUTURE CONSTRUCTION	
CONSTRUCT U-TURN	
STATION	STATION
834+00	835+50

FUTURE CONSTRUCTION	
SOD REMOVAL ITEM 101	
STATION	STATION
837+50	839+00

STAGE 1 CONSTRUCTION
CONTRACT NO. 1
STATE OF VERMONT
DEPARTMENT OF TRANSPORTATION
INTERSTATE ROUTE 7 & 8 LANS OF SWANTON-HIGHGATE PLAN
STA. 823+00 TO 839+00