


THREE CABLE (D 42) WITH STEEL POSTS ITEM 54		
STATION	STATION	POS.
868+20	868+50	LT
868+20	868+50	RT

V. R. FILL (MOD) REF. TYPICAL SECTION - SHEET 3 OF 143		
STATION	STATION	POS.
868+00	869+00	RT

FILLS TO BE MADE OF GRANULAR MATERIALS * THESE ITEMS ARE STAGE 2 CONSTRUCTION		
STATION	STATION	POS.
855+00	871+00	LT
855+00	871+00	RT

STANDARD STEEL BEAM GUARD RAIL WITH STEEL POSTS ITEM 547-A		
STATION	STATION	POS.
864+50	865+20	RT

STANDARD STEEL BEAM GUARD RAIL WITH STEEL POSTS ITEM 547-A		
STATION	STATION	POS.
864+50	865+20	RT

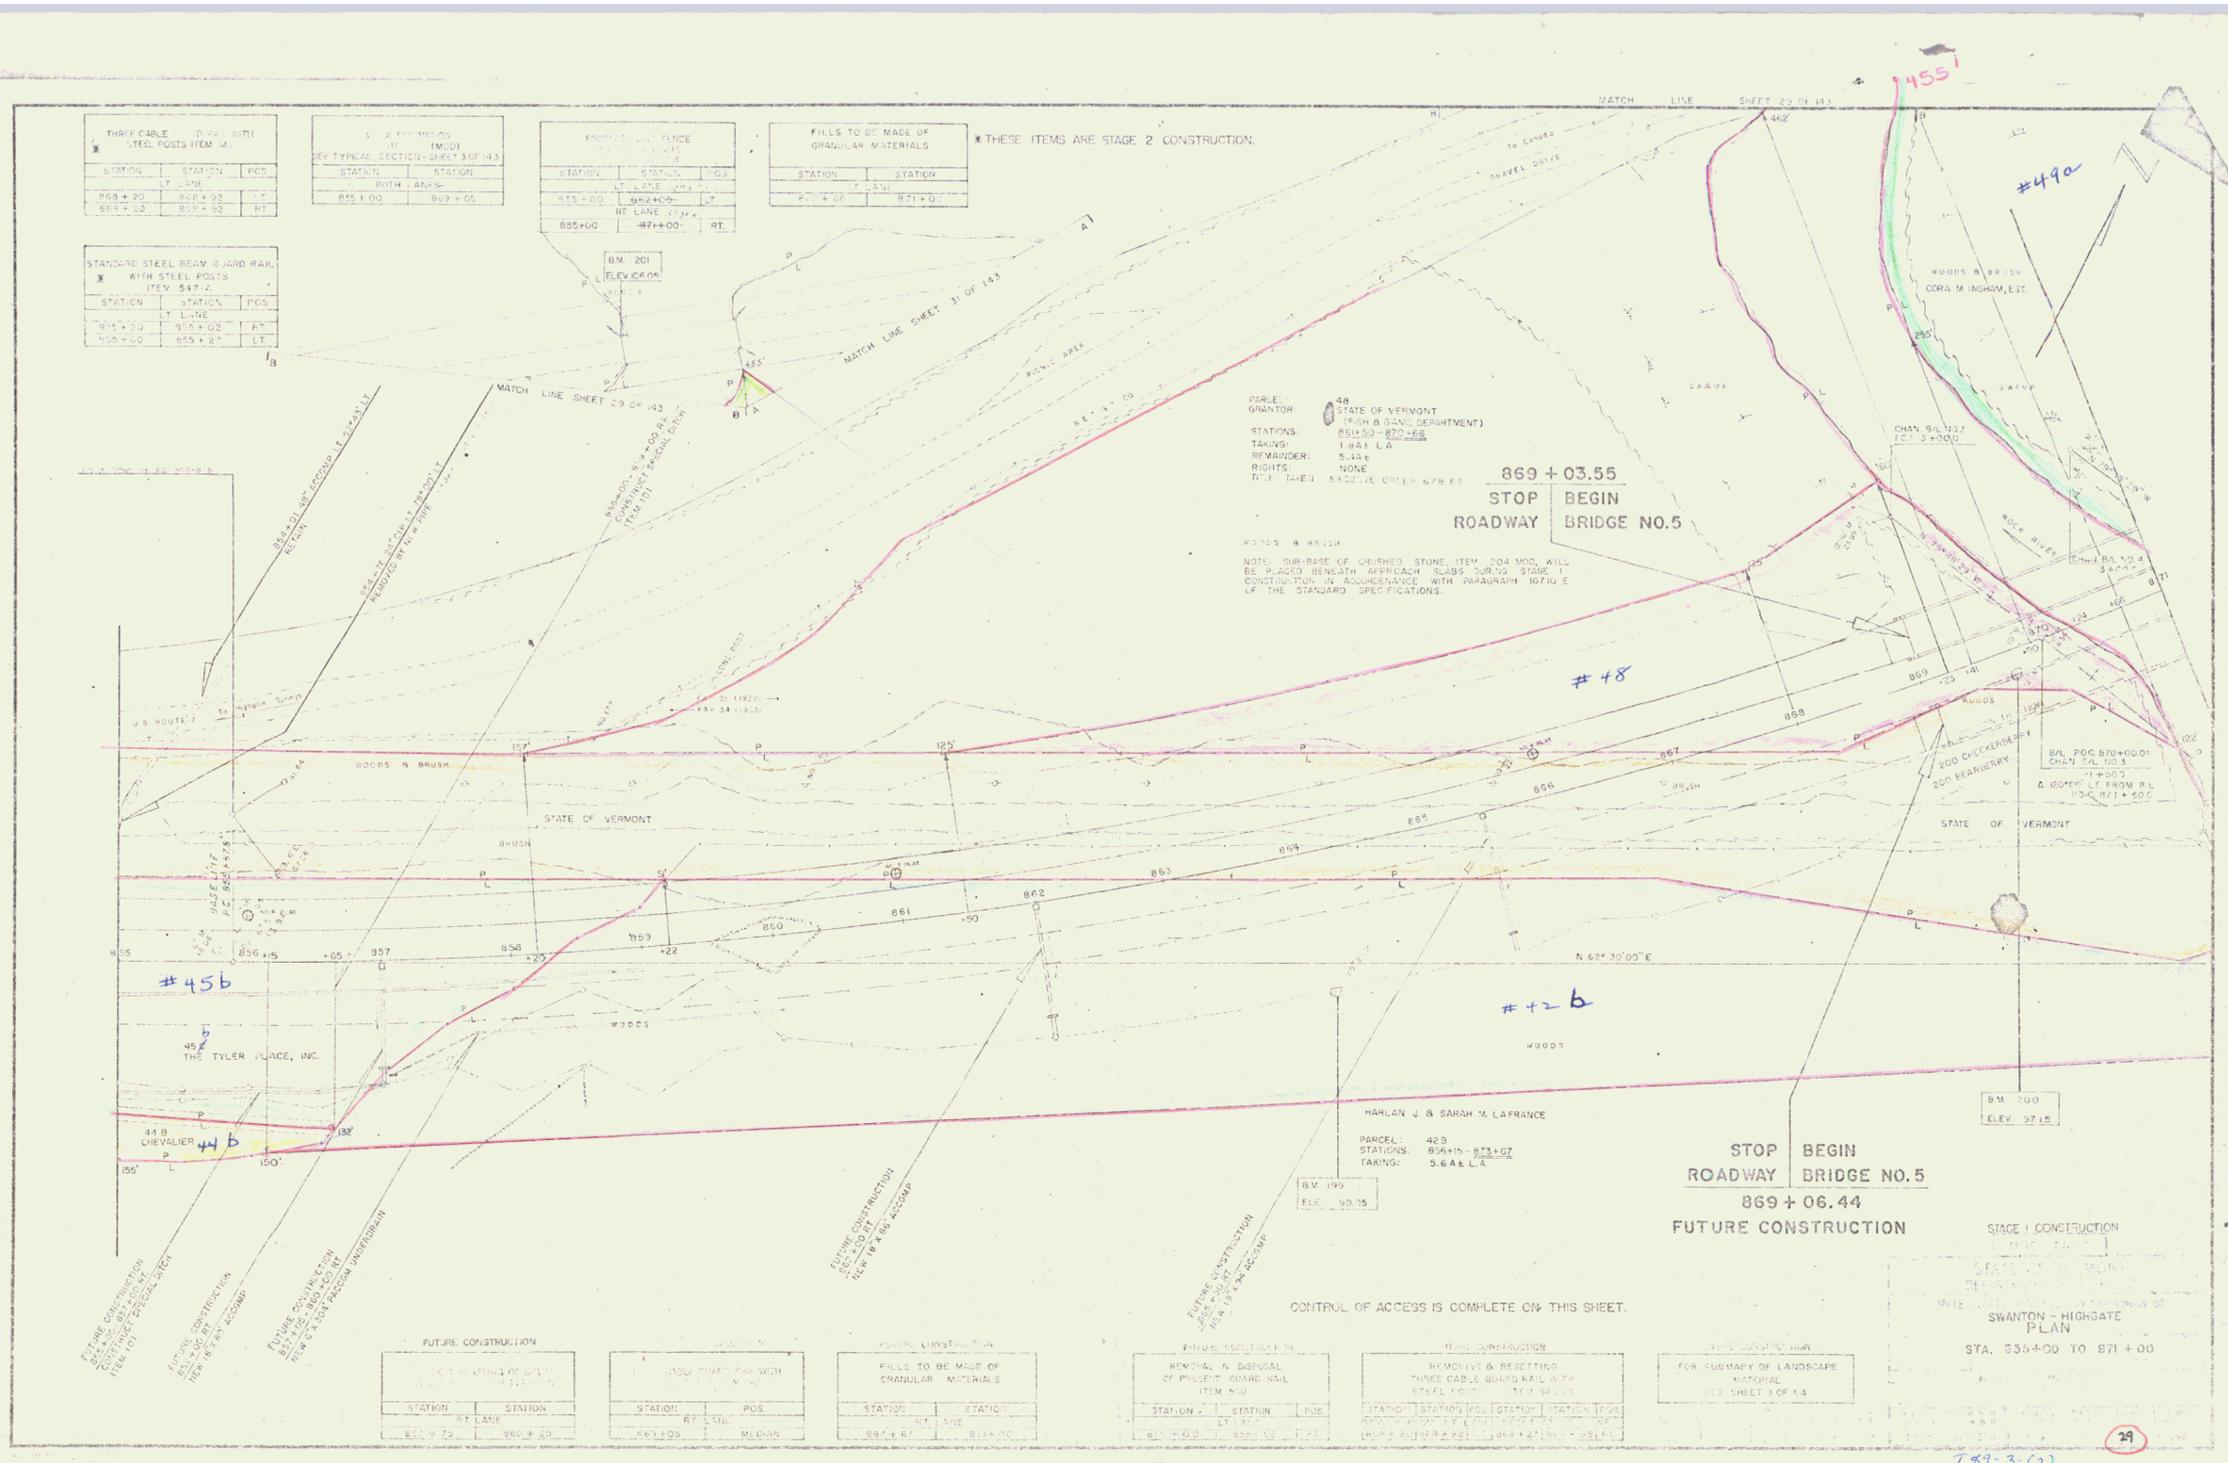

PARCEL GRANTOR: STATE OF VERMONT (FRESH B. GRANITE DEPARTMENT)
 STATIONS: 851+50 - 870+68
 TAKING: 1.84 & L.A.
 REMAINDER: NONE
 RIGHTS: NONE
 DATE TAKEN: EXCLUSIVE ORDER 67862

NOTES & BRUSH
 NOTE: SUB-BASE OF CRUSHED STONE, ITEM 204 MOD, WILL BE PLACED BENEATH APPROACH SLABS DURING STAGE 1 CONSTRUCTION IN ACCORDANCE WITH PARAGRAPH 10710.2 OF THE STANDARD SPECIFICATIONS.

PARCEL: 42B
 STATIONS: 856+15 - 873+07
 TAKING: 5.6 A & L.A.
 ELEV. 90.75

FUTURE CONSTRUCTION		
STATION	STATION	POS.
867+20	868+20	RT LANE

FUTURE CONSTRUCTION		
STATION	STATION	POS.
867+00	867+00	MEDIAN

FILLS TO BE MADE OF GRANULAR MATERIALS		
STATION	STATION	POS.
867+00	871+00	RT LANE

REMOVAL & DISPOSAL OF PRESENT GUARD RAIL ITEM 540		
STATION	STATION	POS.
867+00	868+00	RT LANE

REMOVAL & RESETTING THREE CABLE GUARD RAIL WITH STEEL POSTS ITEM 547-A		
STATION	STATION	POS.
867+00	868+00	RT LANE

FOR SUMMARY OF LANDSCAPE MATERIAL SEE SHEET 3 OF 143		
--	--	--

STAGE 1 CONSTRUCTION
 STATE OF VERMONT
 SWANTON - HIGSGATE
 PLAN
 STA. 855+00 TO 871+00

I 89-3 (?)

33