

DRAINING & REVISIONS OF 5010	
STATION	STATION
892+50	901+25

MUCK EXCAVATION	
STATION	STATION
902+00	903+00

PROPERTY LINE FENCE WITH STEEL POSTS ITEM 111 (WOOD)		
STATION	STATION	LOCATION
892+50	892+50	LT
892+50	894+50	RT-RT LANE
894+50	894+50	LT
898+00	892+00	RT-RT LANE

*** LANDSCAPE MATERIALS**
Project I 89-3(6)
FRONTAGE ROAD (REST AREA)
STA. 951+00 - 955+00

TYPE	NUMBER
N. Red Oak	7
Shadbrush	10
Siberian Pea Tree	3
Red Osier Dogwood	110
Total	130


MAINLINE	
Red Pine	2
Norway Spruce	9
Red Maple	2
Red Oak	8
Winged Euonymus	5
Pink Tatarian Honeysuckle	10
Am. Cranberry Bush	15
Baccharis	1000
Total	1051

*** GENERAL NOTES**

A. SIZE OF MATERIAL
1. Evergreen trees should be 2 1/2 - 3 1/2 feet in height and must have dormant buds and secondary needles.
2. Large deciduous trees should be 3/4 to one inch in caliper with a minimum height of 6 to 8 feet.
3. Deciduous shrubs should be 2 to 3 feet in height, with not less than 4 canes, two feet and up.

B. PLANTING INSTRUCTIONS
1. Am. Cranberry Bush, Pink Tatarian Honeysuckle and Winged Euonymus should be planted 4 feet by 4 feet.
2. Norway Spruce should be planted 15 feet apart.
3. Baccharis should be planted 2 feet by 2 feet.
4. Red Osier Dogwood should be planted 3 feet apart in a single row.

C. ALL PLANT MATERIAL TO BE GRADED ACCORDING TO AM. STANDARDS FOR NURSERY STOCK.

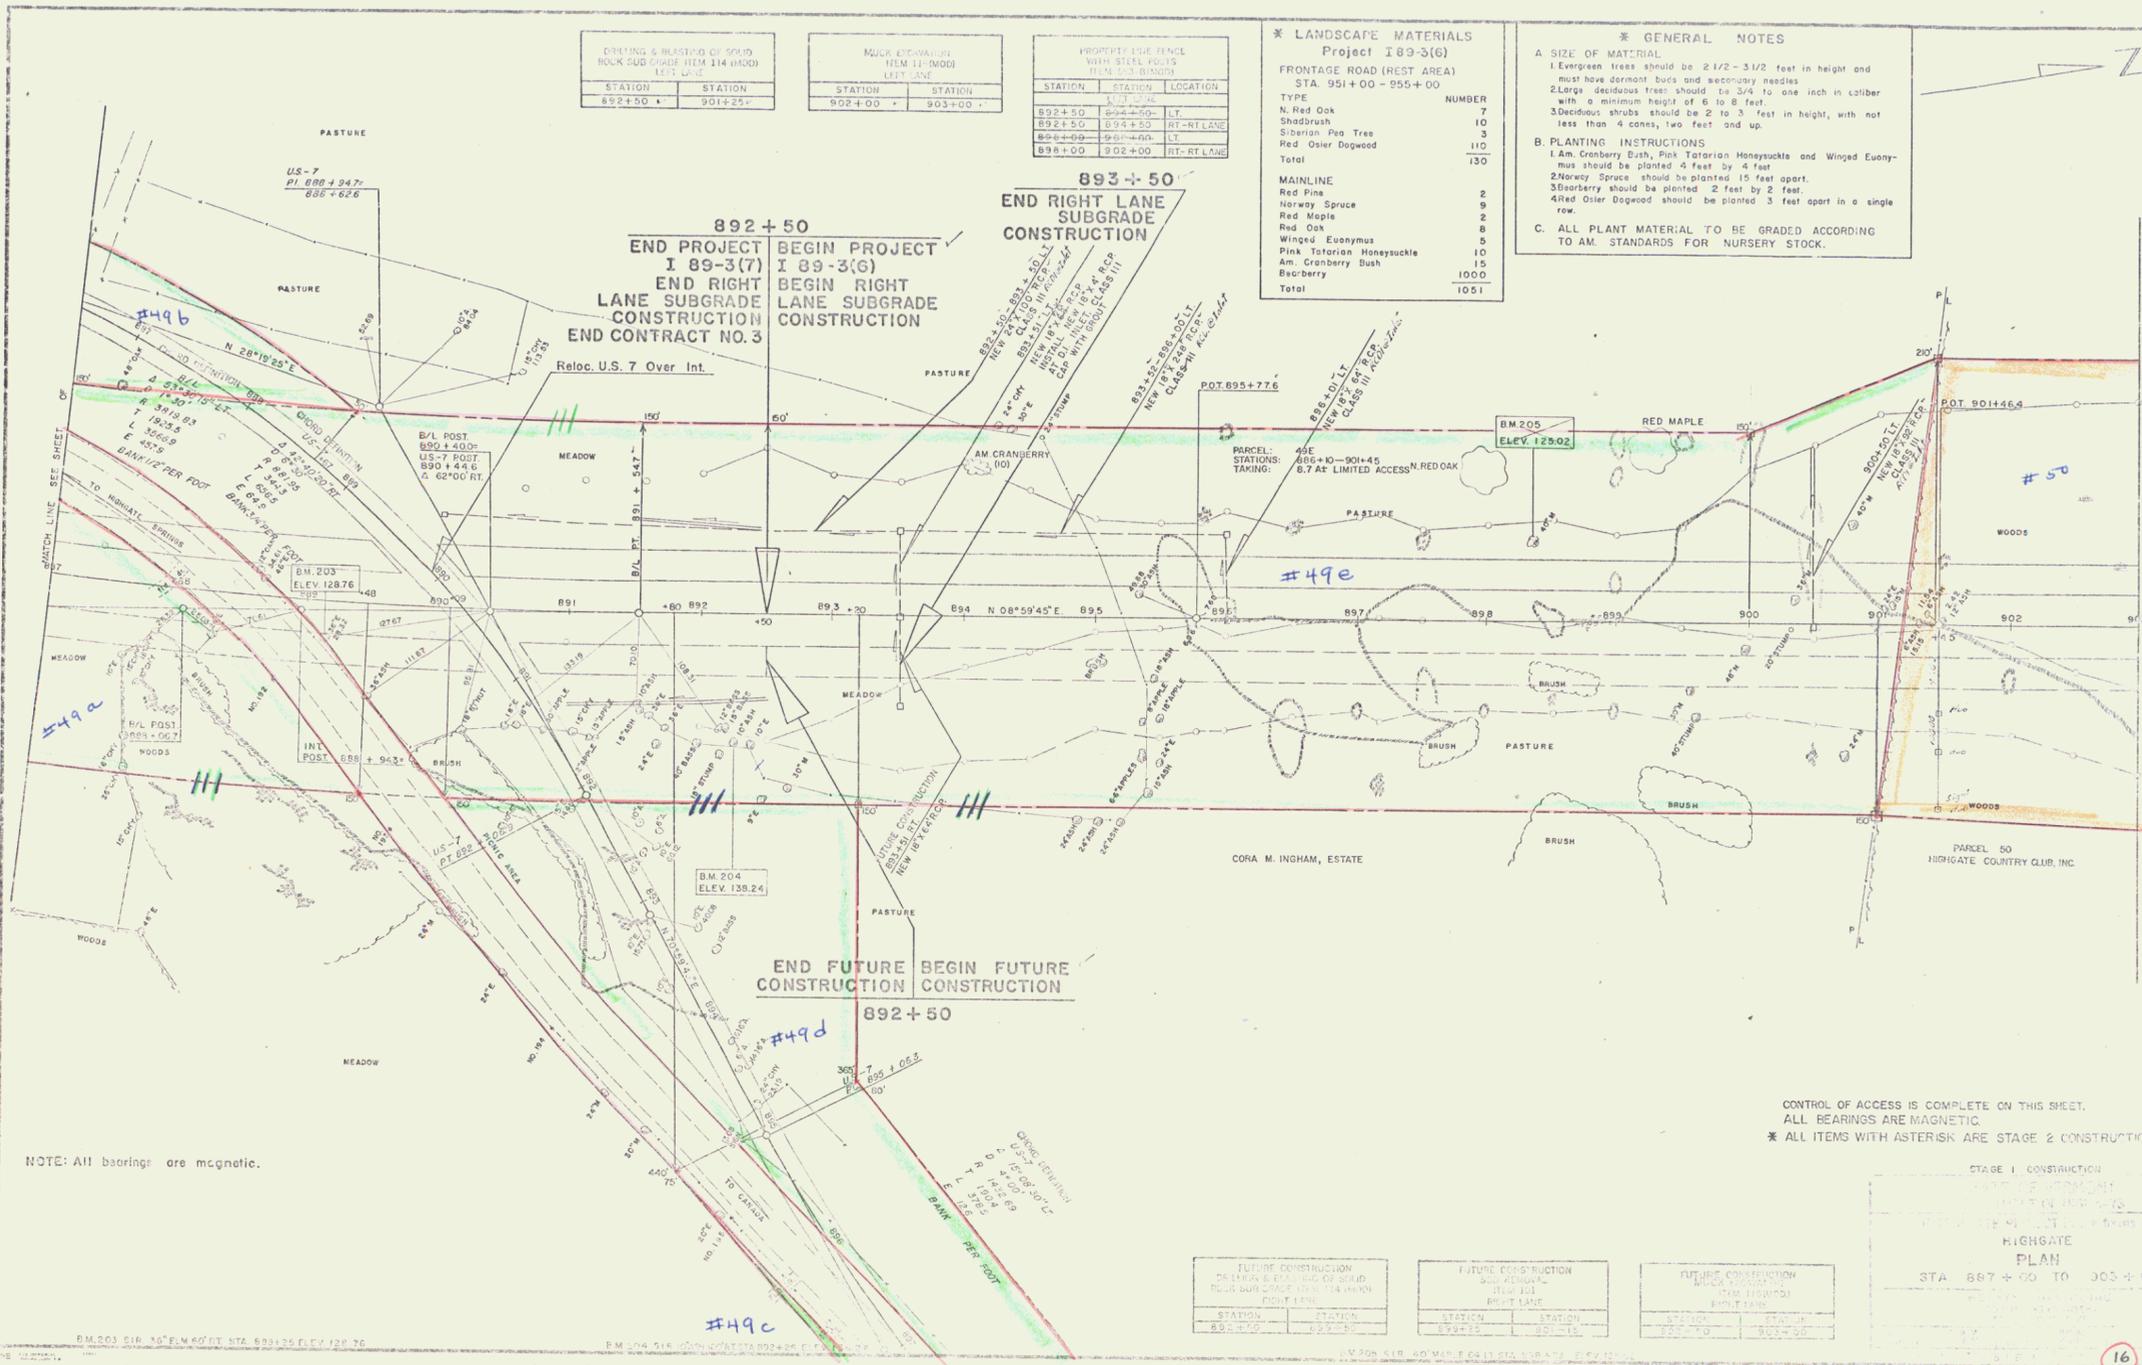

NOTE: All bearings are magnetic.

CONTROL OF ACCESS IS COMPLETE ON THIS SHEET.
ALL BEARINGS ARE MAGNETIC.
* ALL ITEMS WITH ASTERISK ARE STAGE 2 CONSTRUCTION

FUTURE CONSTRUCTION		FUTURE CONSTRUCTION		FUTURE CONSTRUCTION	
STATION	STATION	STATION	STATION	STATION	STATION
892+50	892+50	892+50	892+50	892+50	892+50

STAGE 1 CONSTRUCTION
FRONTAGE ROAD (REST AREA)
STA. 951+00 TO 955+00
HIGHGATE
PLAN
STA. 887+00 TO 905+00

16

35