

DRILLING & BLASTING OF SOLID ROCK SUB GRADE ITEM 114 (MCD)	
STATION	STATION
935+00	936+25
FRONTAGE ROAD	
935+00	936+25
946+25	947+60
953+00	


PROPERTY LINE FENCE WITH STEEL POSTS ITEM 583 (MCD)		
STATION	STATION	POS.
LEFT LANE		
935+00	951+00	LT
FRONTAGE ROAD		
935+00	951+00	RT-RTLANE

SOD REMOVAL ITEM 101			
STATION	STATION	LEFT LANE	RIGHT LANE
938+00	943+75		
FRONTAGE ROAD			
936+25	938+25		
938+80	946+00		
948+00	949+15		
949+60	953+00		
FRONTAGE ROAD (REST AREA)			
951+00	953+00		

GRANITE SLOPE EDGING ITEM 506-A			
STATION	STATION	POS.	LOCATION
LEFT LANE			
941+90	943+25	RT	MEDIAN
FRONTAGE ROAD			
941+90	943+00	LT	MEDIAN
948+25	951+00	LT	MEDIAN

NOTE:
FOR SUMMARY OF LANDSCAPE MATERIALS SEE SHEET 16 OF 100

CONSTRUCT 12' HOLDING LANE INCLUDING 175' TAPER			
STATION	STATION	POS.	LT
948+50	951+00	LT	250
949+25	951+00	RT	175

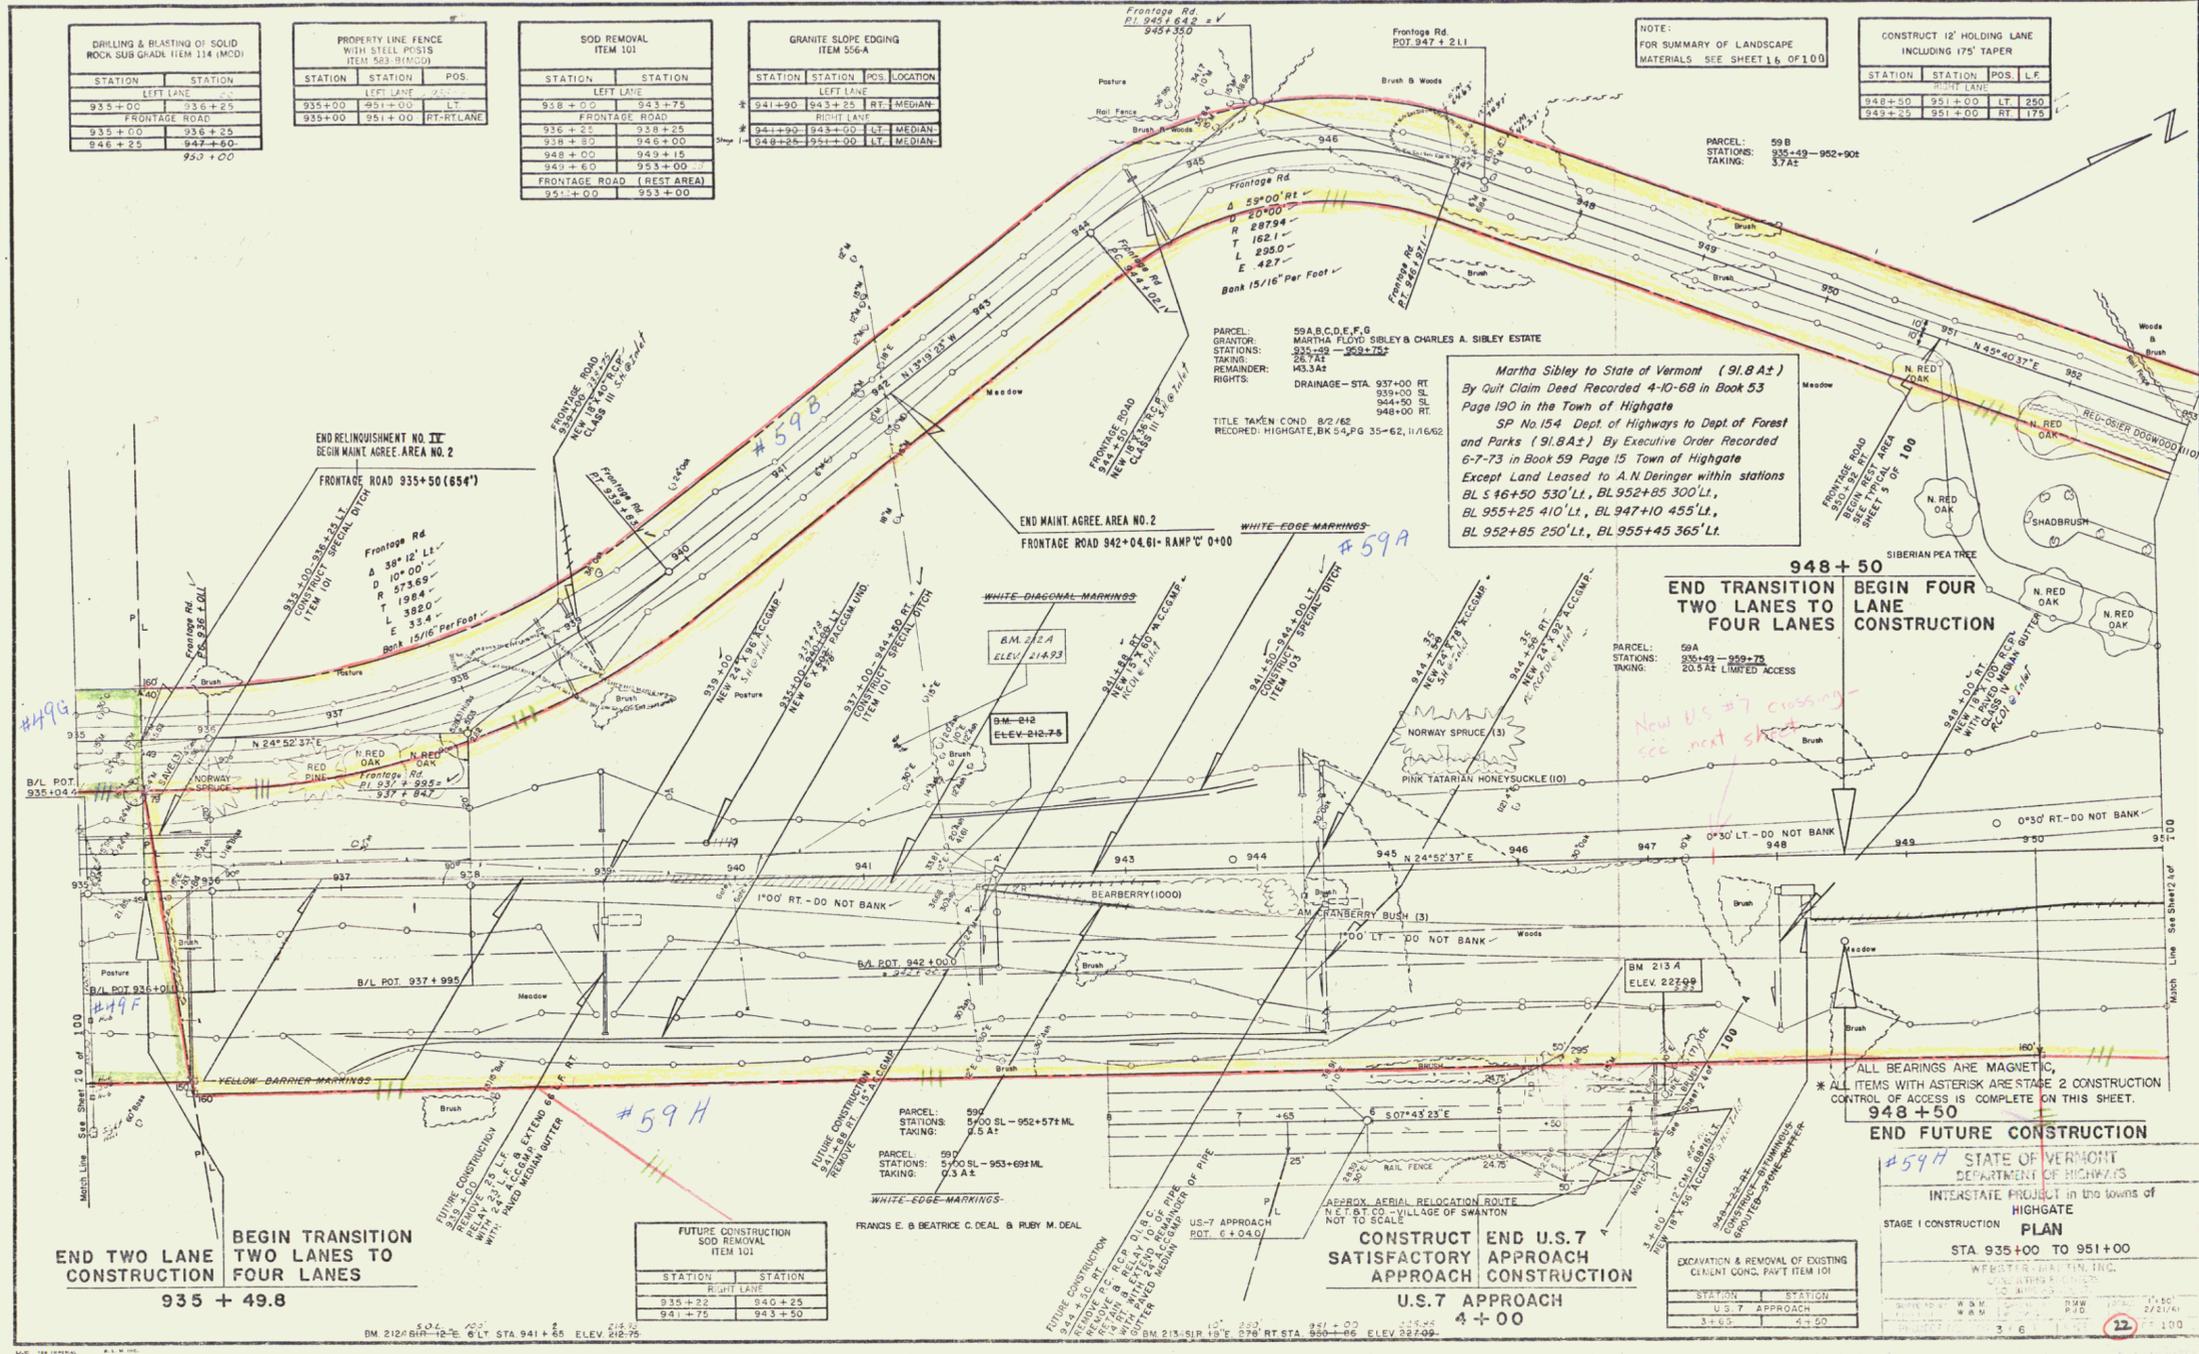

PARCEL: 59A B.C.D.E.F.G
GRANTOR: MARTHA FLOYD SIBLY & CHARLES A. SIBLY ESTATE
STATIONS: 935+00 - 952+75
TAKING: 37A
REMAINDER: 143.3A
RIGHTS: DRAINAGE - STA. 937+00 RT 939+00 SL 944+50 SL 948+00 RT

Martha Sibly to State of Vermont (91.8A±)
By Quit Claim Deed Recorded 4-10-68 in Book 53
Page 190 in the Town of Highgate
SP No 154 Dept. of Highways to Dept. of Forest and Parks (91.8A±) By Executive Order Recorded 6-7-73 in Book 59 Page 15 Town of Highgate
Except Land Leased to A.N. Deringer within stations
BL 935+50 530' Lt., BL 952+85 300' Lt.,
BL 955+25 410' Lt., BL 947+10 455' Lt.,
BL 952+85 250' Lt., BL 955+45 365' Lt.

948+50
END TRANSITION TWO LANES TO FOUR LANES
BEGIN FOUR LANE CONSTRUCTION

END TWO LANE CONSTRUCTION
BEGIN TRANSITION TWO LANES TO FOUR LANES
935 + 49.8

FUTURE CONSTRUCTION SOD REMOVAL ITEM 101			
STATION	STATION	RIGHT LANE	LEFT LANE
935+22	940+25		
941+75	943+50		

CONSTRUCT END U.S. 7 SATISFACTORY APPROACH CONSTRUCTION
U.S. 7 APPROACH 4+00

EXCAVATION & REMOVAL OF EXISTING CEMENT CONC. PAVT ITEM 101			
STATION	STATION	U.S. 7 APPROACH	U.S. 7 APPROACH
3+65	4+20		

ALL BEARINGS ARE MAGNETIC,
* ALL ITEMS WITH ASTERISK ARE STAGE 2 CONSTRUCTION
CONTROL OF ACCESS IS COMPLETE ON THIS SHEET.
948+50
END FUTURE CONSTRUCTION

STATE OF VERMONT
DEPARTMENT OF HIGHWAYS
INTERSTATE PROJECT in the towns of
HIGHGATE
STAGE 1 CONSTRUCTION
PLAN
STA 935+00 TO 951+00

40. JAN 21 1980