


STATION	STATION
938+00	938+00
938+00	938+00
938+00	938+00
938+00	938+00

STATION	STATION	POS
938+00	940+00	LT LANE
938+00	938+00	RT LANE
938+00	938+00	RT LANE
938+00	938+00	RT LANE

STATION	STATION
938+00	938+00
938+00	938+00
938+00	938+00
938+00	938+00

STATION	STATION	POS
938+00	938+00	RT LANE

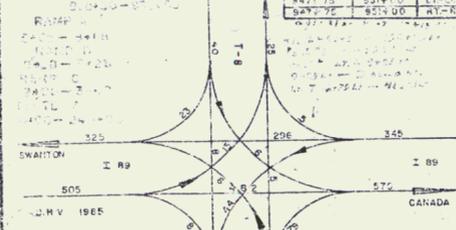

END TWO LANE TWO LANES TO CONSTRUCTION
 BEGIN TRANSITION TWO LANES TO FOUR LANES
 938 + 49.8

STATION	STATION
938+00	938+00
938+00	938+00
938+00	938+00
938+00	938+00

STATION	STATION
938+00	938+00
938+00	938+00
938+00	938+00
938+00	938+00

50 of 204
 41